

5 cm

217-249

**THOMPSON LODE**

— SCALE 25 FT. TO 1 INCH —

700' N

600' N

500' N

400' N

300' N

1700' W


1600' W

1500' W

1400' W

1300' W

1200' W

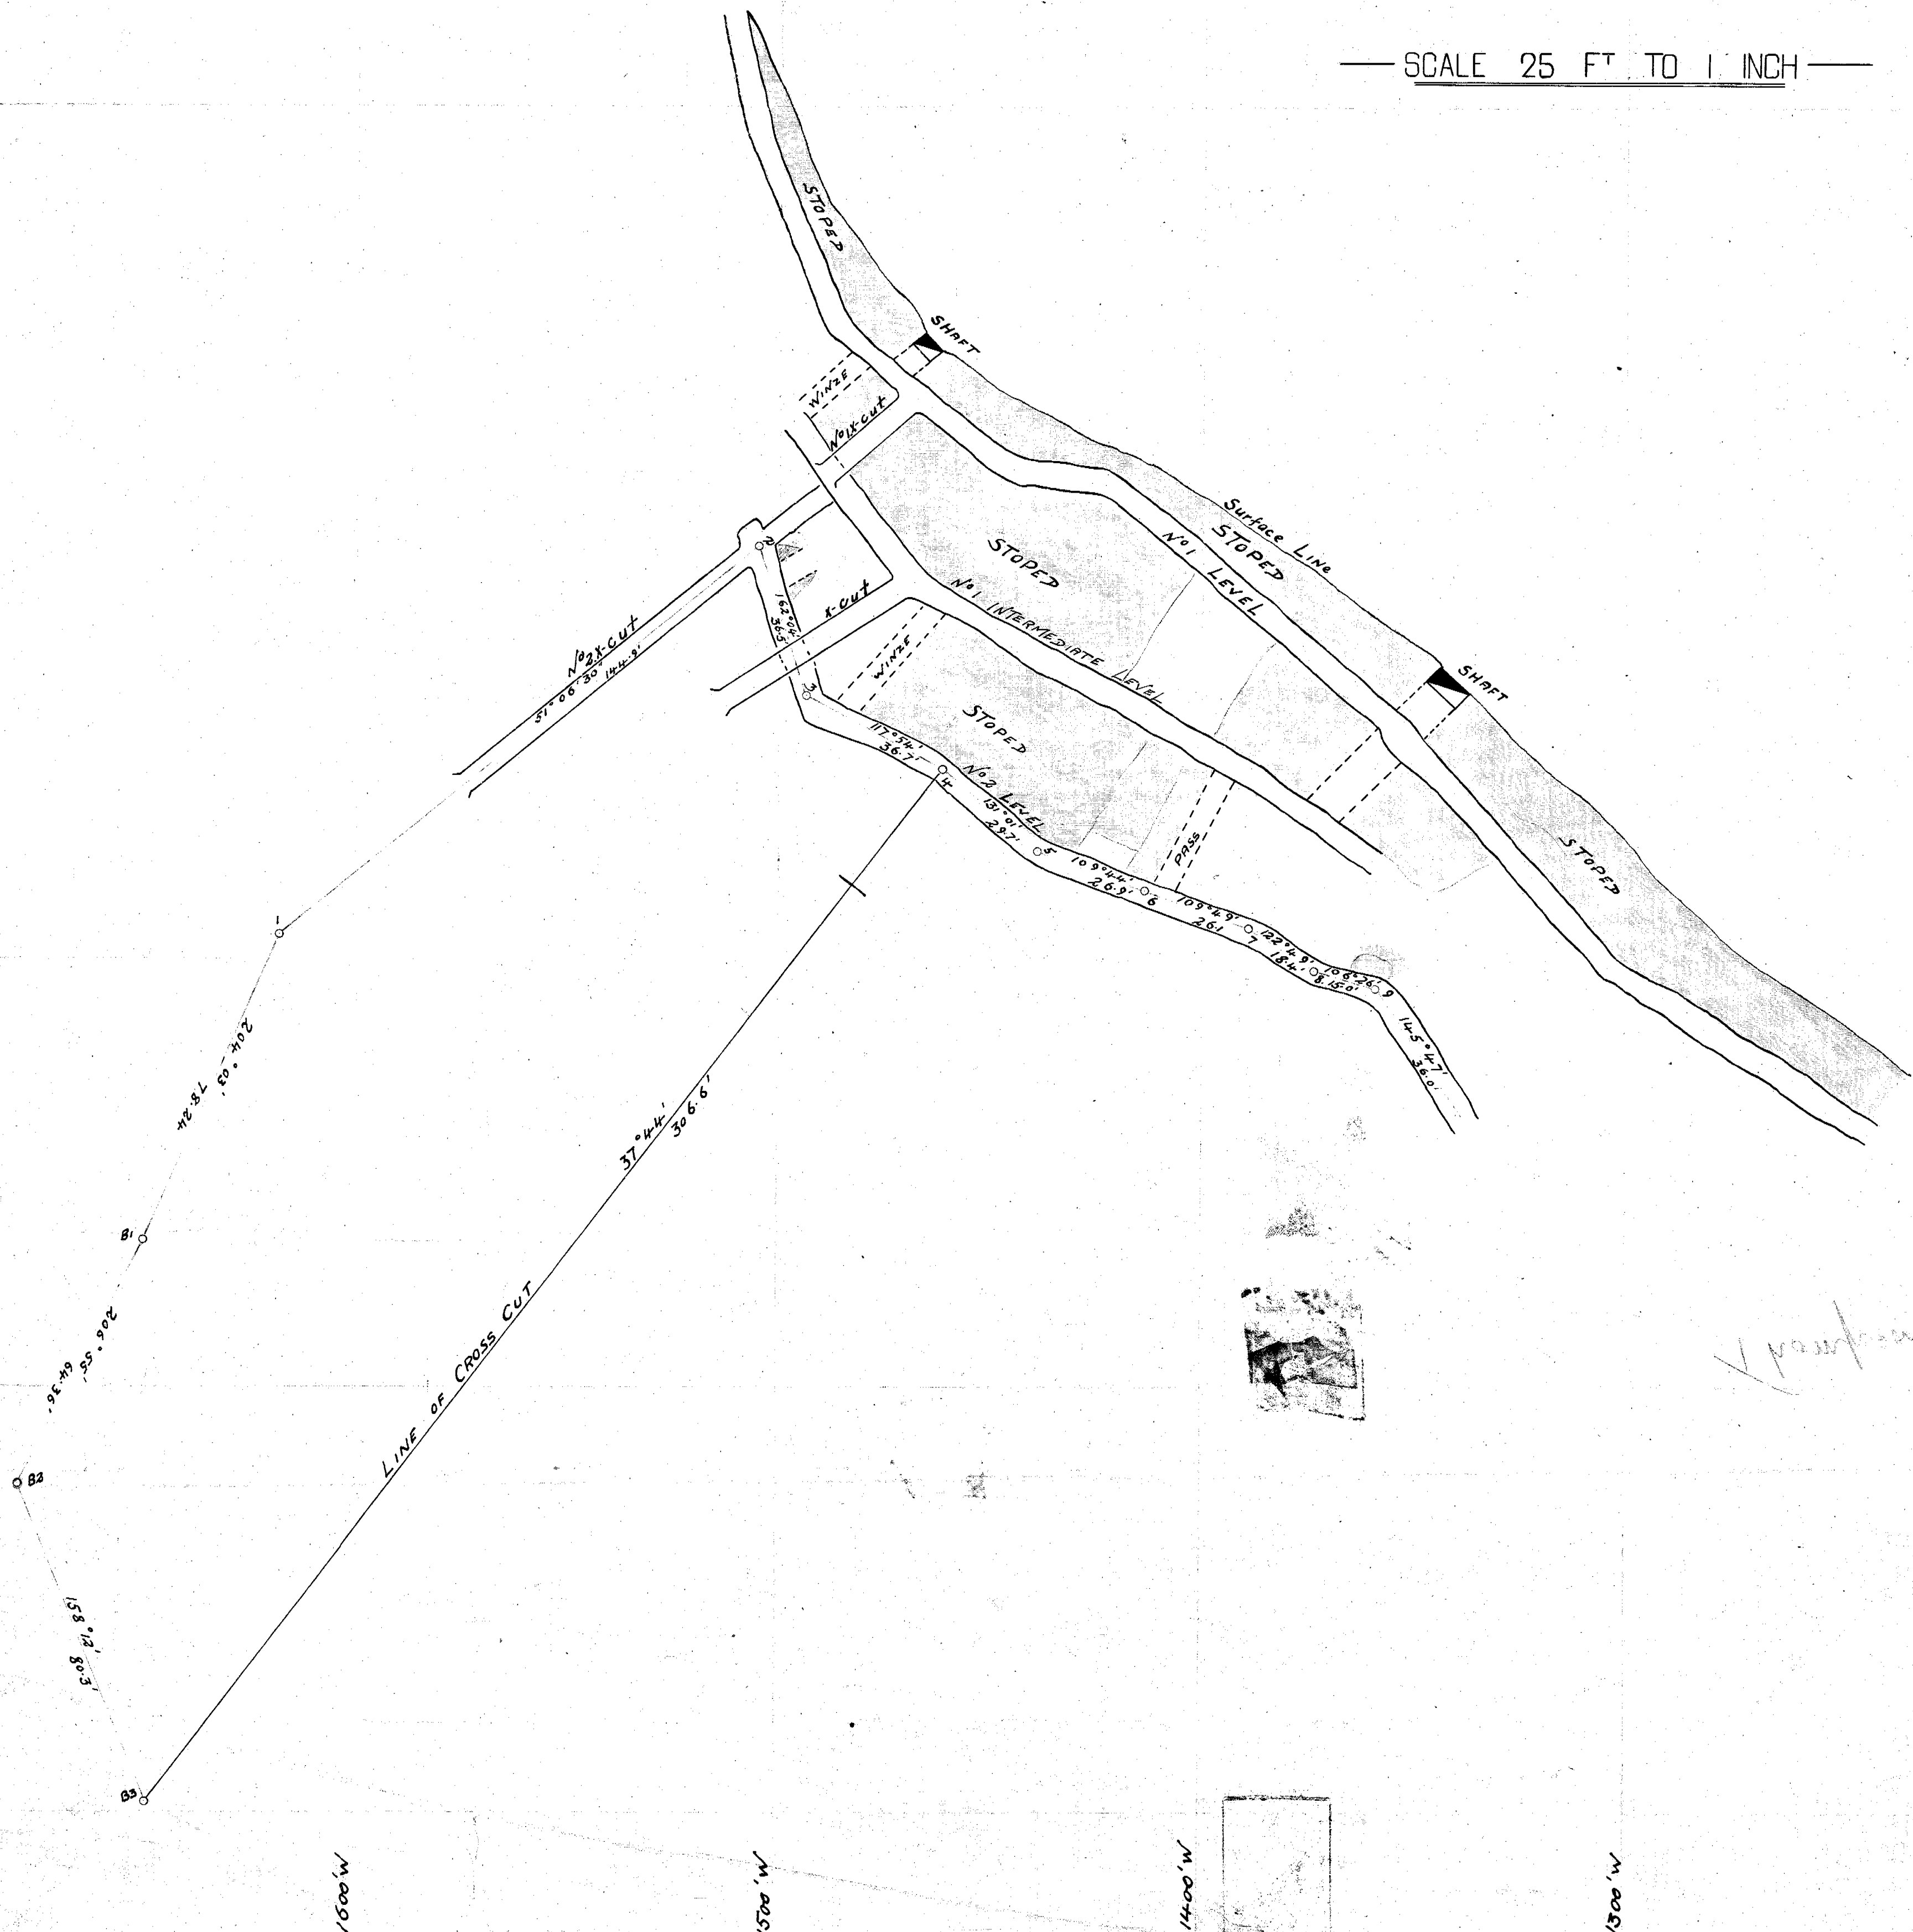

Thompson