

5 cm

217-250

Mt. BISCHOFF T M. Co. Reg.


# THOMPSON LODE

UNDERGROUND WORKINGS TO DEC. 31 1923.

SCALE 25 FT. TO 1 IN.

*W. C. ...  
Company ...  
25.2.24.*

## LONGITUDINAL SECTION

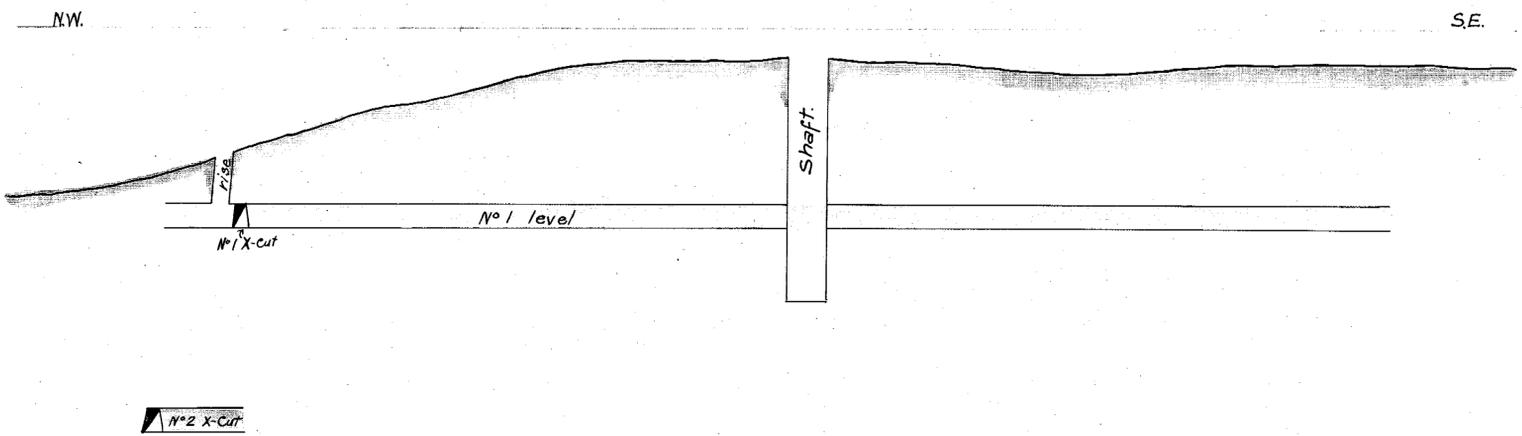

## TRANSVERSE SECTION

