


217-251

5 cm

217-251

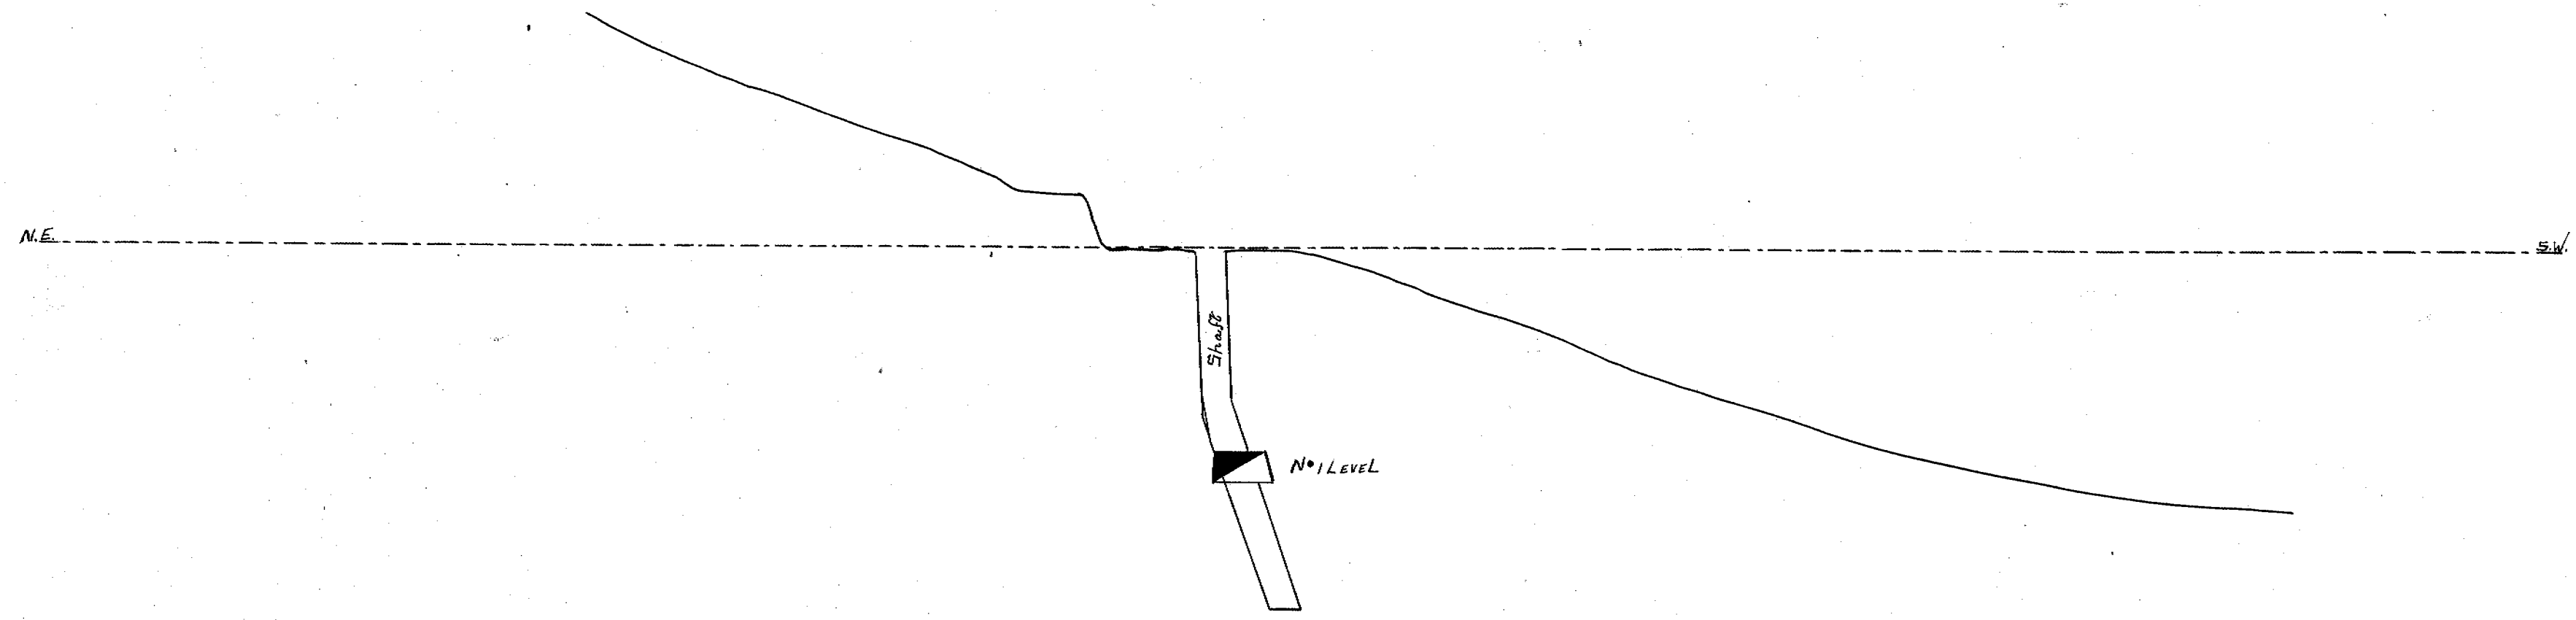

— MT BISCHOFF T. M. CO. REG. —

— **THOMPSON LODE** —

— TRANSVERSE SECTION —

— SCALE 25 FT TO 1 INCH —

*Honolulu.
Hine Burroughs
22-3-23.*

*JP
14-7-23*