


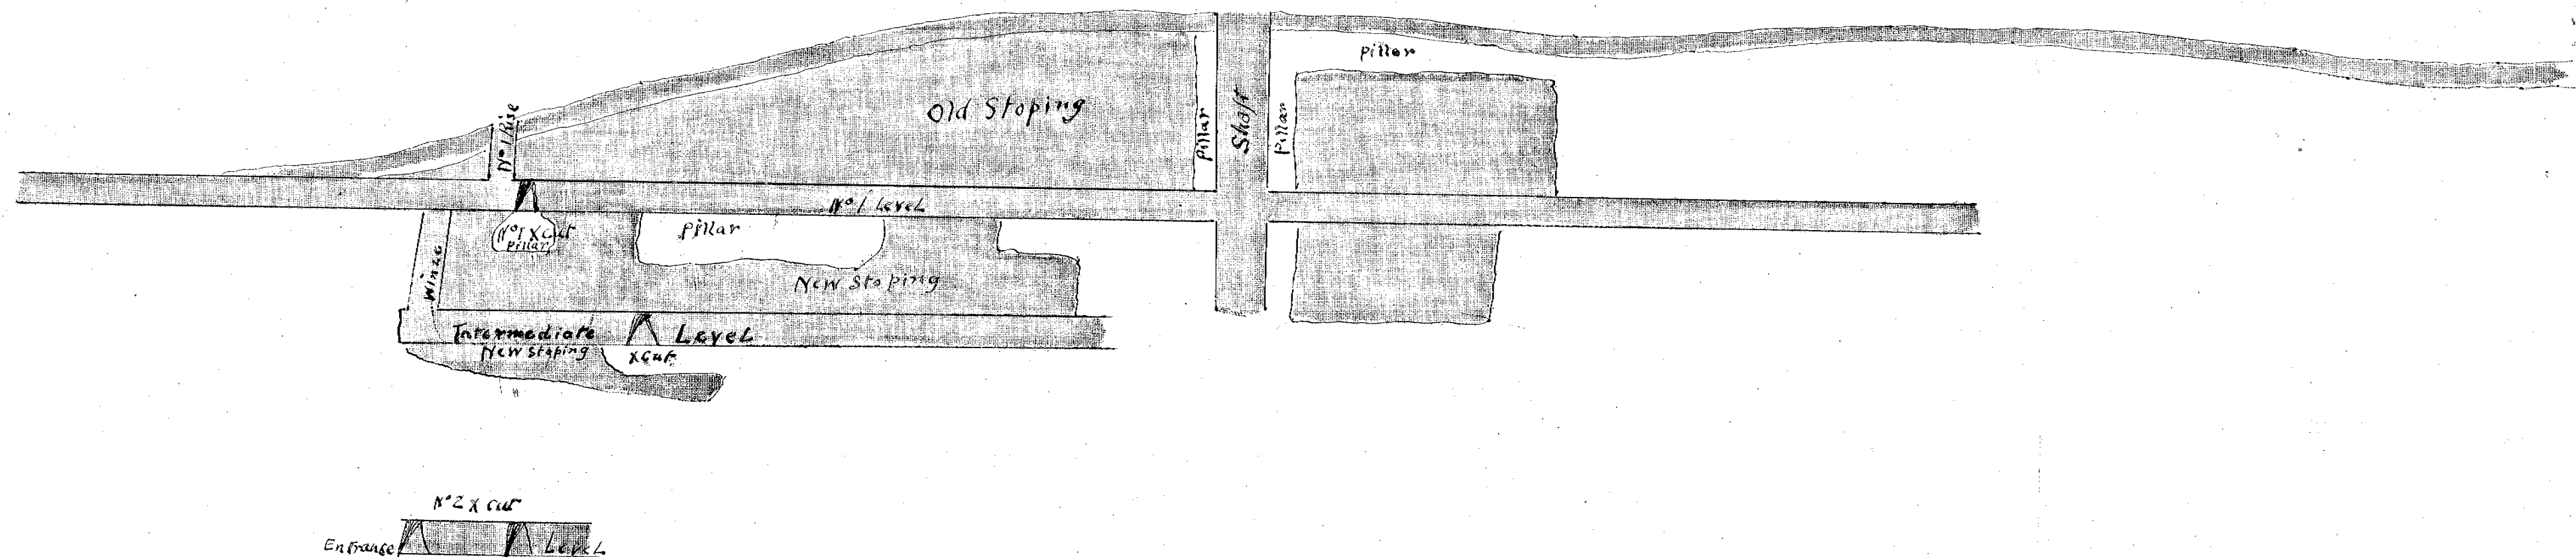

MT BISCHOFF T M CO REG

THOMPSON LODE

— LONGITUDINAL SECTION —

SCALE 25 FT TO 1 INCH

Work 1932
Surveyor W. Porter Judge's Workings
10/7/33

217-252

217-252

5 cm