


MT BISCHOFF T. M. CO. REG.

THOMPSON LODE


— SCALE: 25 FT TO 1 INCH —

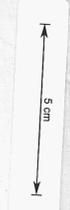

217253

217253

LINE A

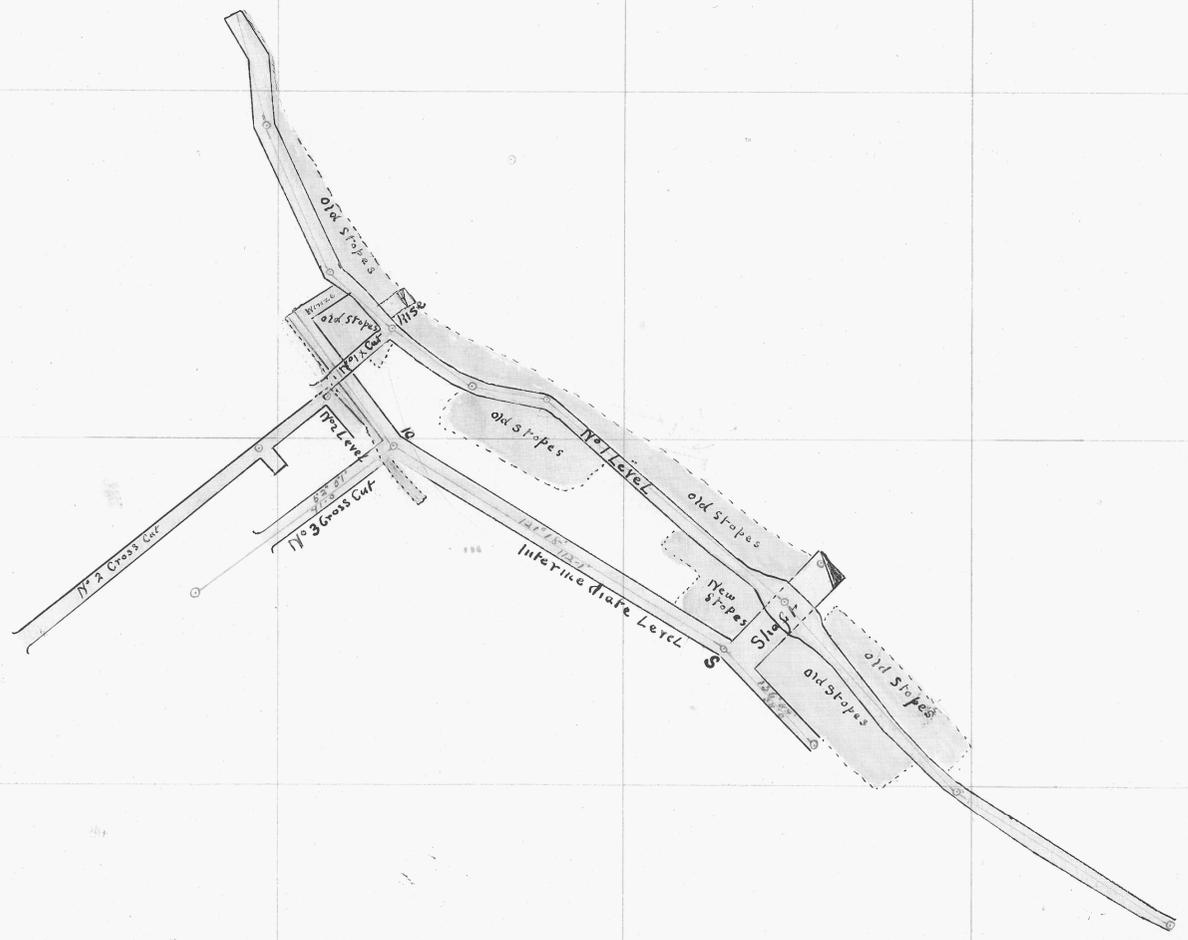

LINE B

Work 1933
Surveyor W. H. Dorte
Instrument used 5" theodolite