


217-254

217-254

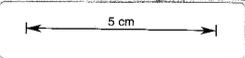




Mt. BISCHOFF T. M. Co. Reg.

# SLAUGHTER LODGE

UNDERGROUND WORKINGS TO DEC. 31 1924.

SCALE 25 FT. TO 1 IN.



*W. Bischoff  
by Surveyor*

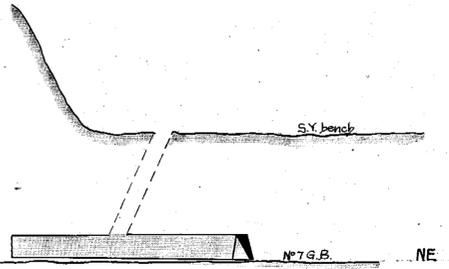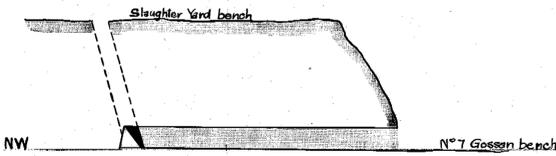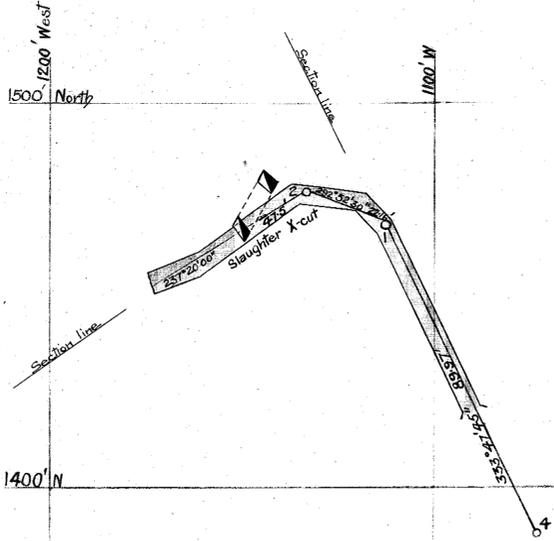


LONGITUDINAL SECTION

TRANSVERSE SECTION

# THOMPSON LODGE

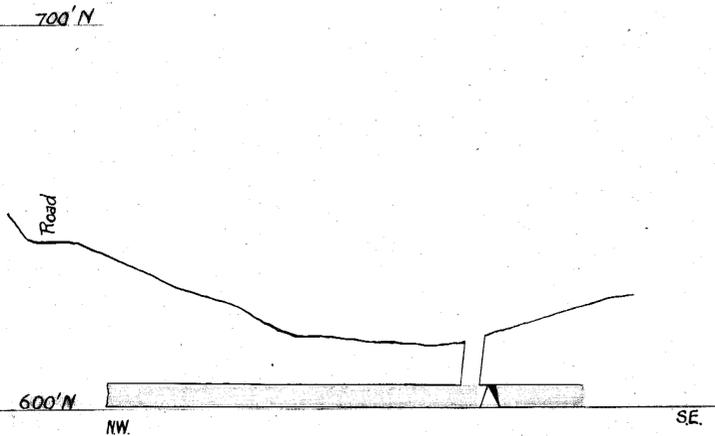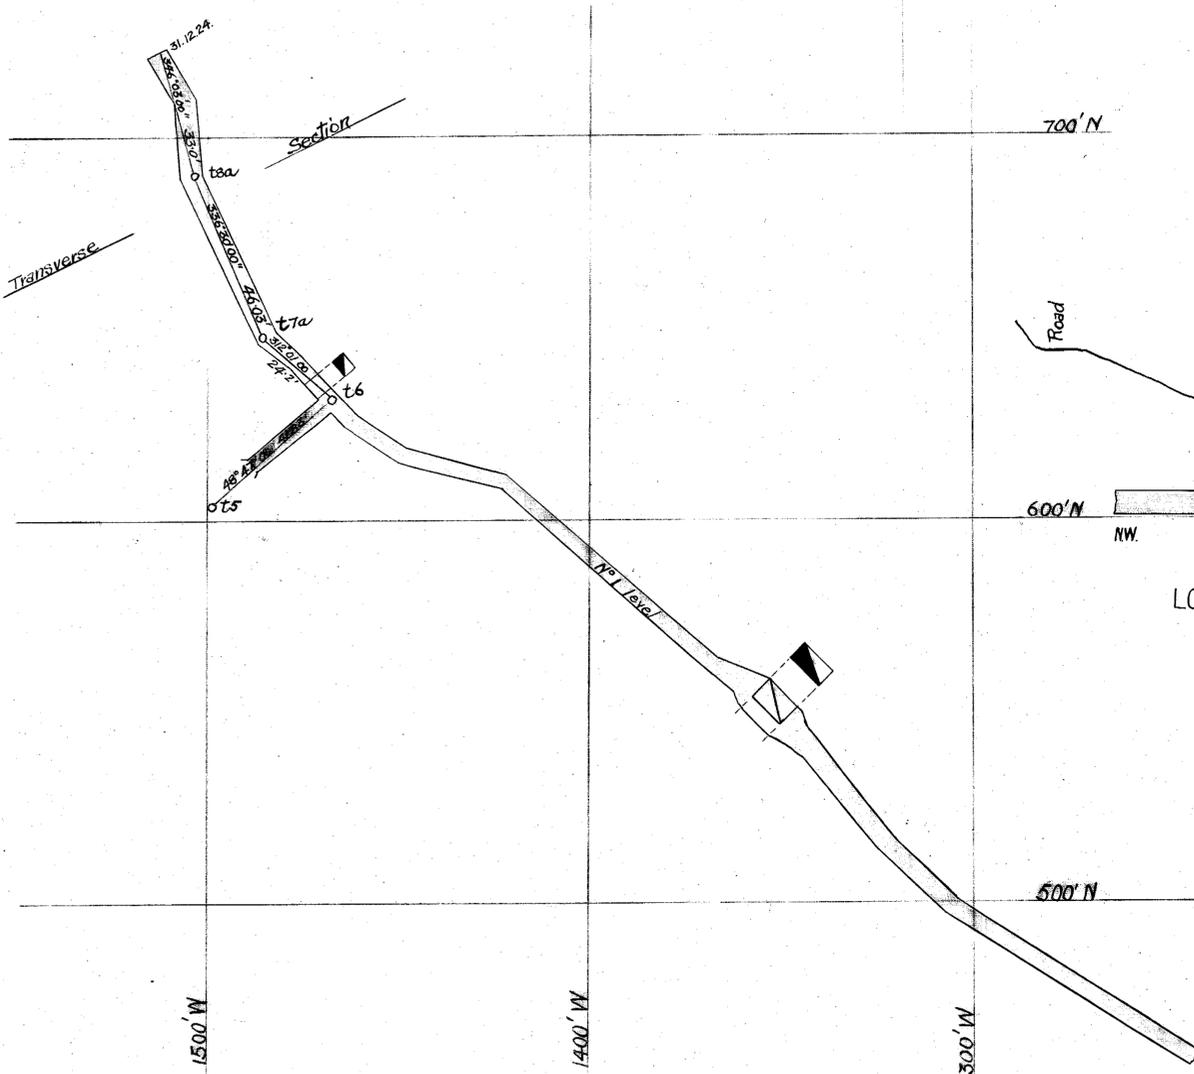

LONGITUDINAL SECTION

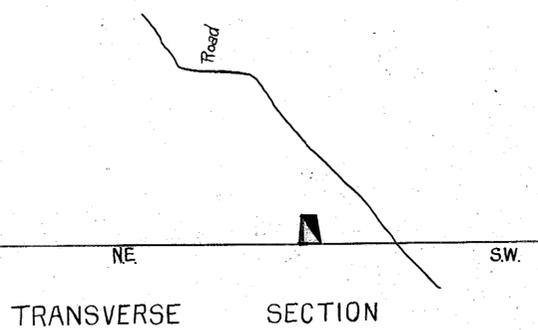

TRANSVERSE SECTION