



217255

5 cm

217255

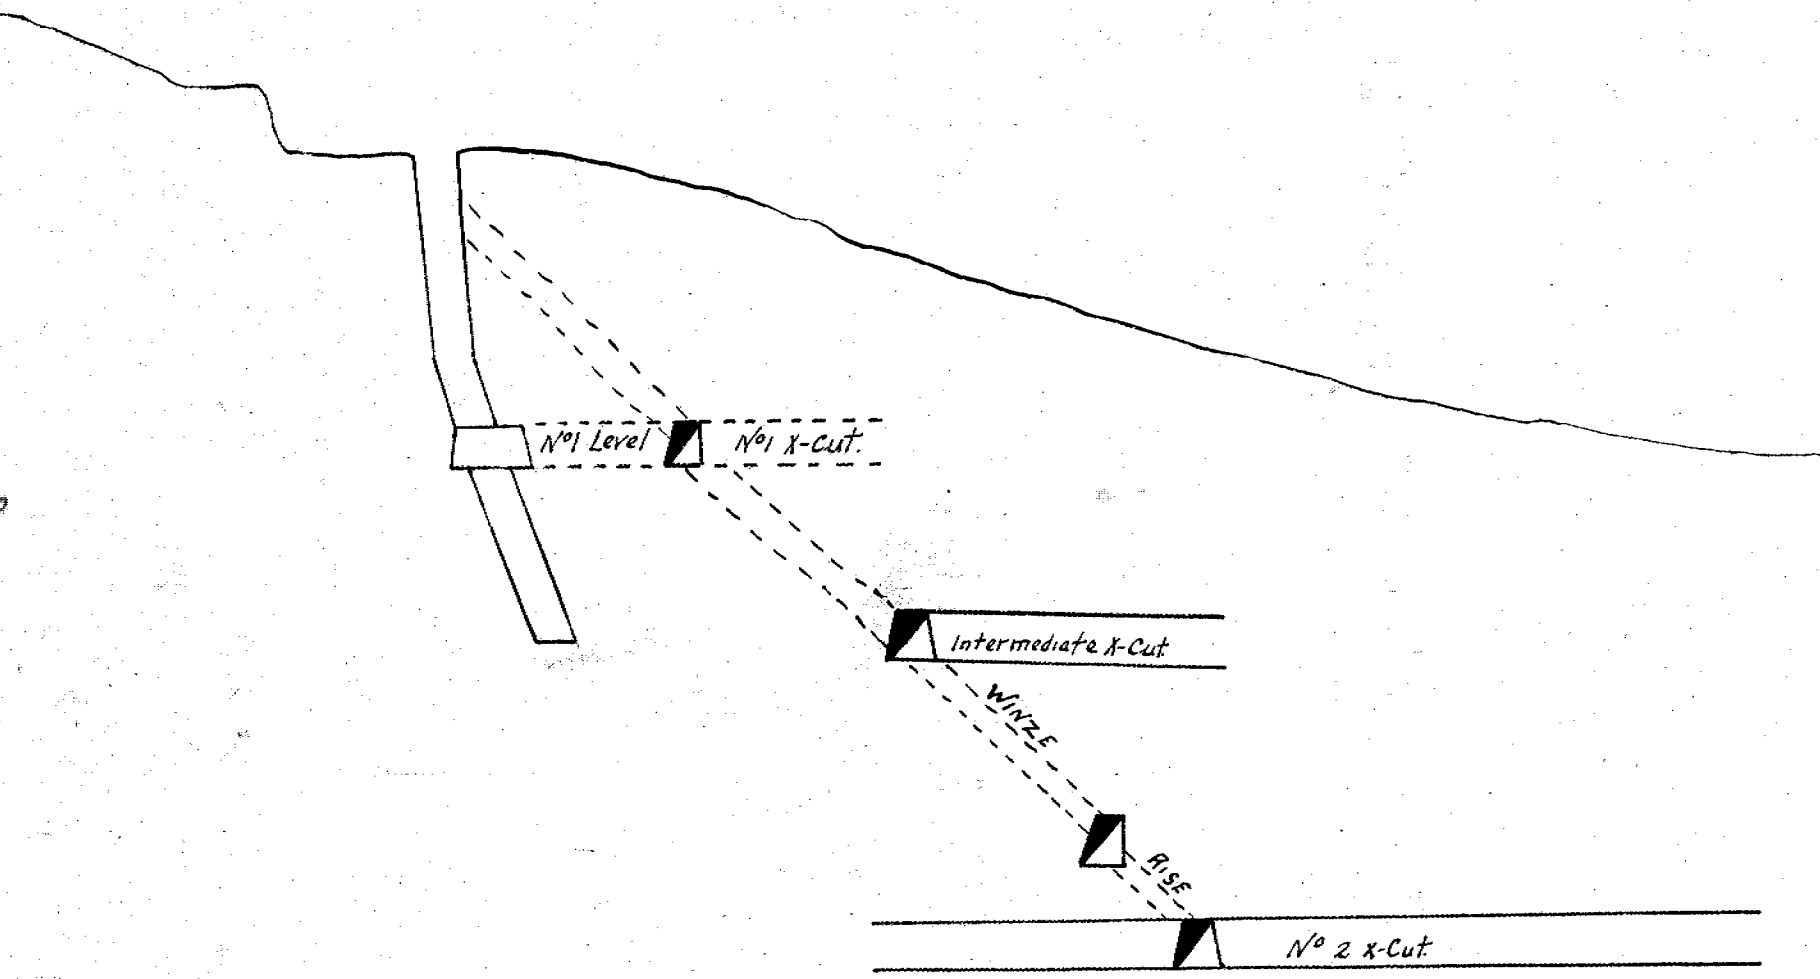

Transverse Section.

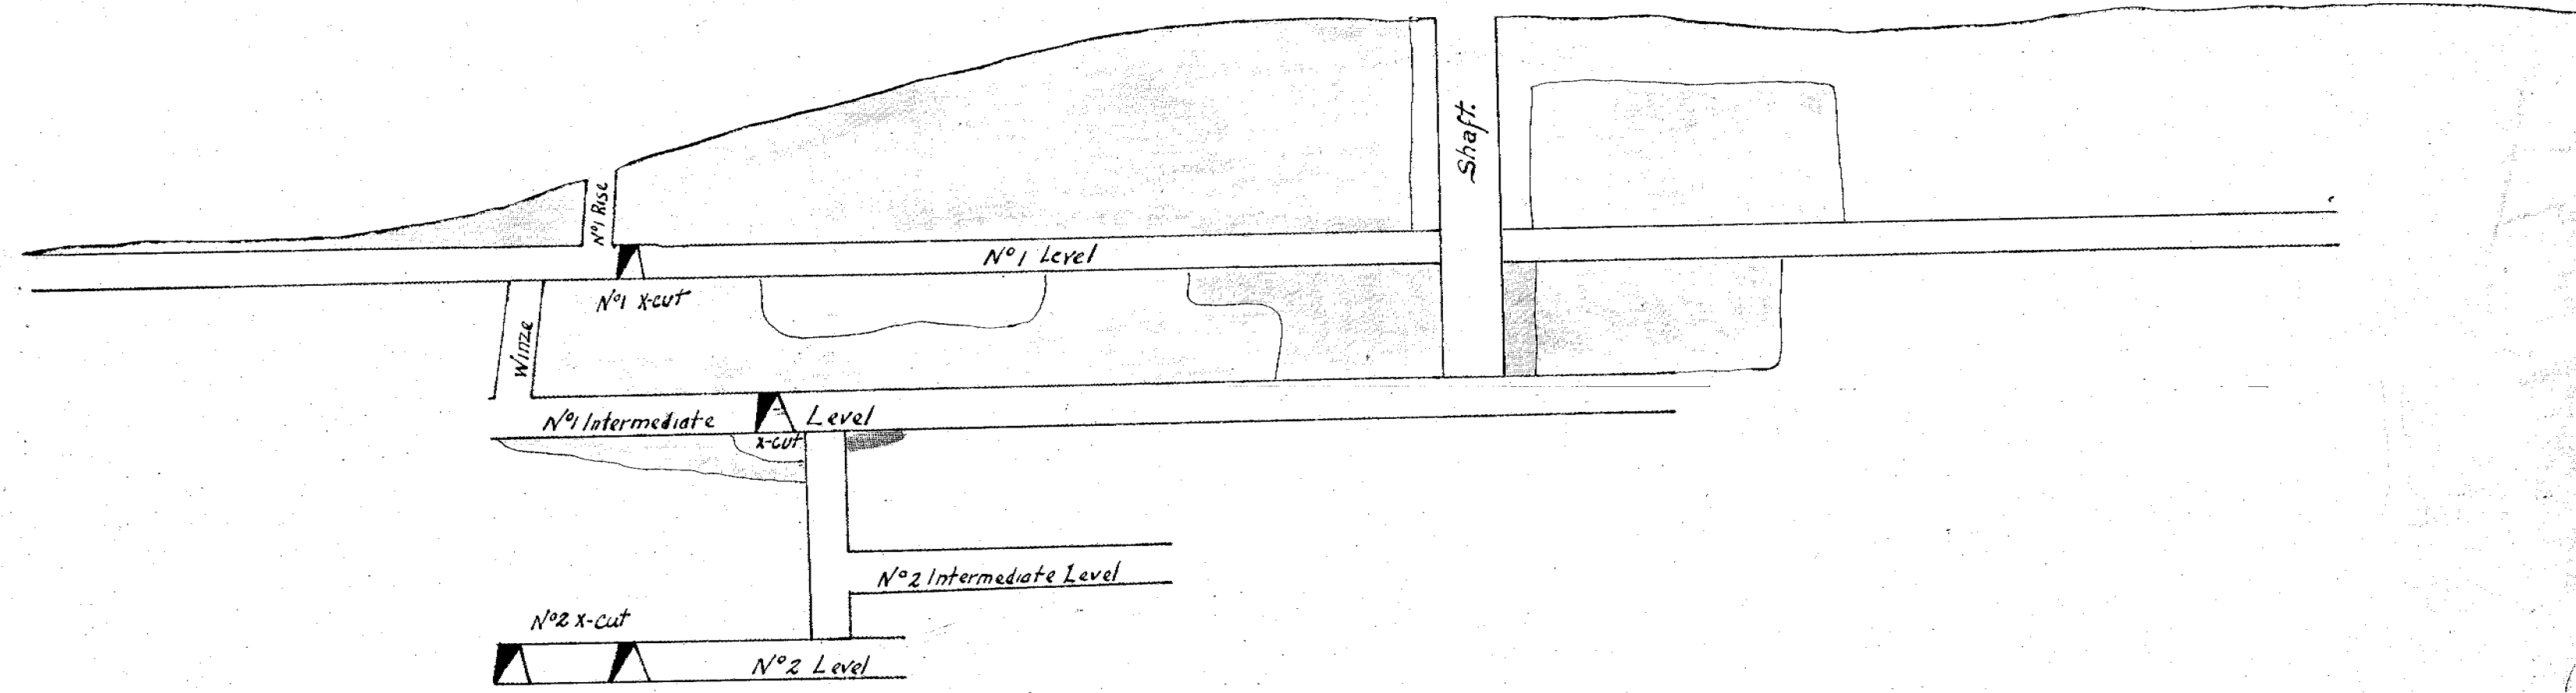

MT BISCHOFF T. M. CO. REC.

THOMPSON LODE

LONGITUDINAL SECTION

SCALE 25 FT TO 1 INCH

Work 1935
Surveyor Mr. B. D. Dyer
Just used 6" theodolite