

— MT BISCHOFF T M CO REG —



— SLAUGHTER LODGE —

— SCALE 25 FT TO 1 INCH —

217-262

5 cm

217-262

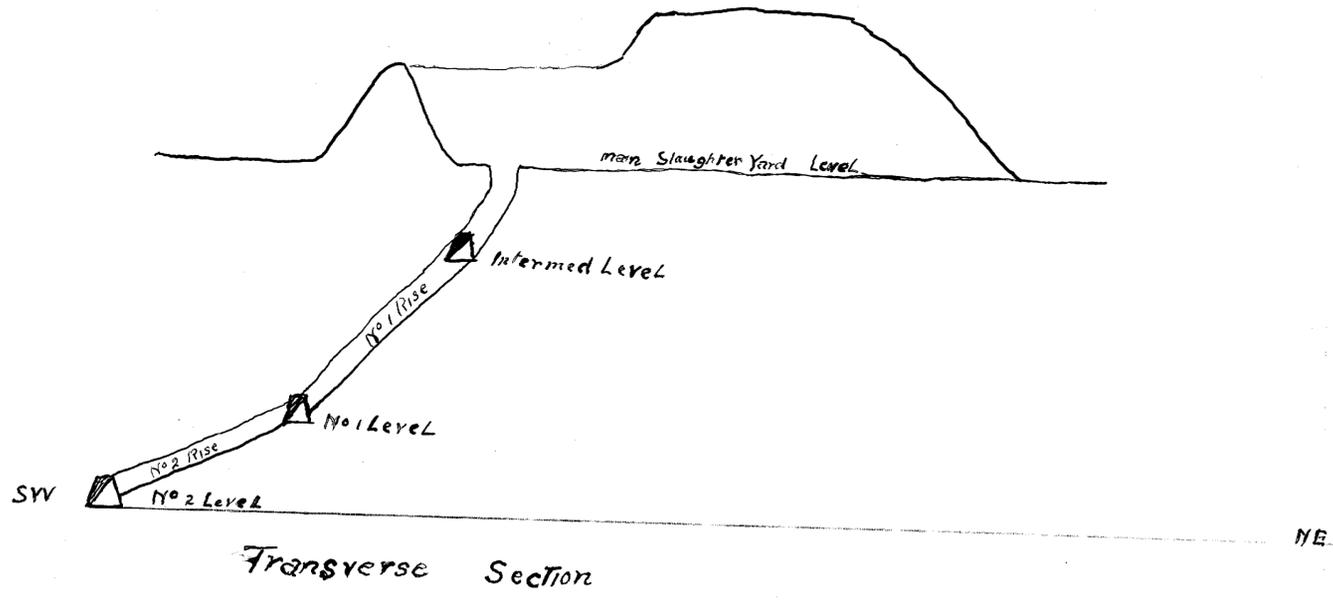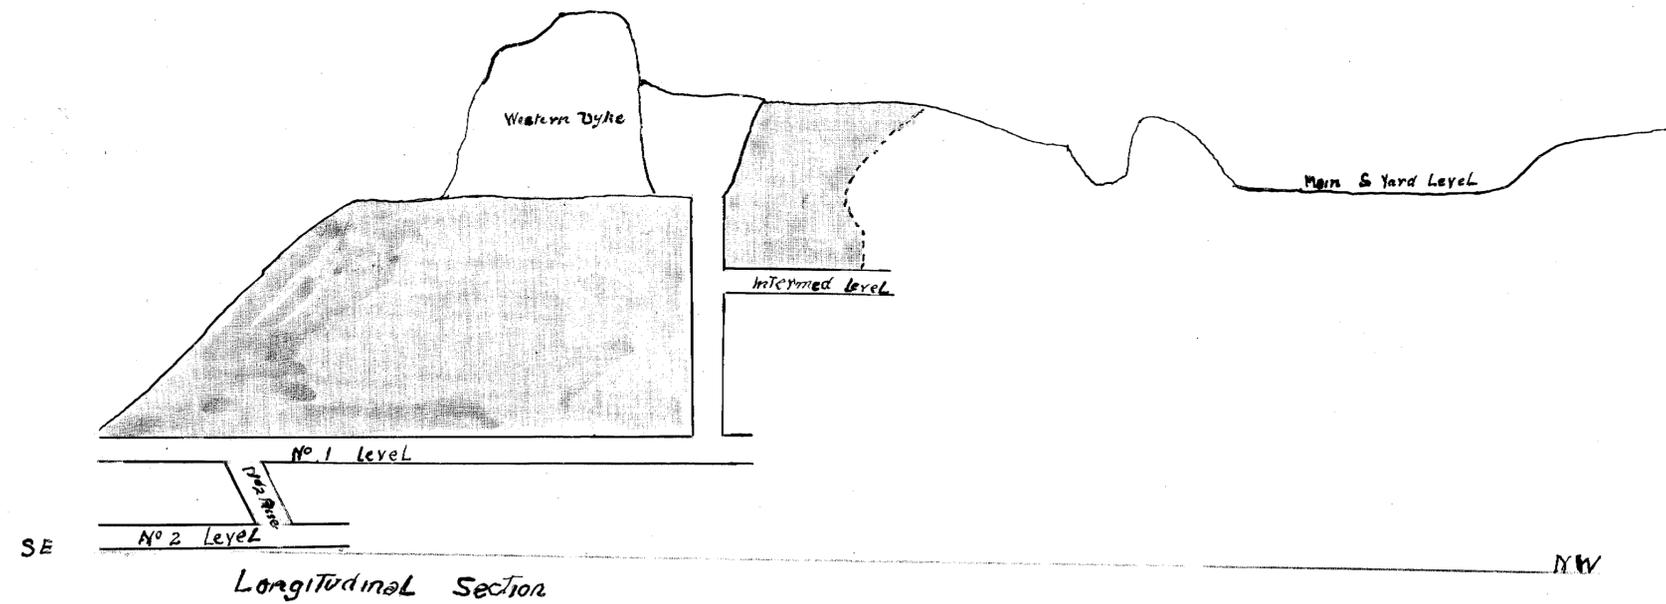

W. J. Dow
10/3/42