


217-264

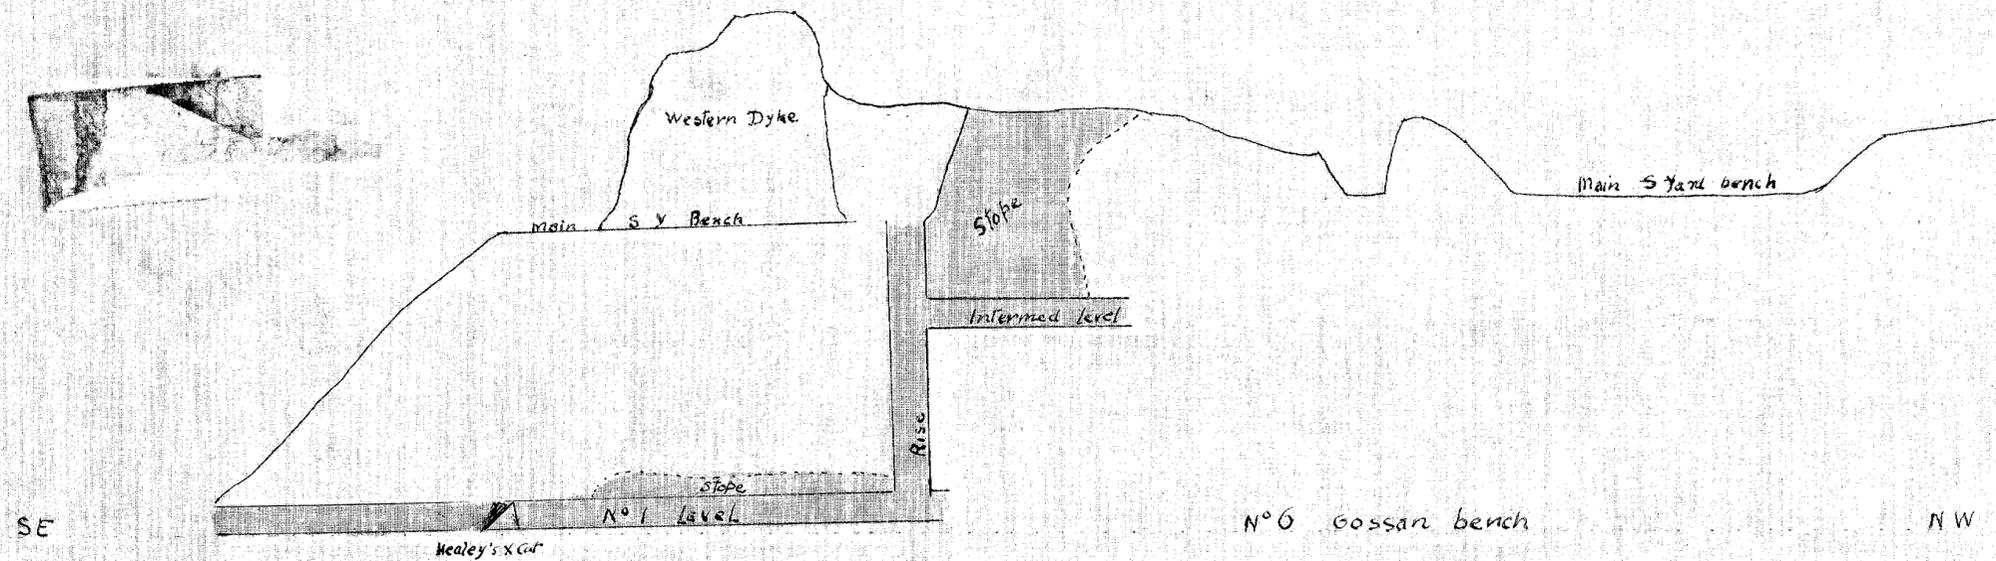


Longitudinal Section

MT BISCHOFF T.M CO. REC.
N° 1
SLAUGHTER LODGE

LONGITUDINAL SECTION

Scale 25 FT to 1 inch

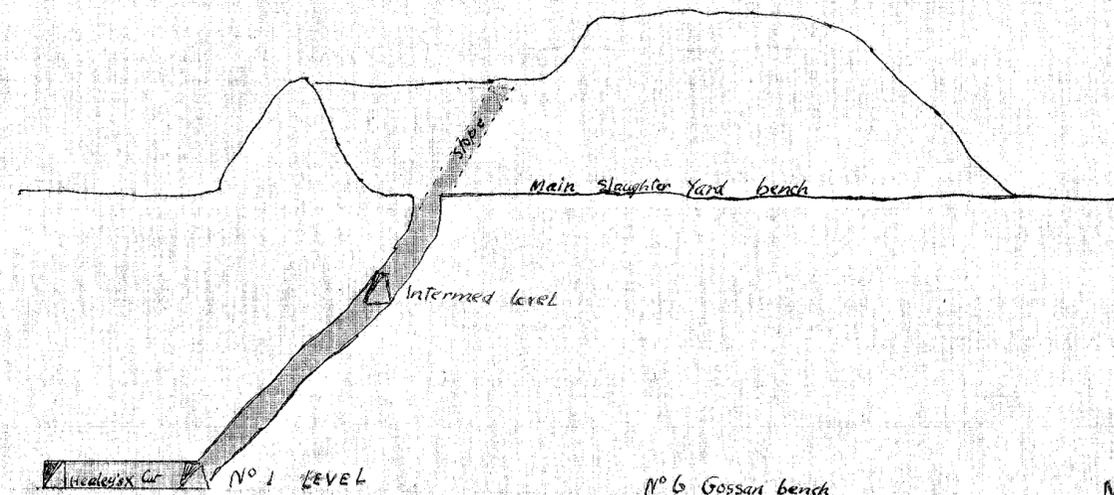

Transverse Section

217-264

5 cm

Surveyor W Post
but much of the work
11/3/32