

— Mt. Bischoff T.M. Co. Reg. —

Stoping on Thompson Lode during 1924


Scale 25' = 1"

Solid Ground: Hatched.
 Stopped Ground: Stippled

W. Bischoff
 Coy. Surveyor.

217-267

217-267

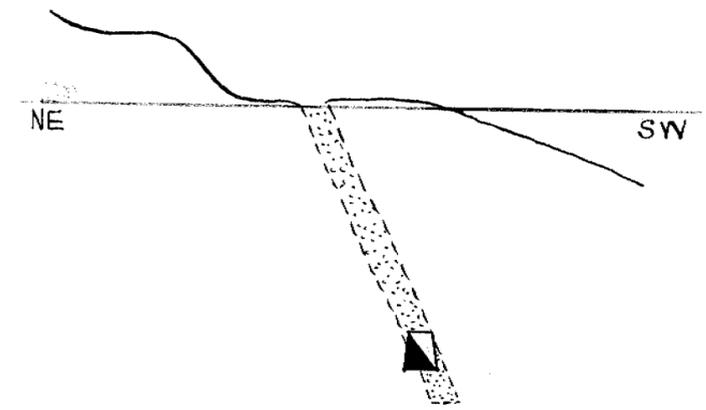

5 cm