


217-268

217-268

5 cm

W. H. D. Dow
10th March
1942

Section

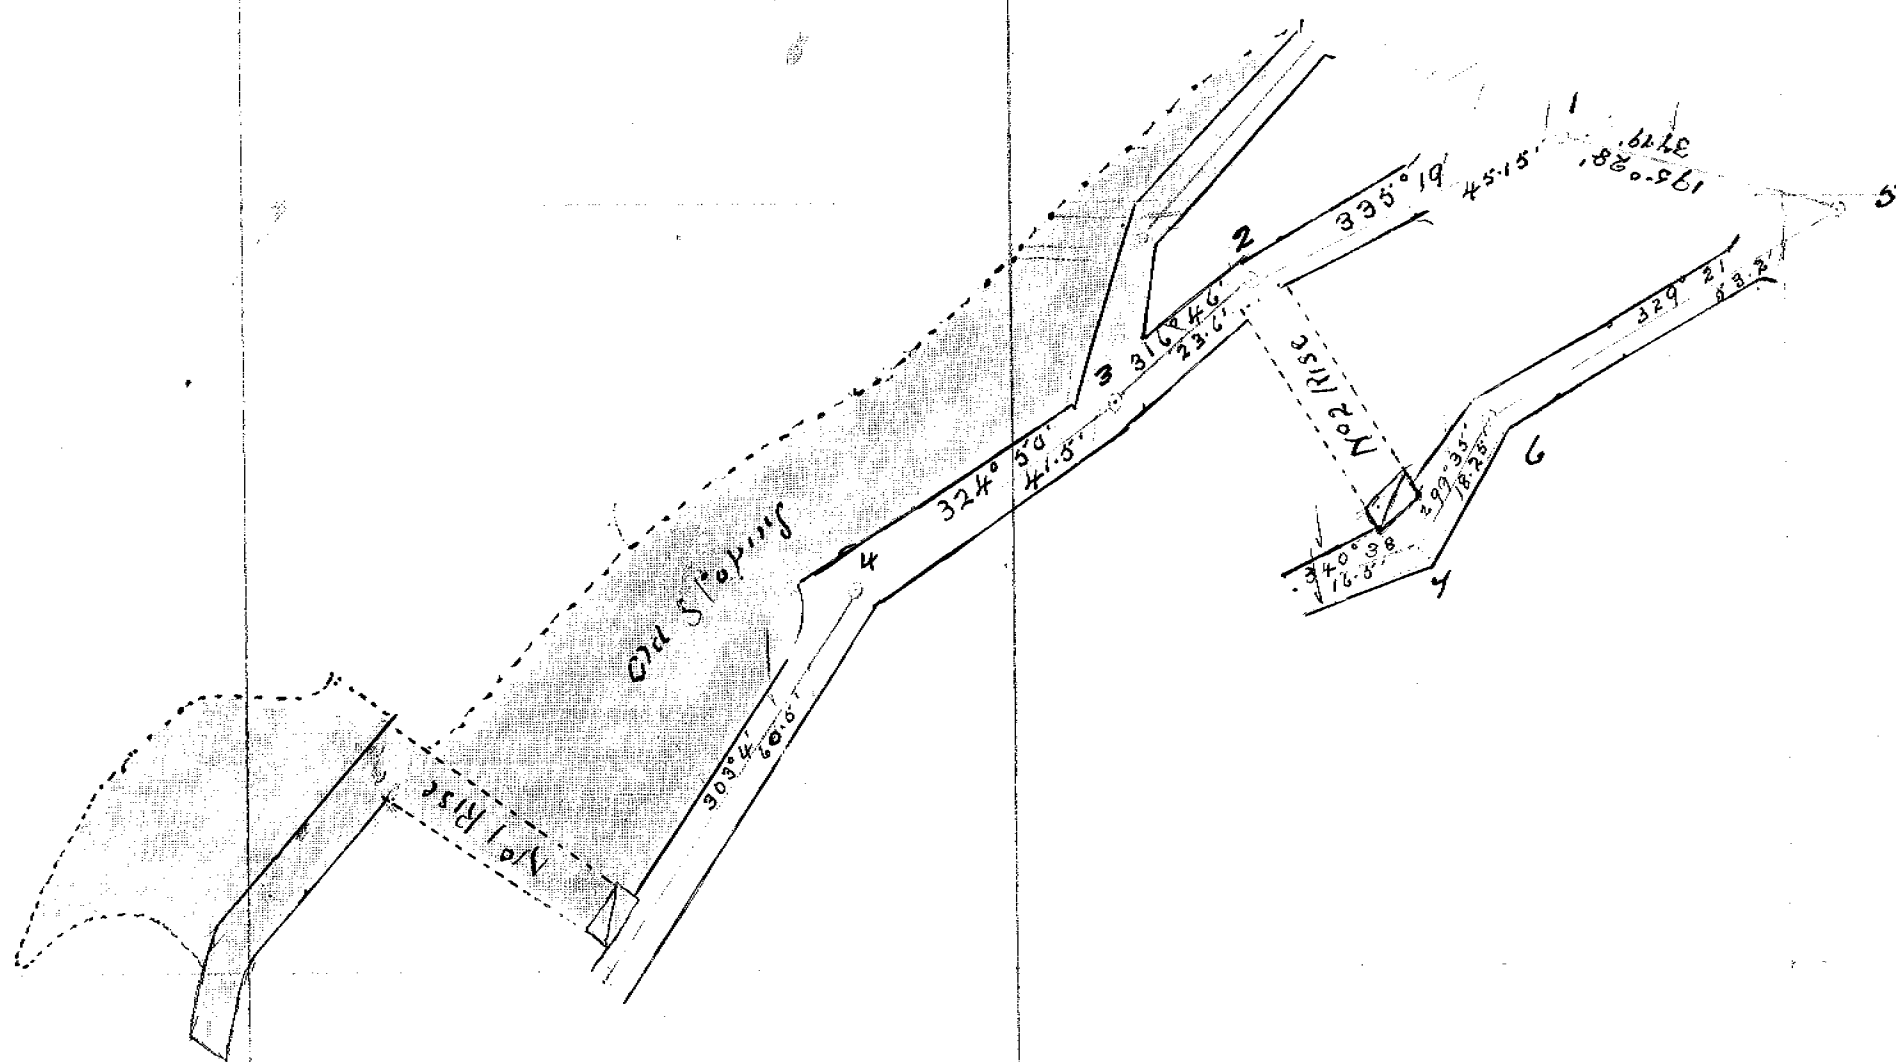

— MT BISCHOFF T M CO REC —
— SLAUGHTER LODGE —
— SCALE: 25 FT TO 1 INCH —