


247-269

61-67-7
 61-67-7
 61-67-7

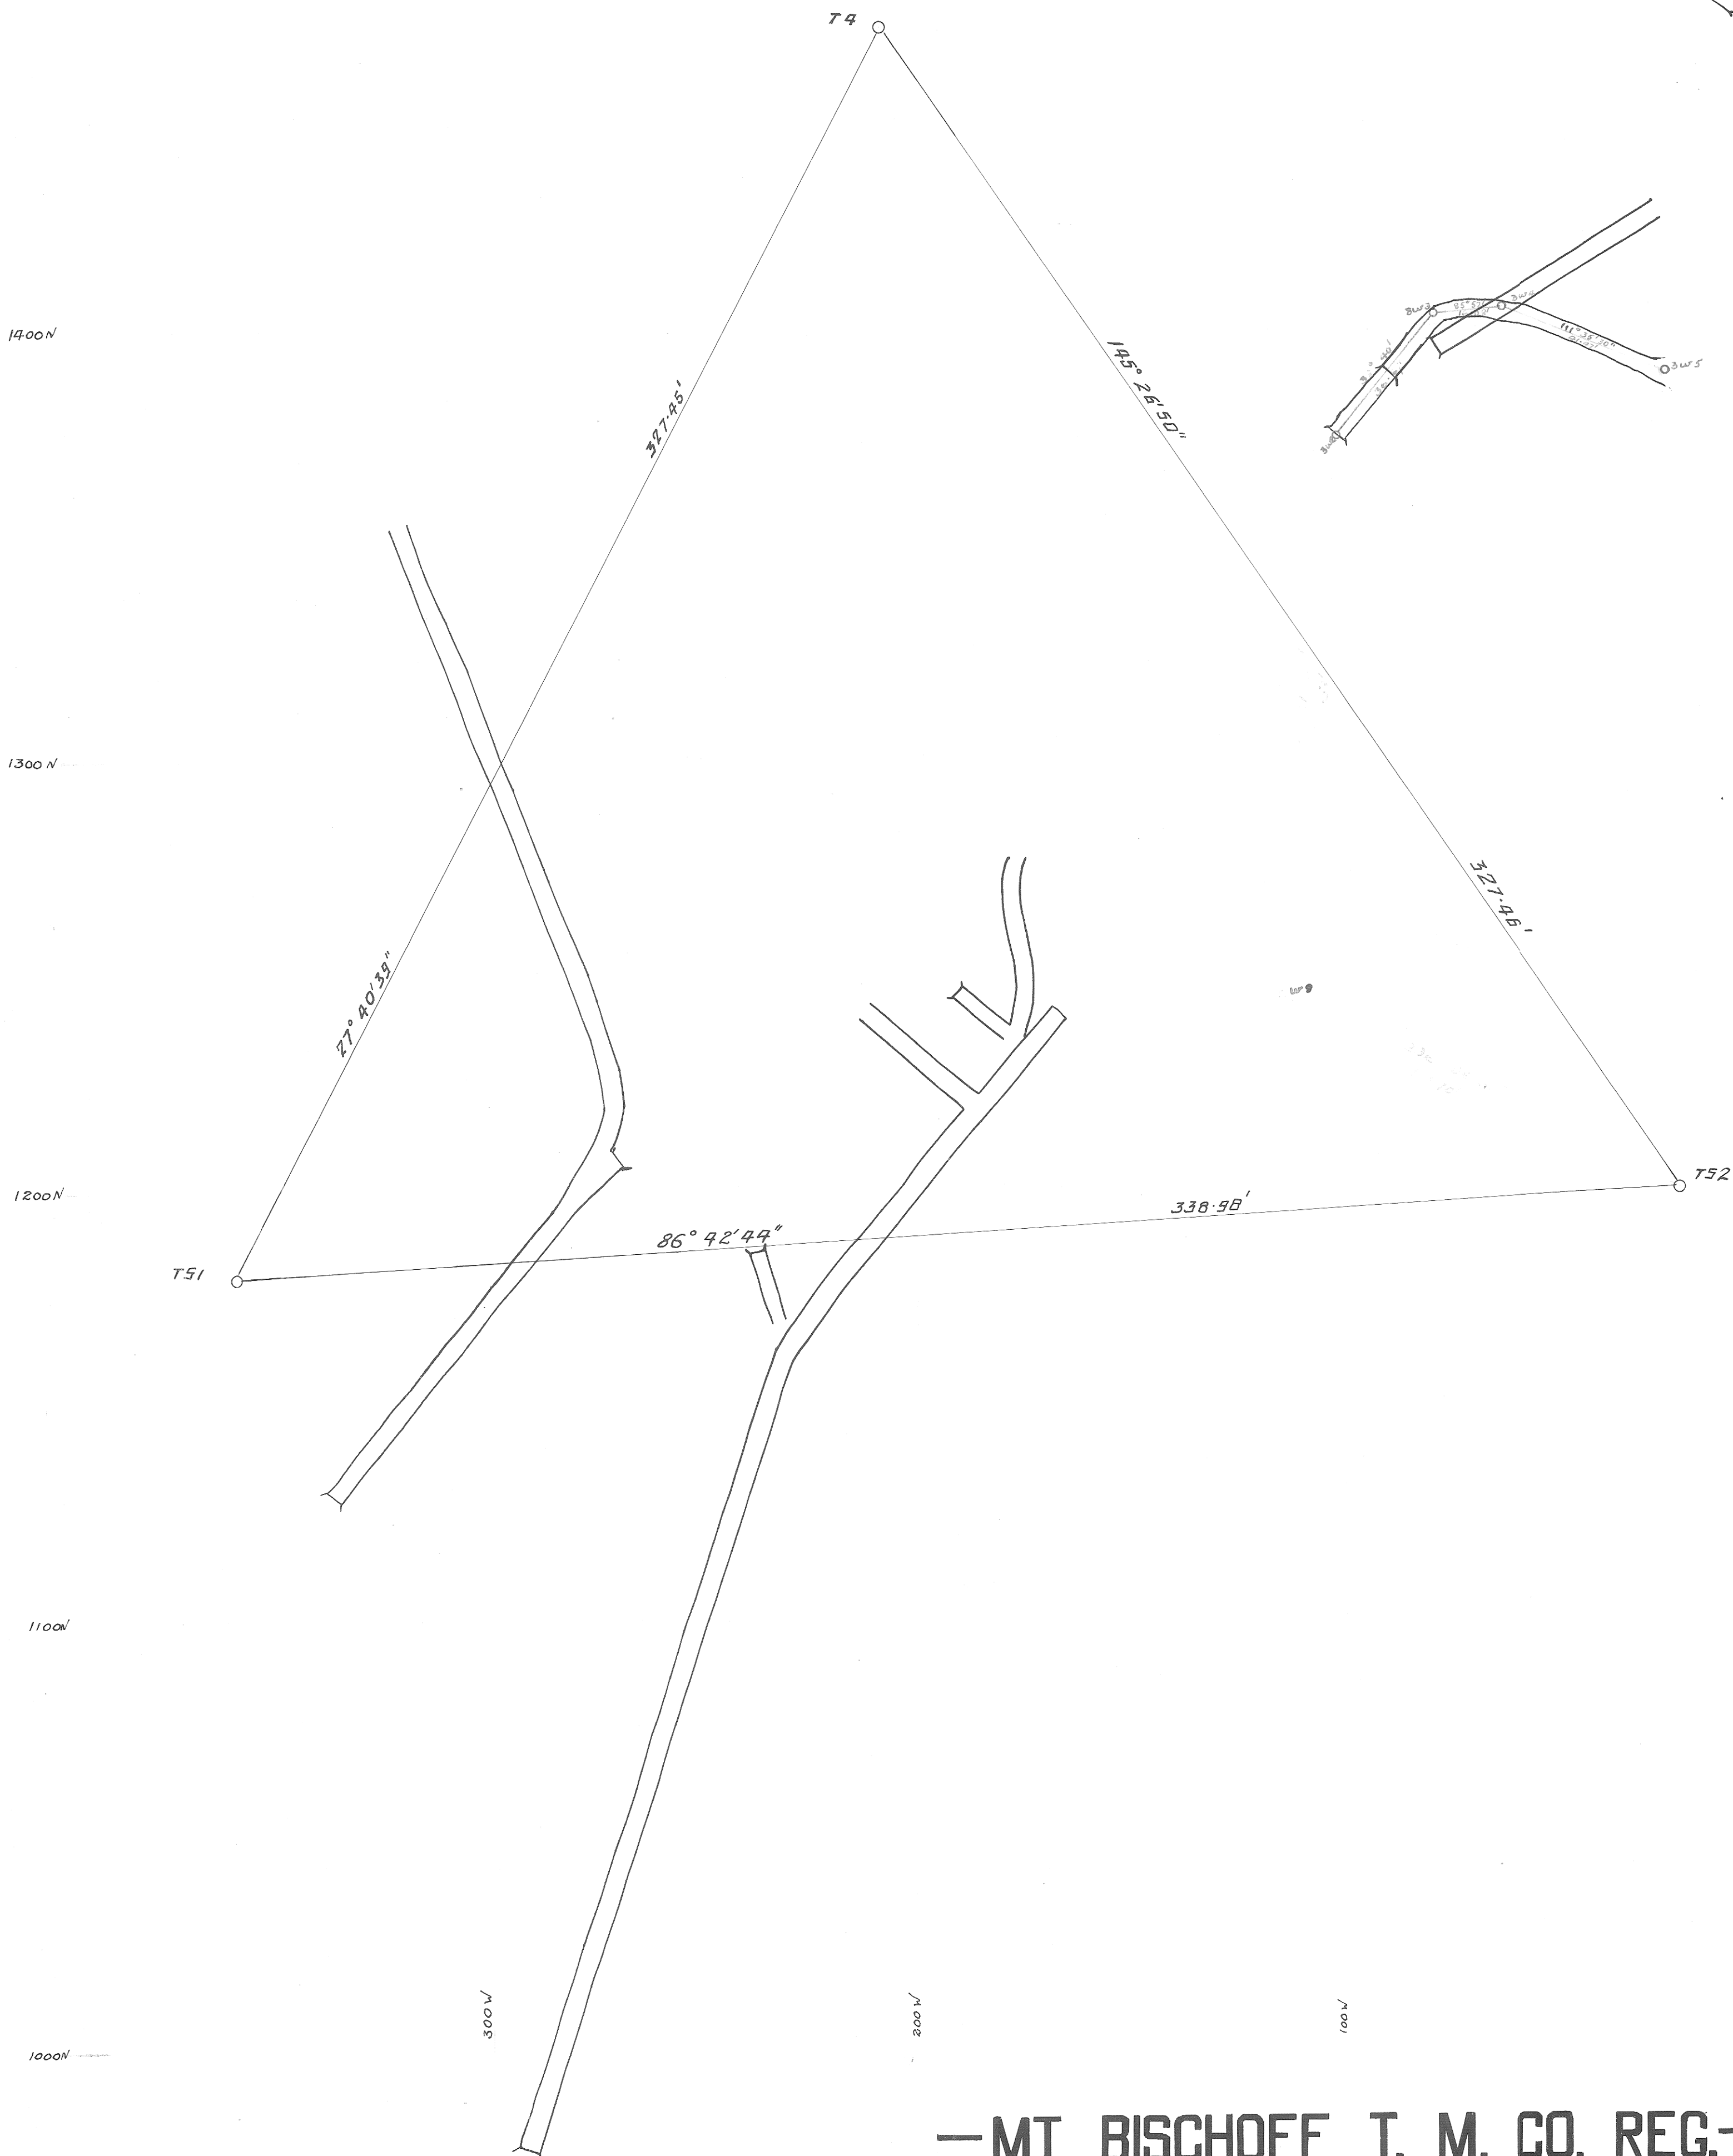

—MT BISCHOFF T. M. CO. REG.—

— WHITE FACE —

— SCALE 25 FT TO 1 INCH —

8-12-23