
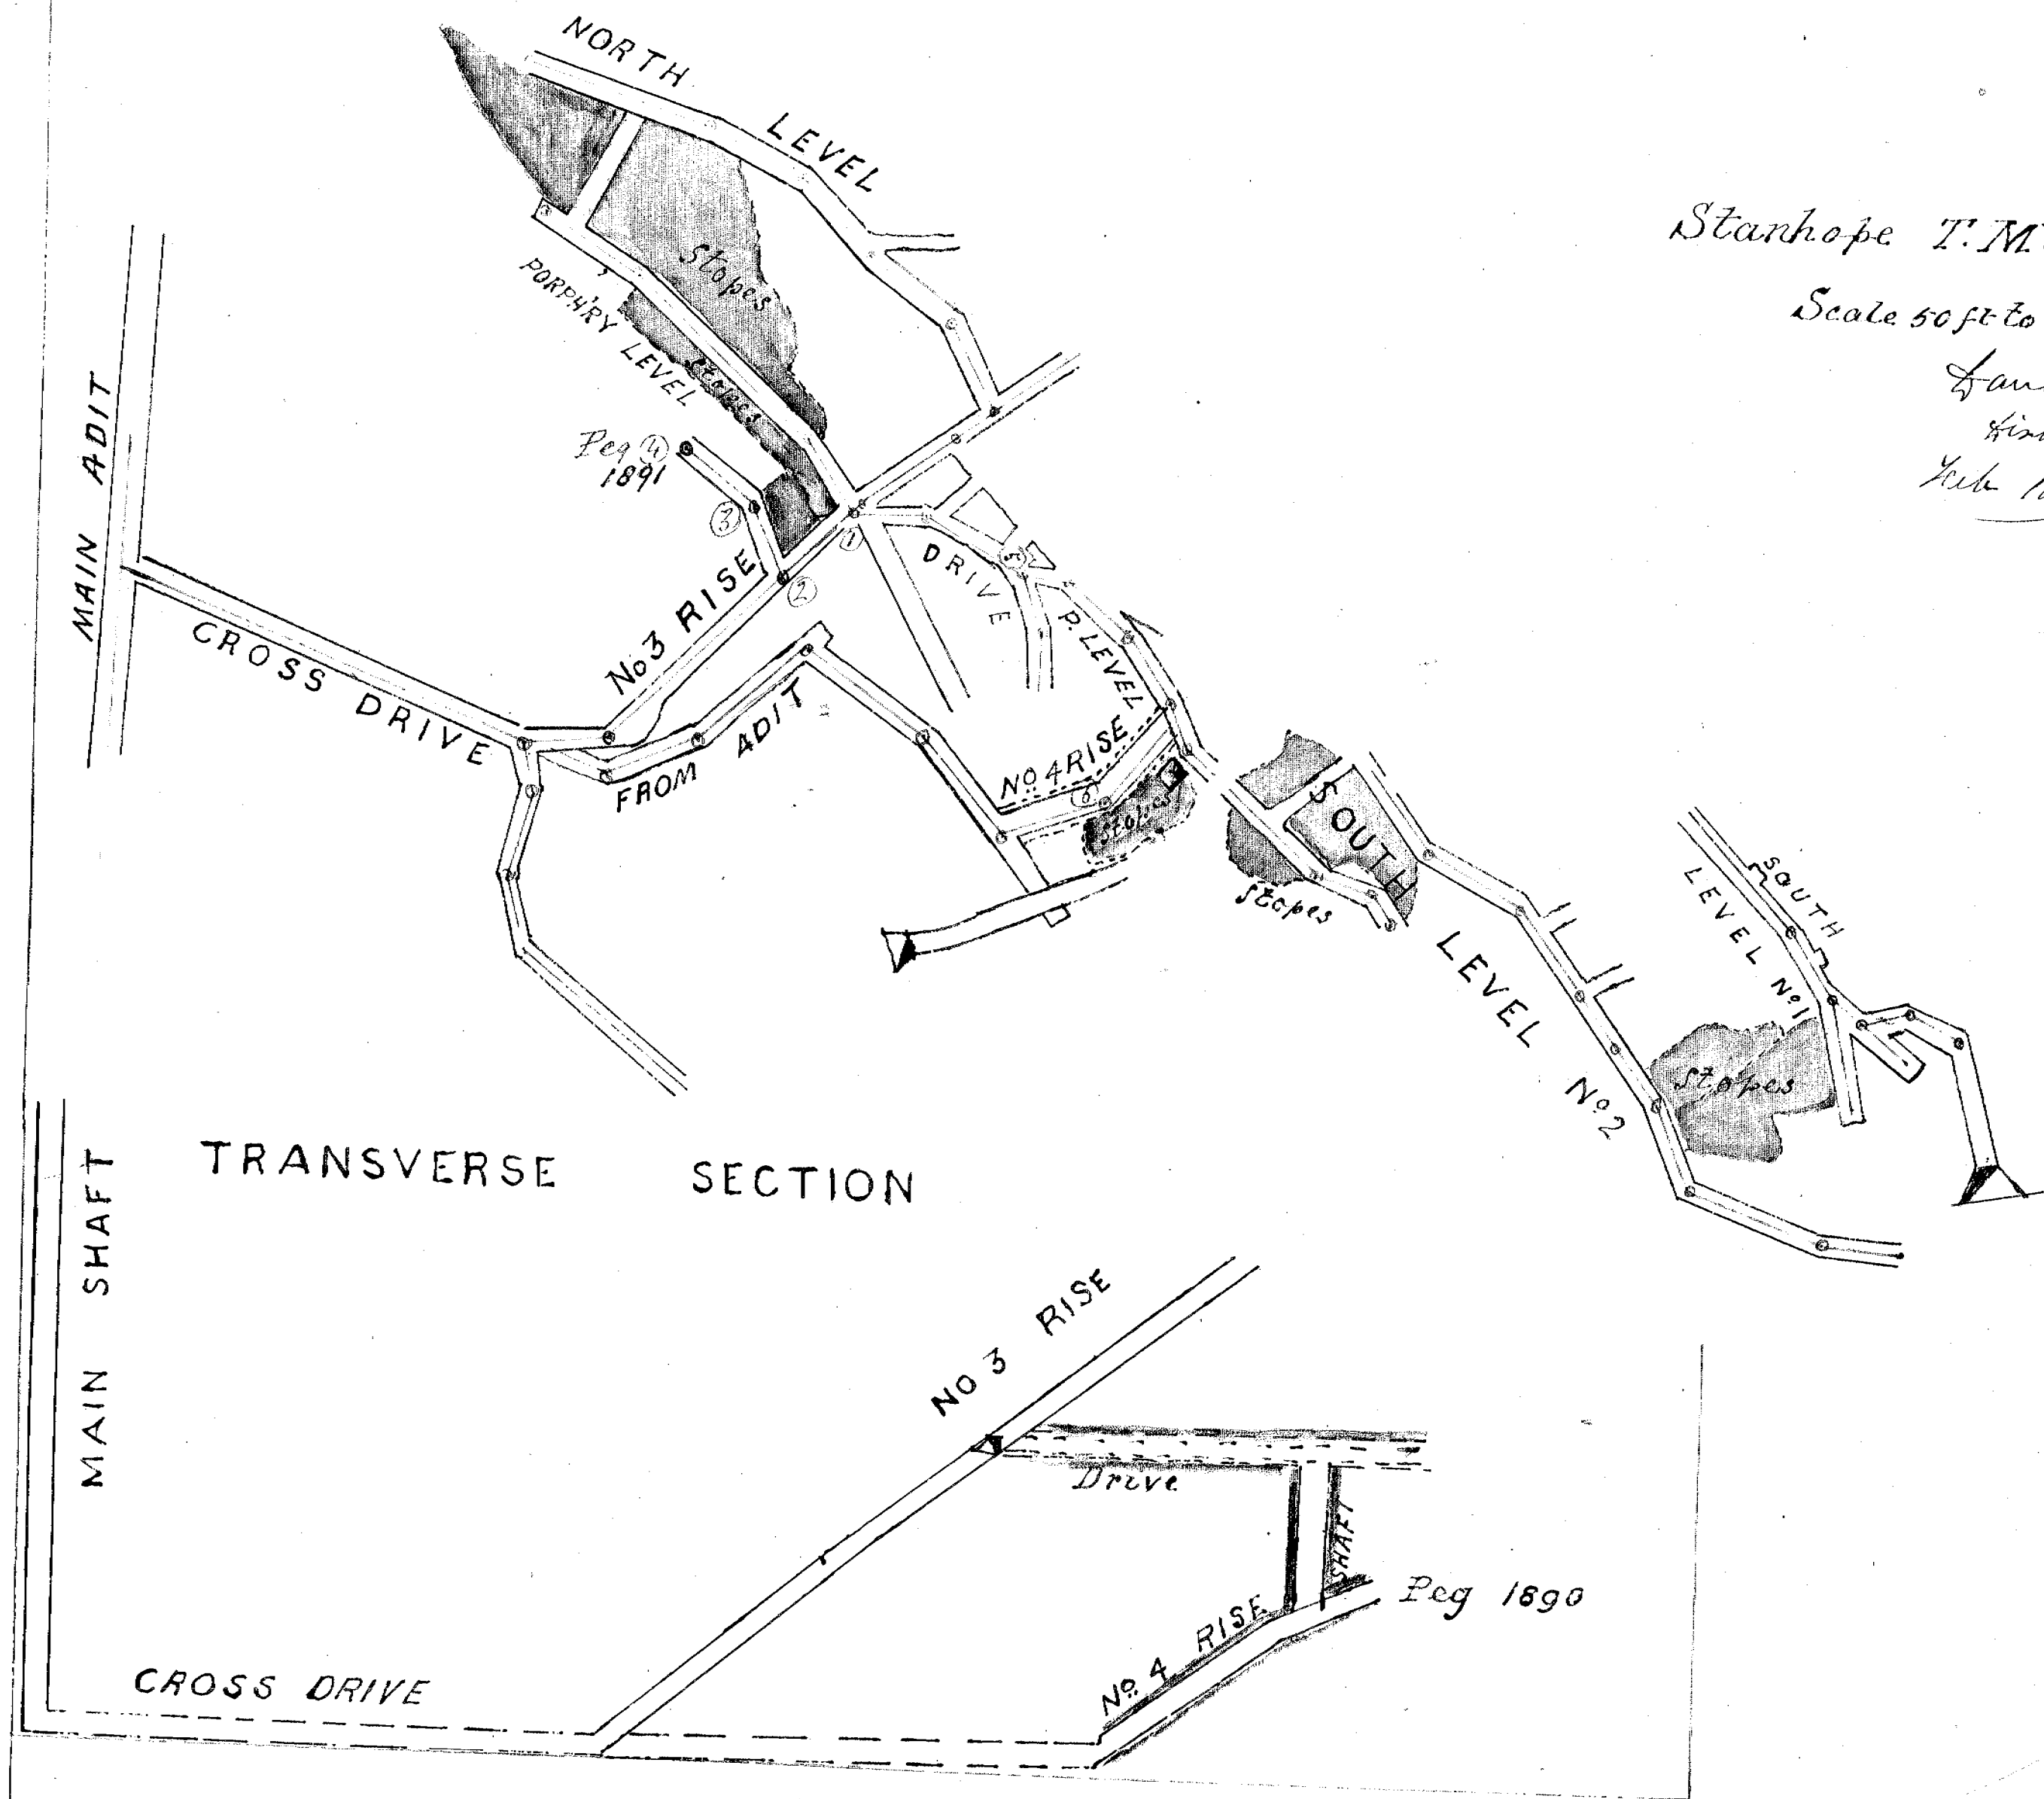


217-270

5 cm

217-270

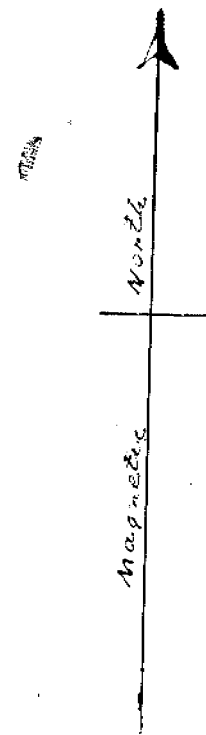

Stanhope T.M. Co.

Scale 50 ft to an Inch

Lavinia Jones,
Miner's Manager
Feb 1891.