


MT. BISCHOFF T.M. CO.

SCALE 25 FT. = 1 IN.

217-271

143' LEVEL

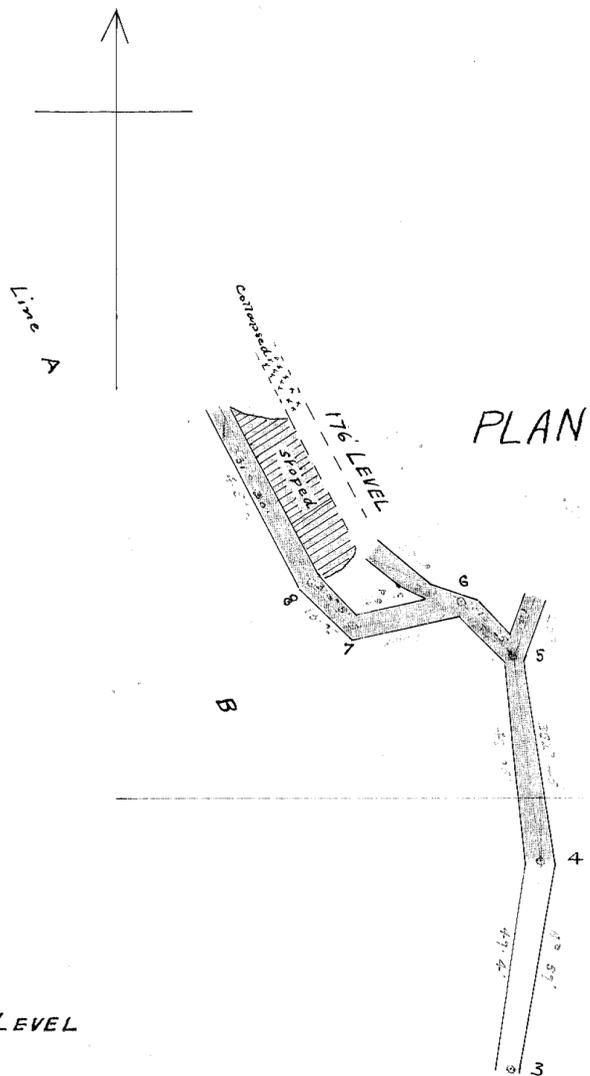

5 cm



Surveyor - J. H. Levinge  
 Inst. used - 4" Theodolite  
 Dec. 31<sup>st</sup> 1927

217-271