


5 cm

27-272

14/2/94

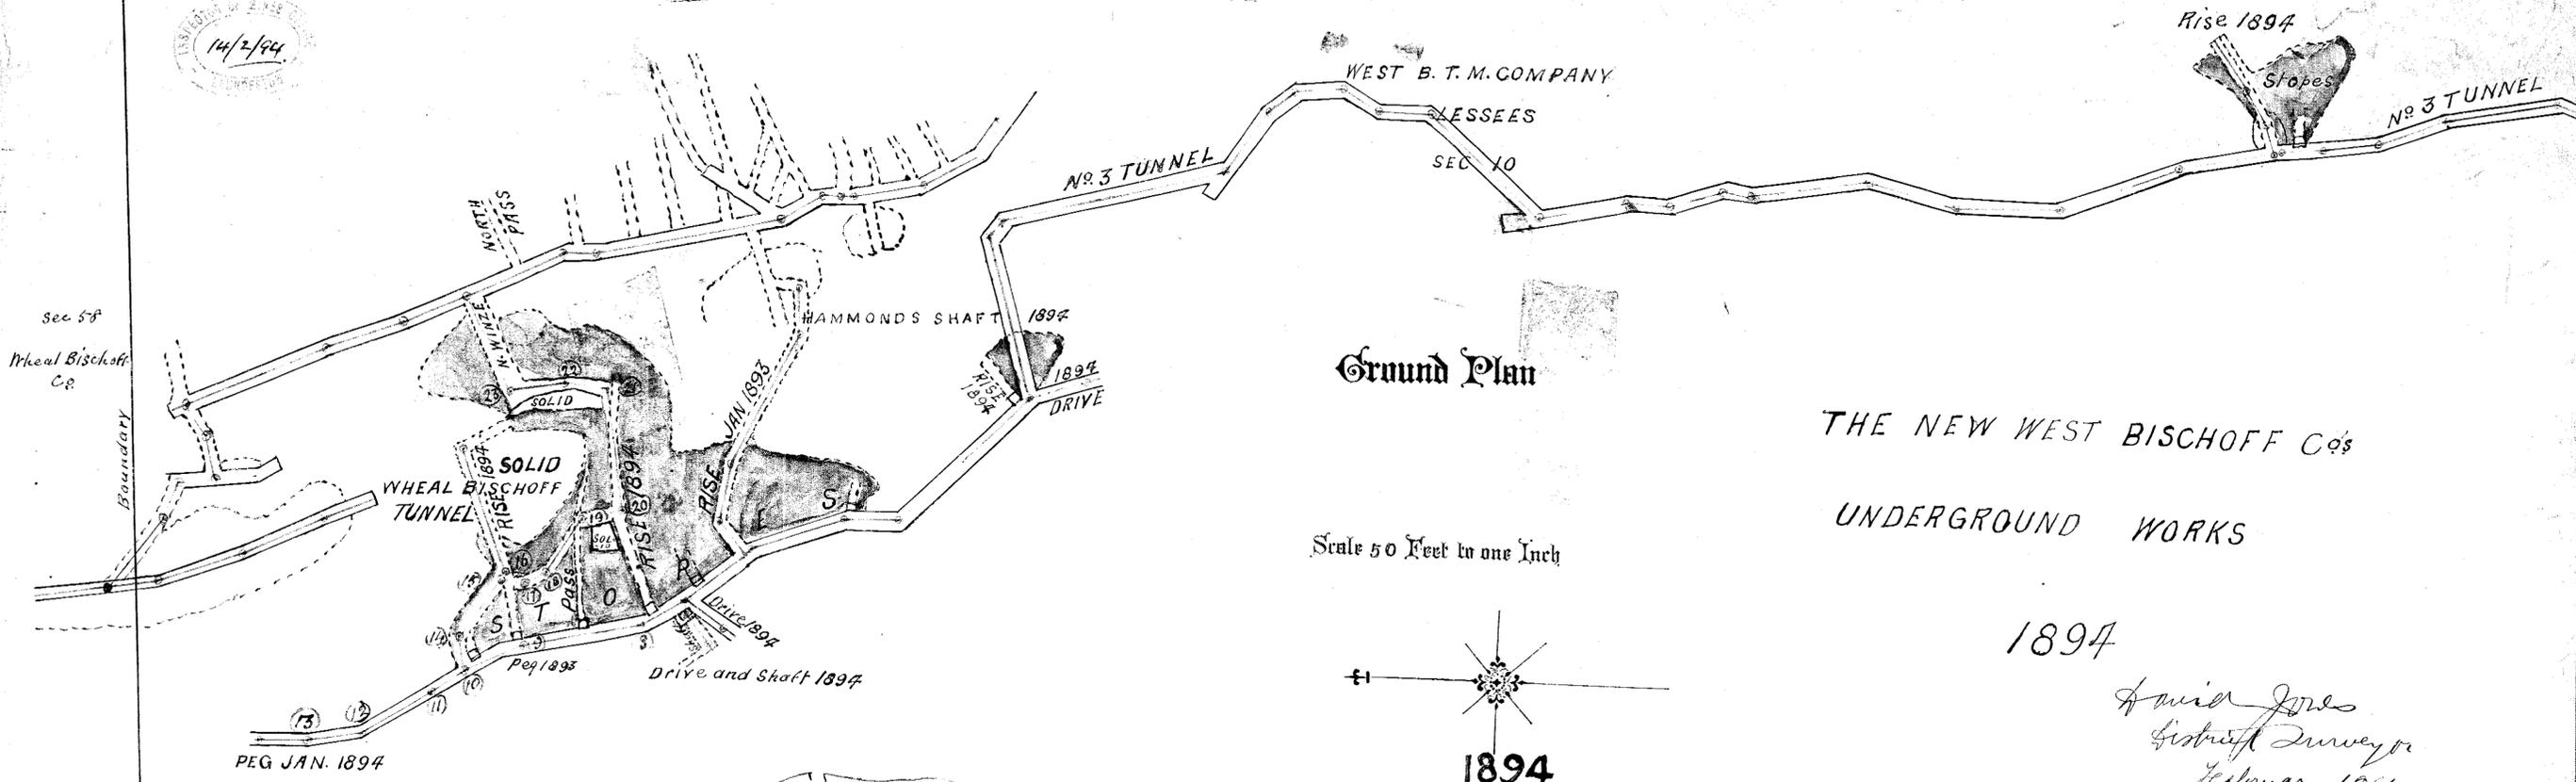


### Ground Plan

THE NEW WEST BISCHOFF Co's  
UNDERGROUND WORKS

1894

*Amiel Jones  
District Surveyor  
February 1894.*

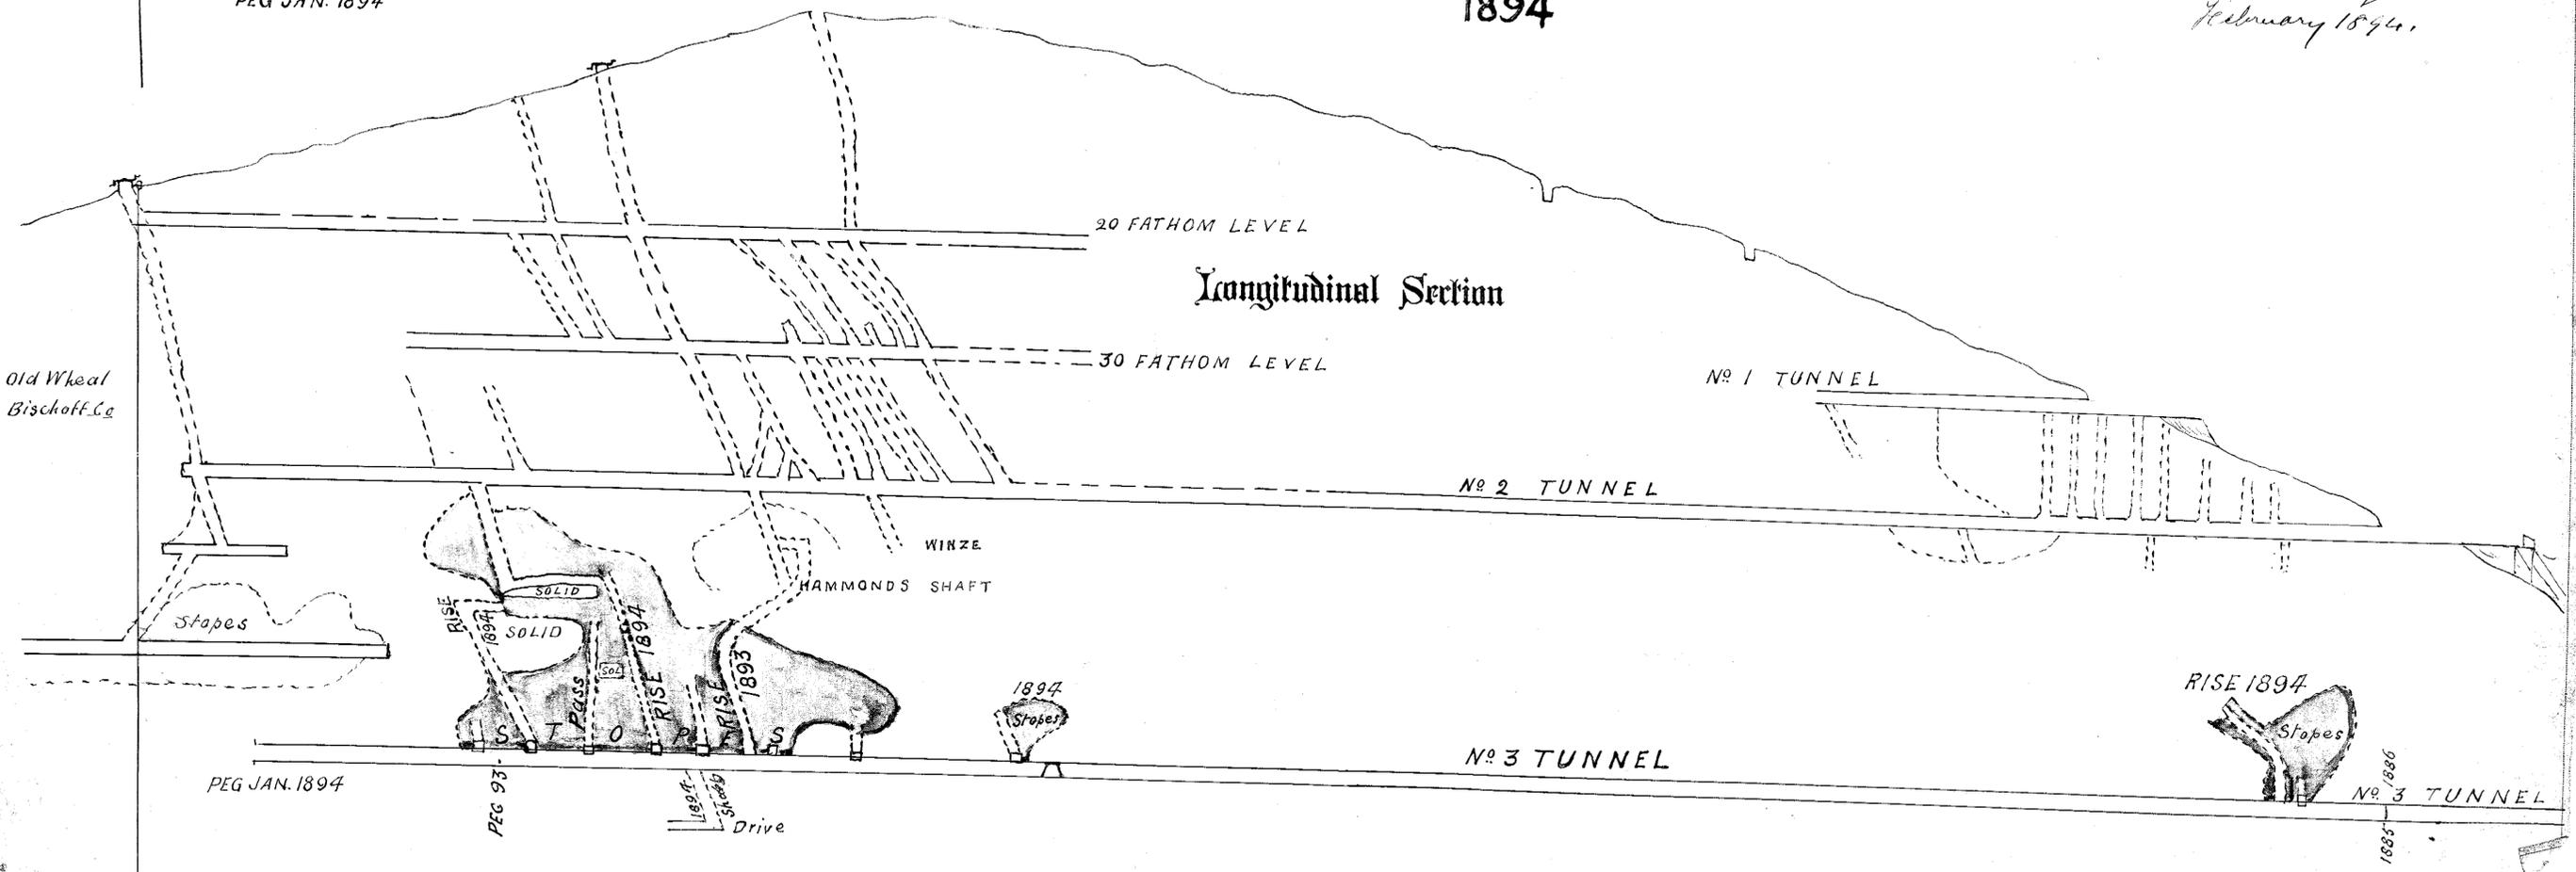

### Longitudinal Section

Old Wheal Bischoff Co.

RISE 1894



1885-1886