 


217-275





Mt. BISCHOFF T. M. Co. Reg.

WHITE FACE


UNDERGROUND WORKINGS TO DEC. 31 1923.

SCALE 25 FT. TO 1 IN.

*McCulloch
Campbell & Sawyer
25-2-24.*

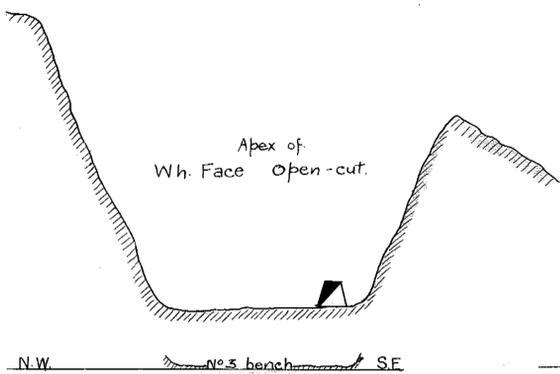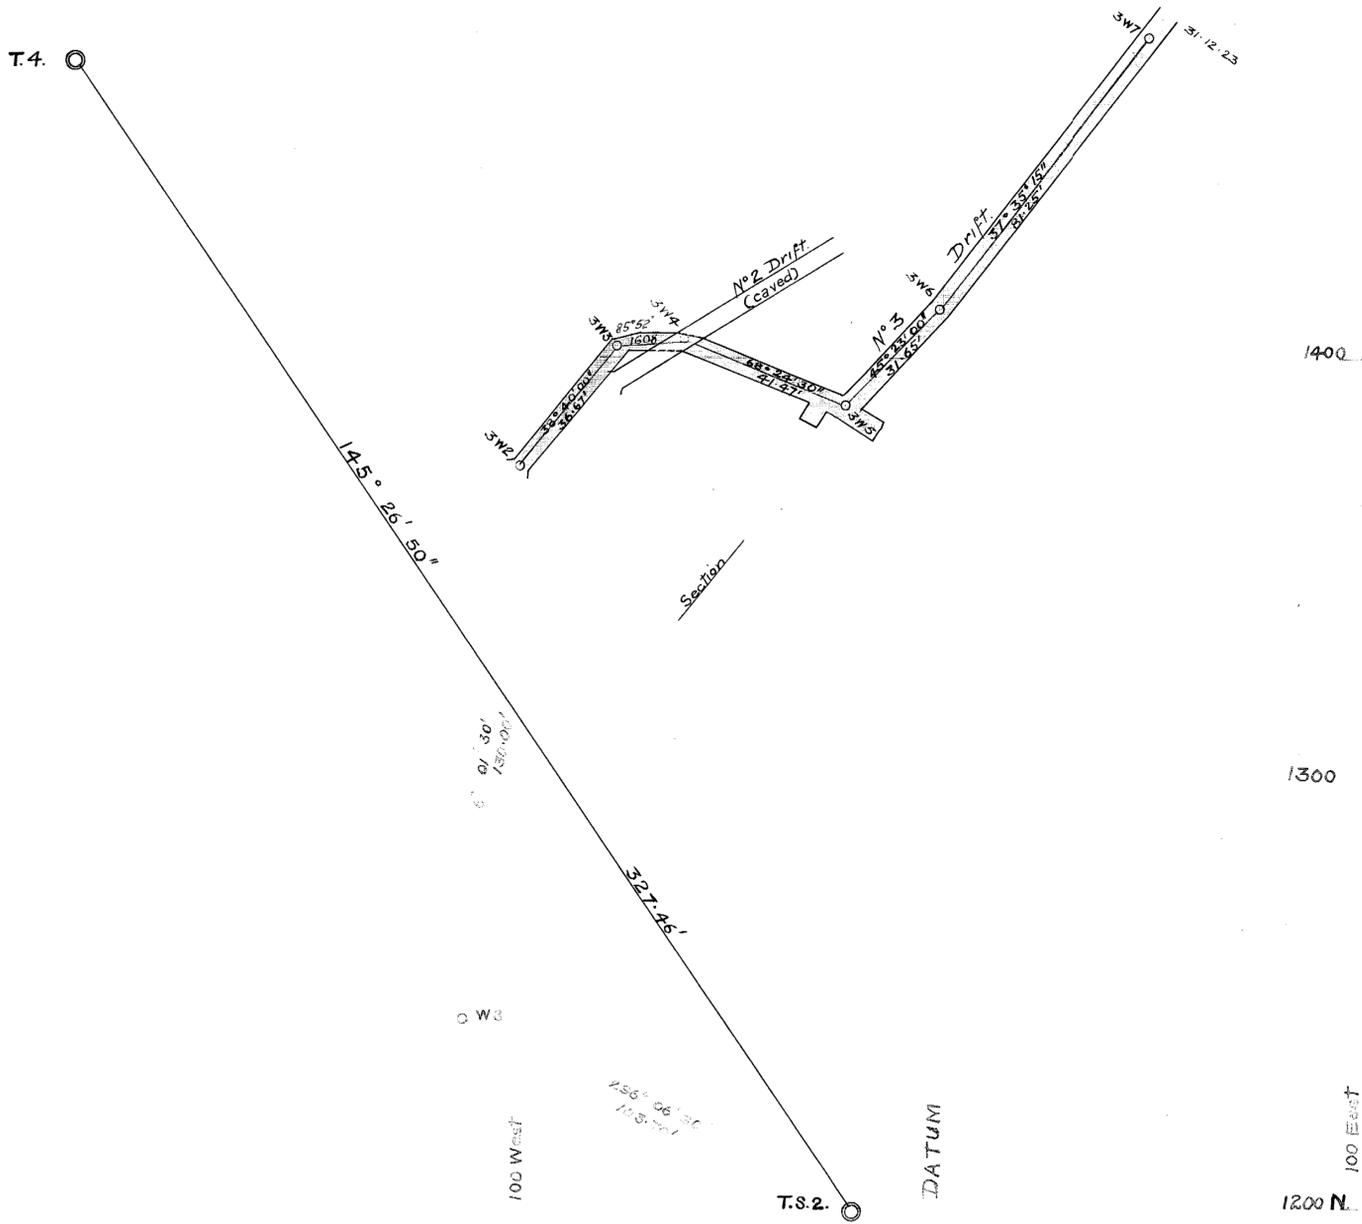

TRANSVERSE SECTION

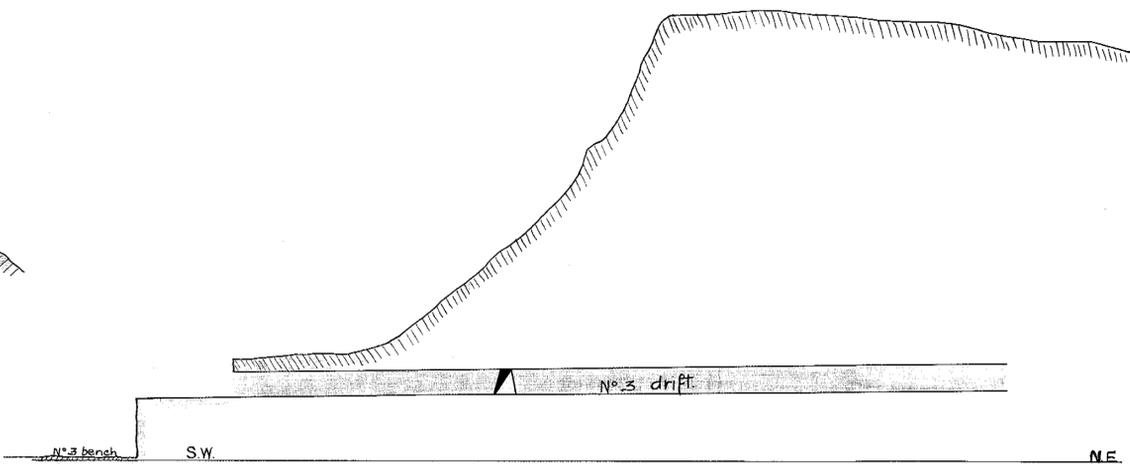

LONGITUDINAL SECTION