


MOUNT BISCHOFF TIN MINE  
 GREISEN LODE  
 MAIN TUNNEL LEVEL  
 Scale: 1 in. = 20 ft.

*R. Harrison* Surveyor, *Manager.* July 1945

217-277

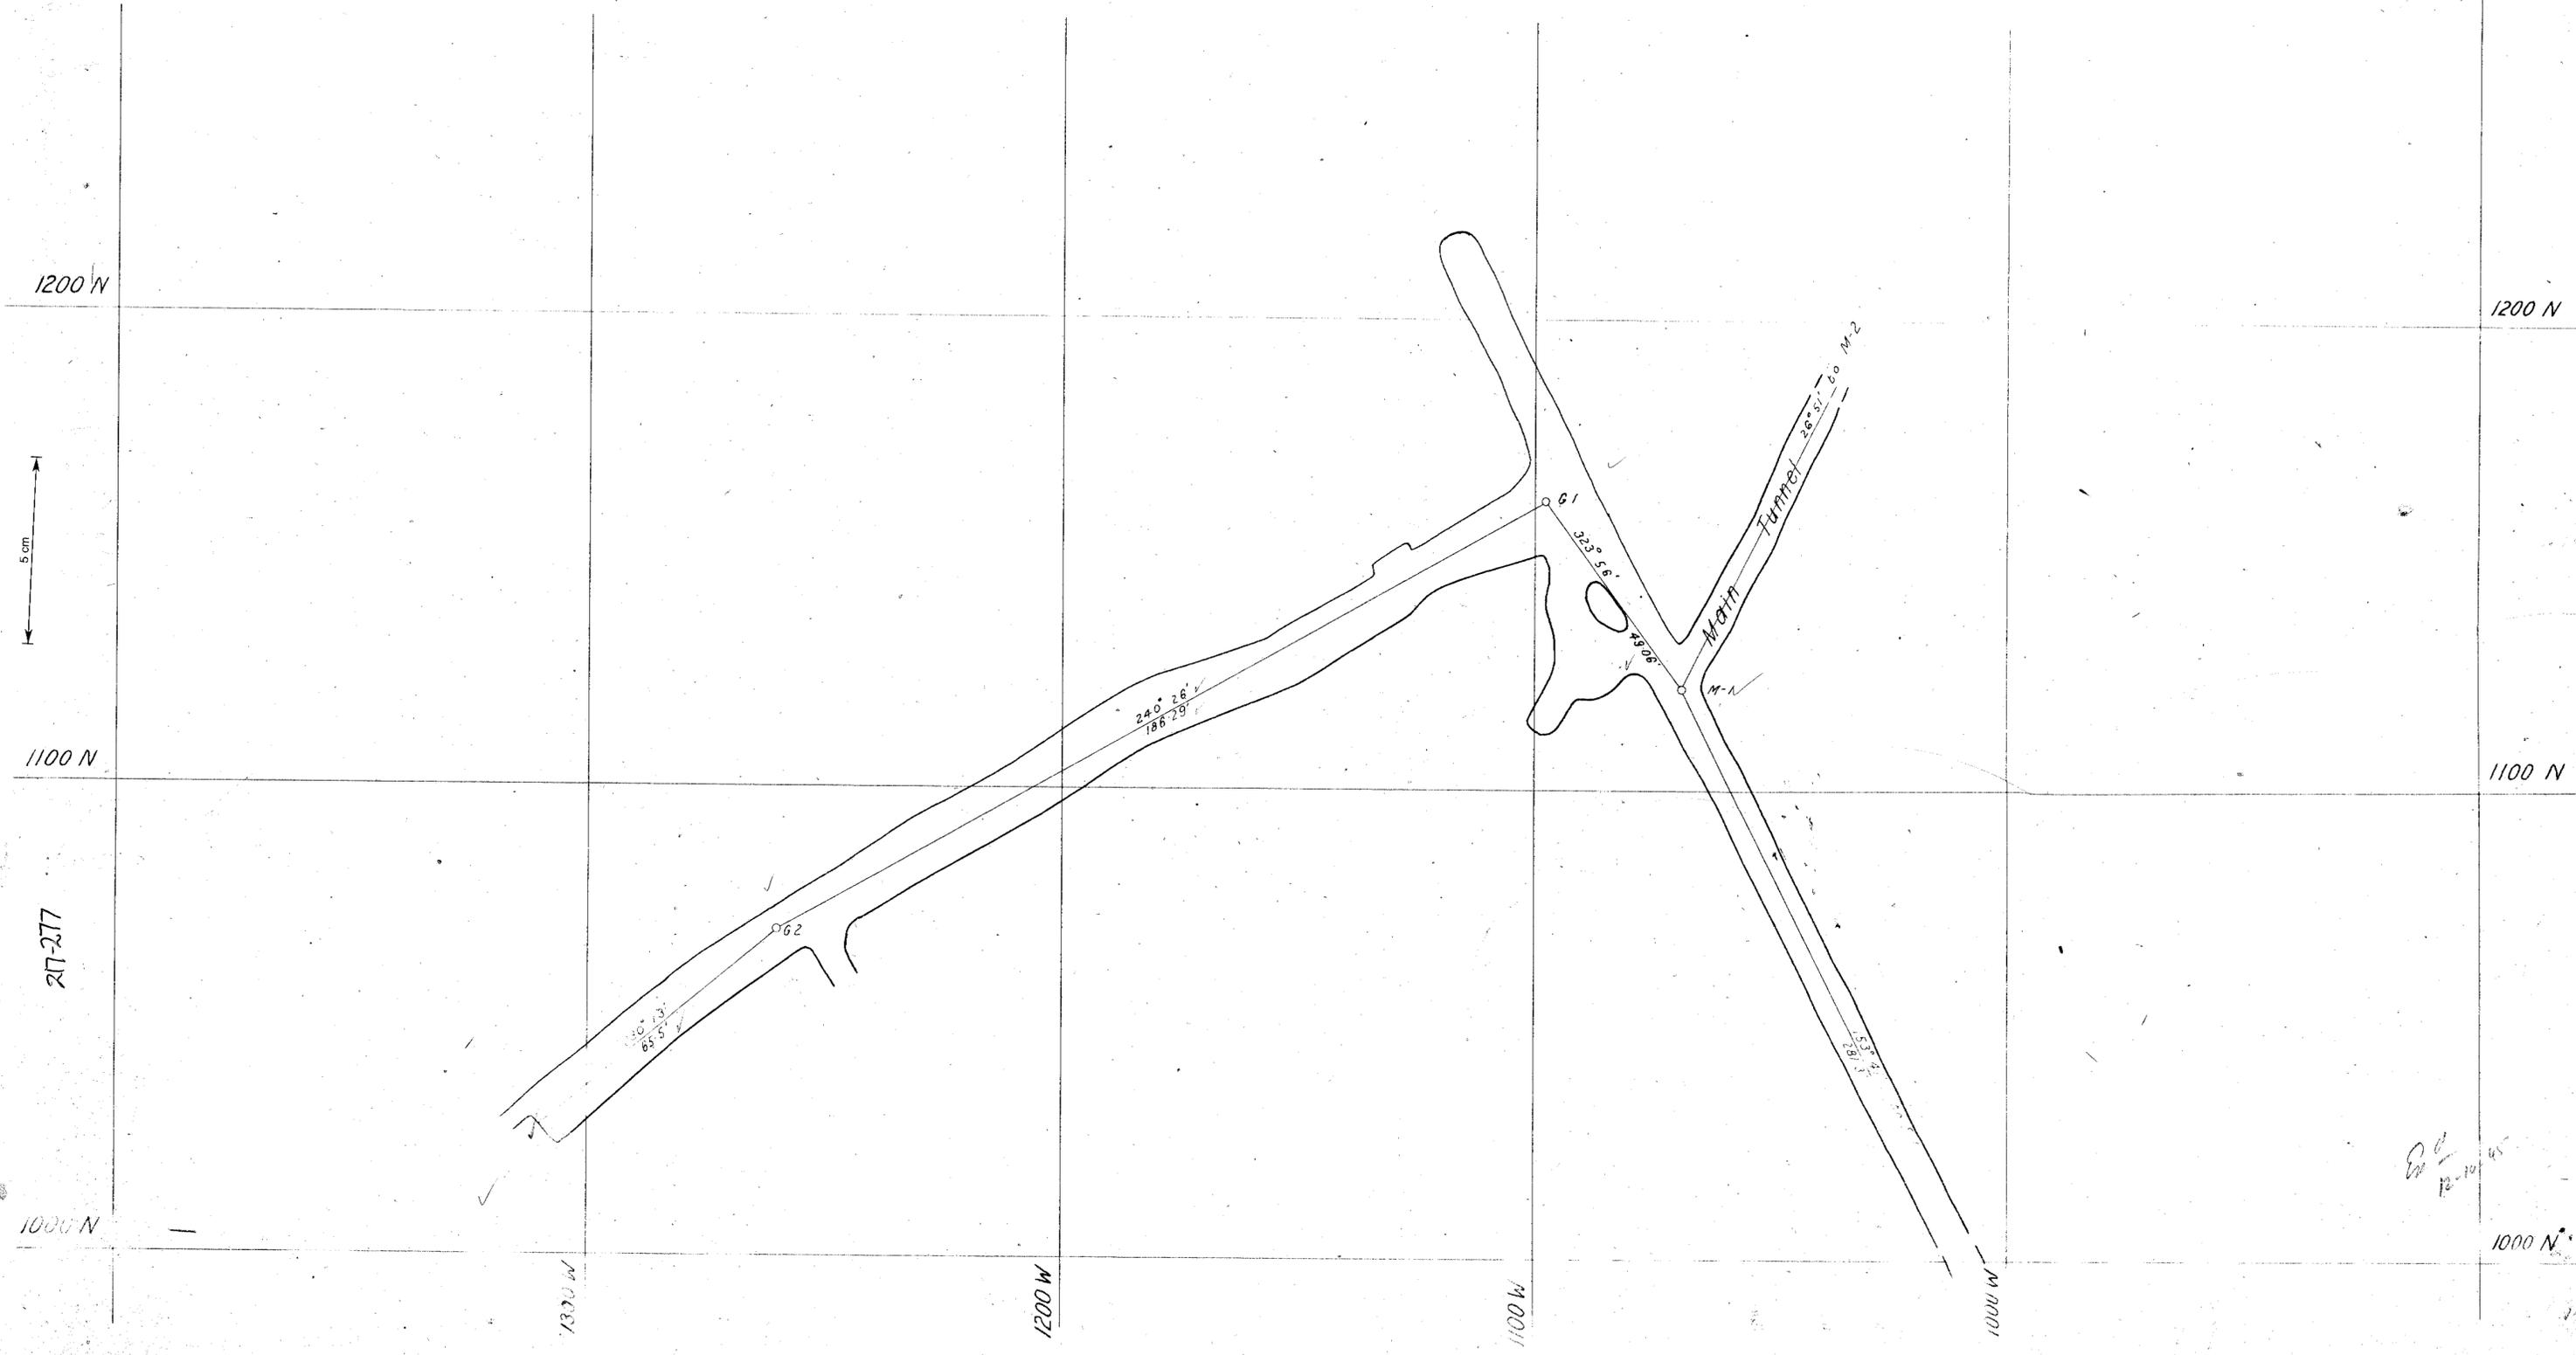

1200 N

1200 N

5 cm

1100 N

1100 N

217-277

1000 N

1000 N

1300 W

1200 W

1100 W

1000 W

*Ed*  
*12-10-45*