

MOUNT BISCHOFF TIN MINE
GREISEN LODE


Stopes from Main Tunnel Level
Scale: 1 in. = 20 ft.

July, 1945.

217-278

5 cm

RL. 1170

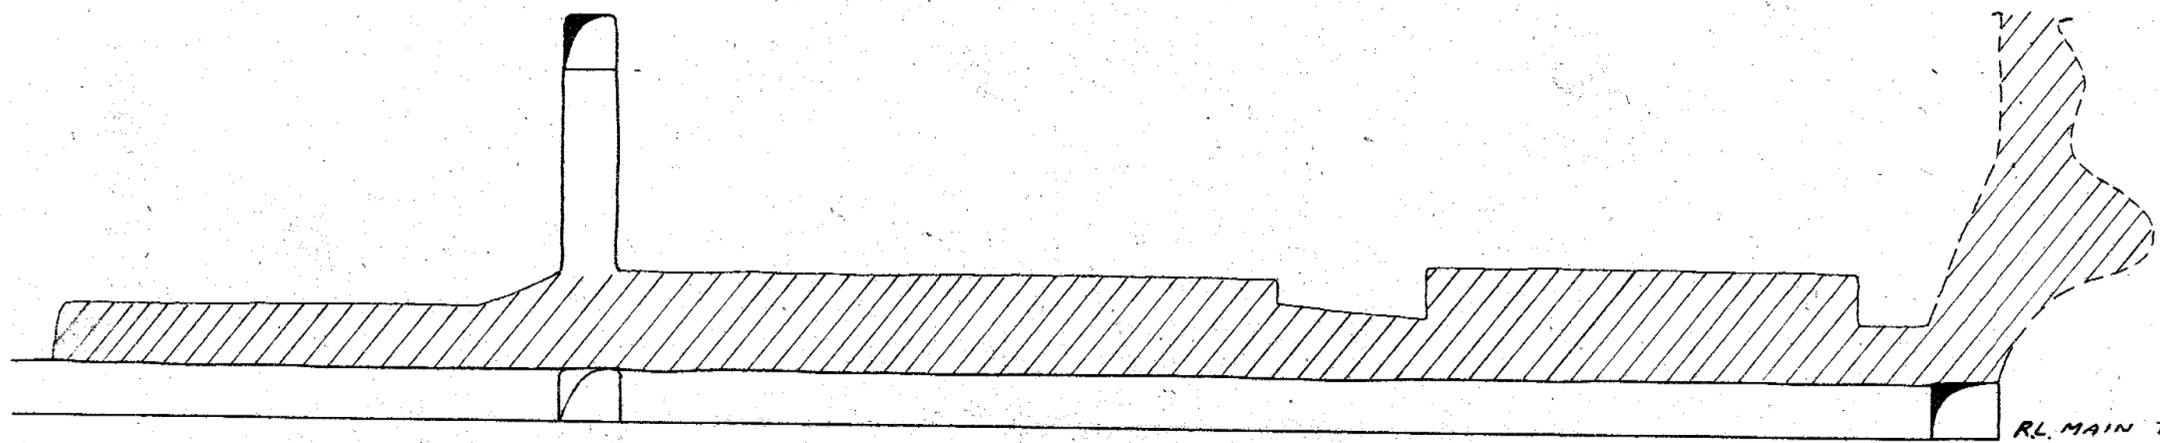

RL. MAIN TUNNEL, 1166

Datum S. 60° W

217-278