


217-282

MOUNT BISCHOFF TIN MINE
GREISEN LODE
Development and Stopes, June 1946
Scale: 1 in. = 20 ft.

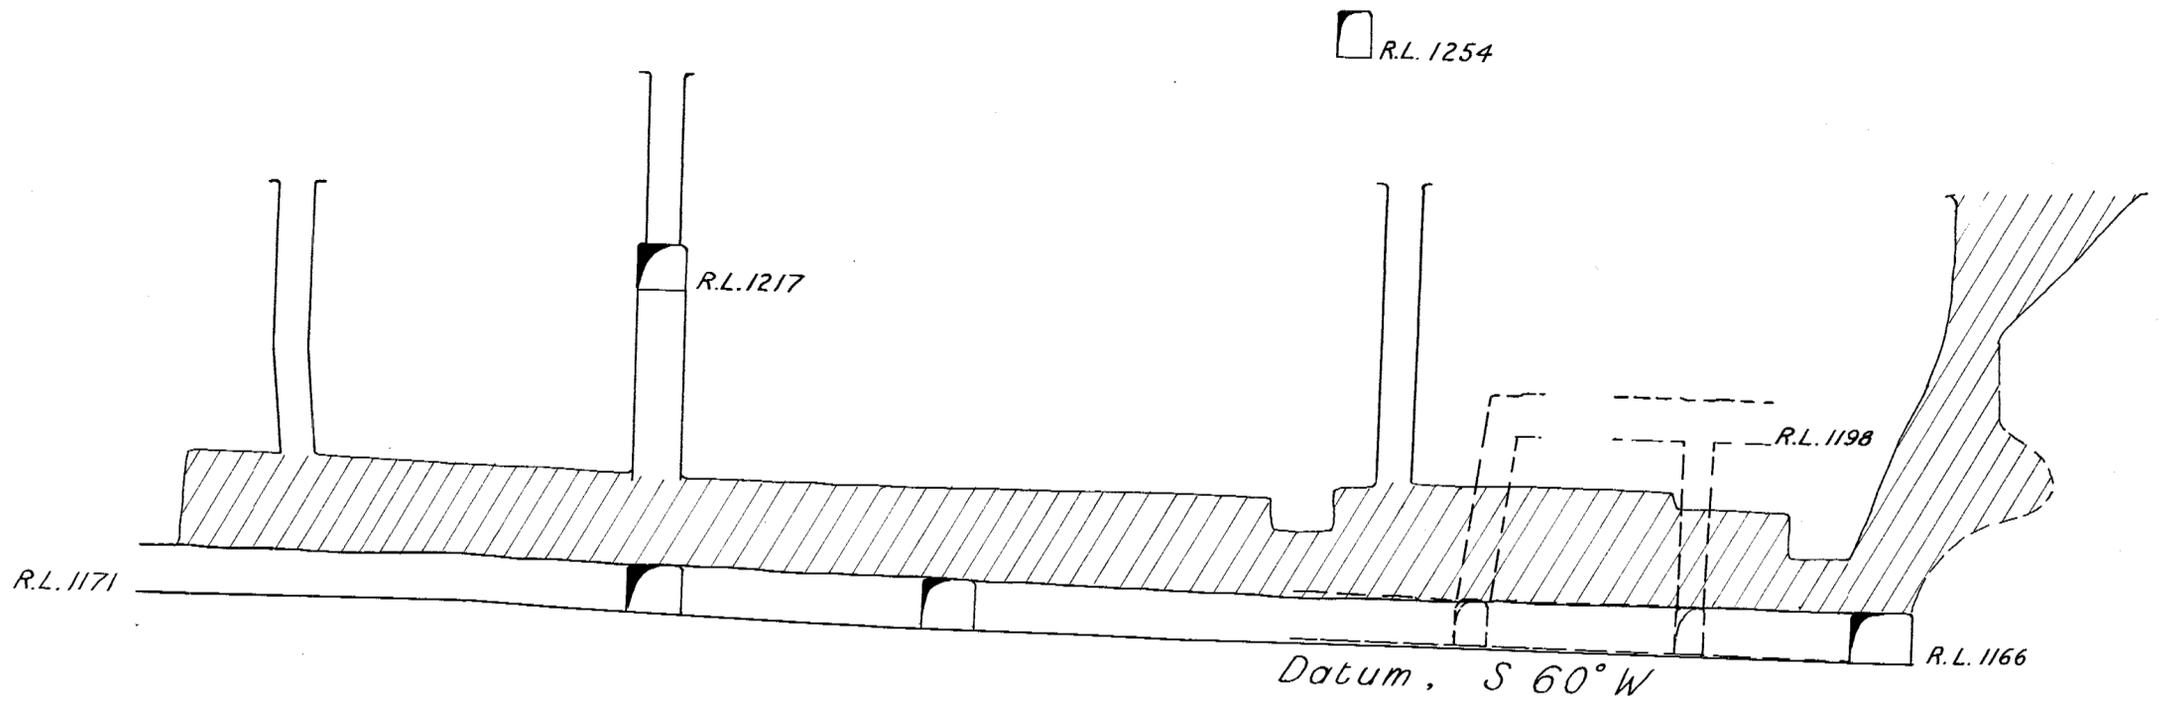

217-282

5 cm