

5 cm

217-290

MT BISCHOFF T. M. C. REG.


WORKINGS ON CROSS LODGE AND FLAT MAKE

TRANSVERSE SECTION

Surface

Scale - 25 FT to 1 INCH

1927.

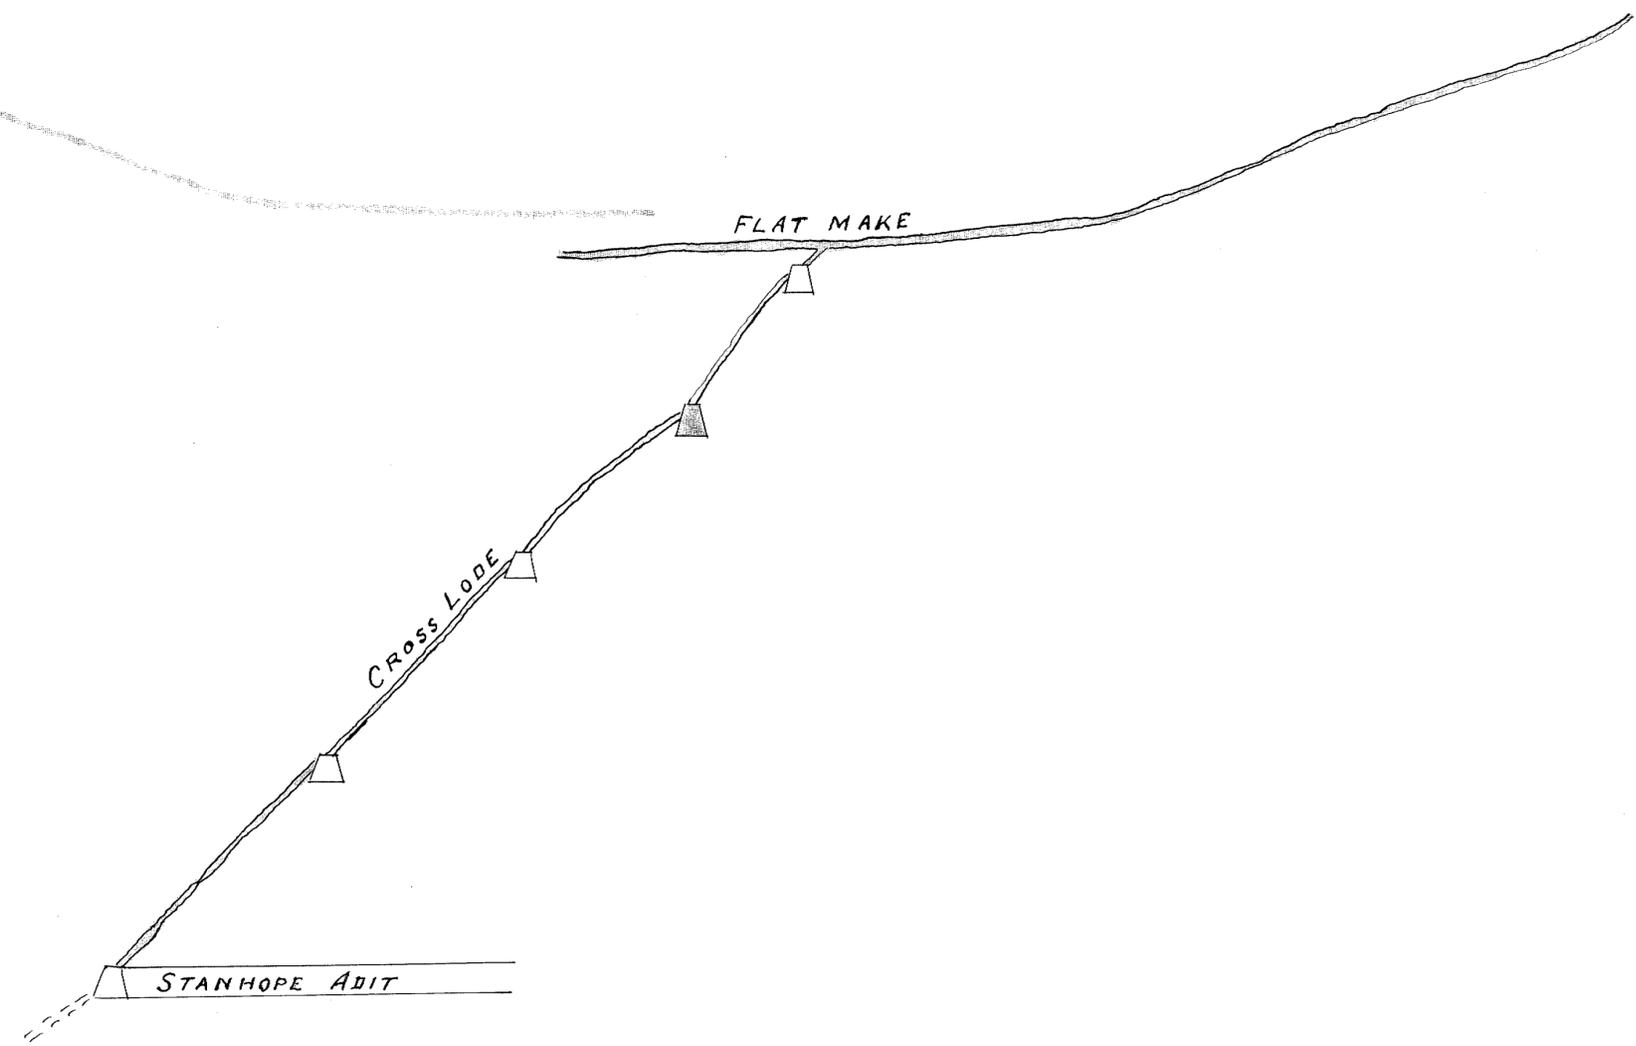

217-290