

5 cm

217-291

- MT BISCHOFF T. M. CO. REG. -


- QUEEN WORKINGS -

UNDERGROUND WORKINGS FOR YEAR ENDING 31.12.25.


- Scale 25 Feet to 1 Inch -

J. H. Lewis
General Manager

Date
Feb 15th 1926.

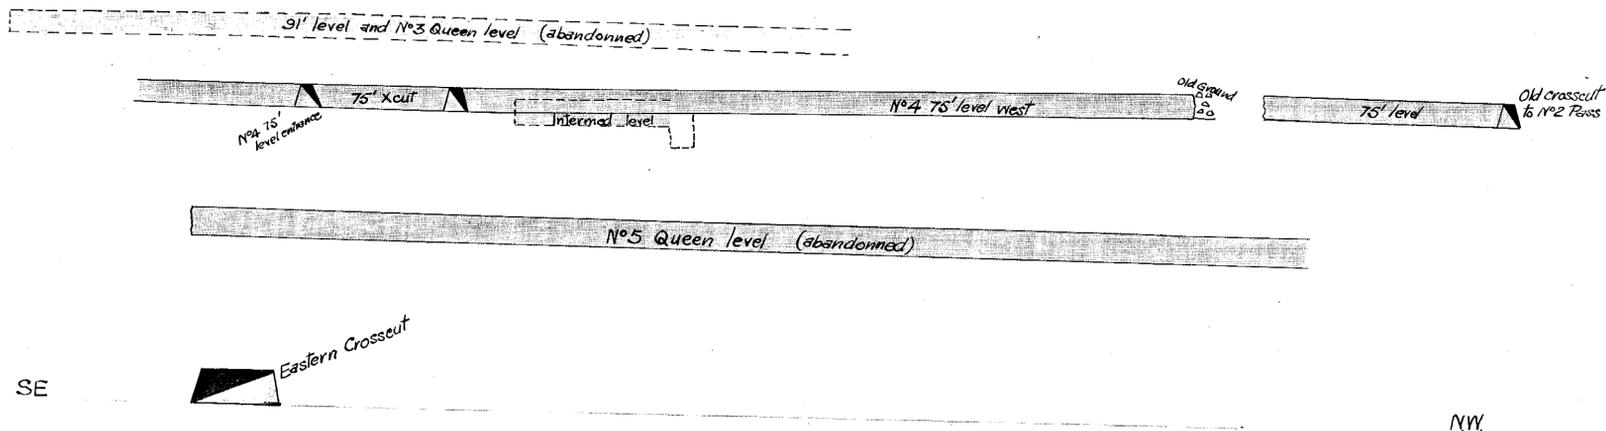

Longitudinal Section

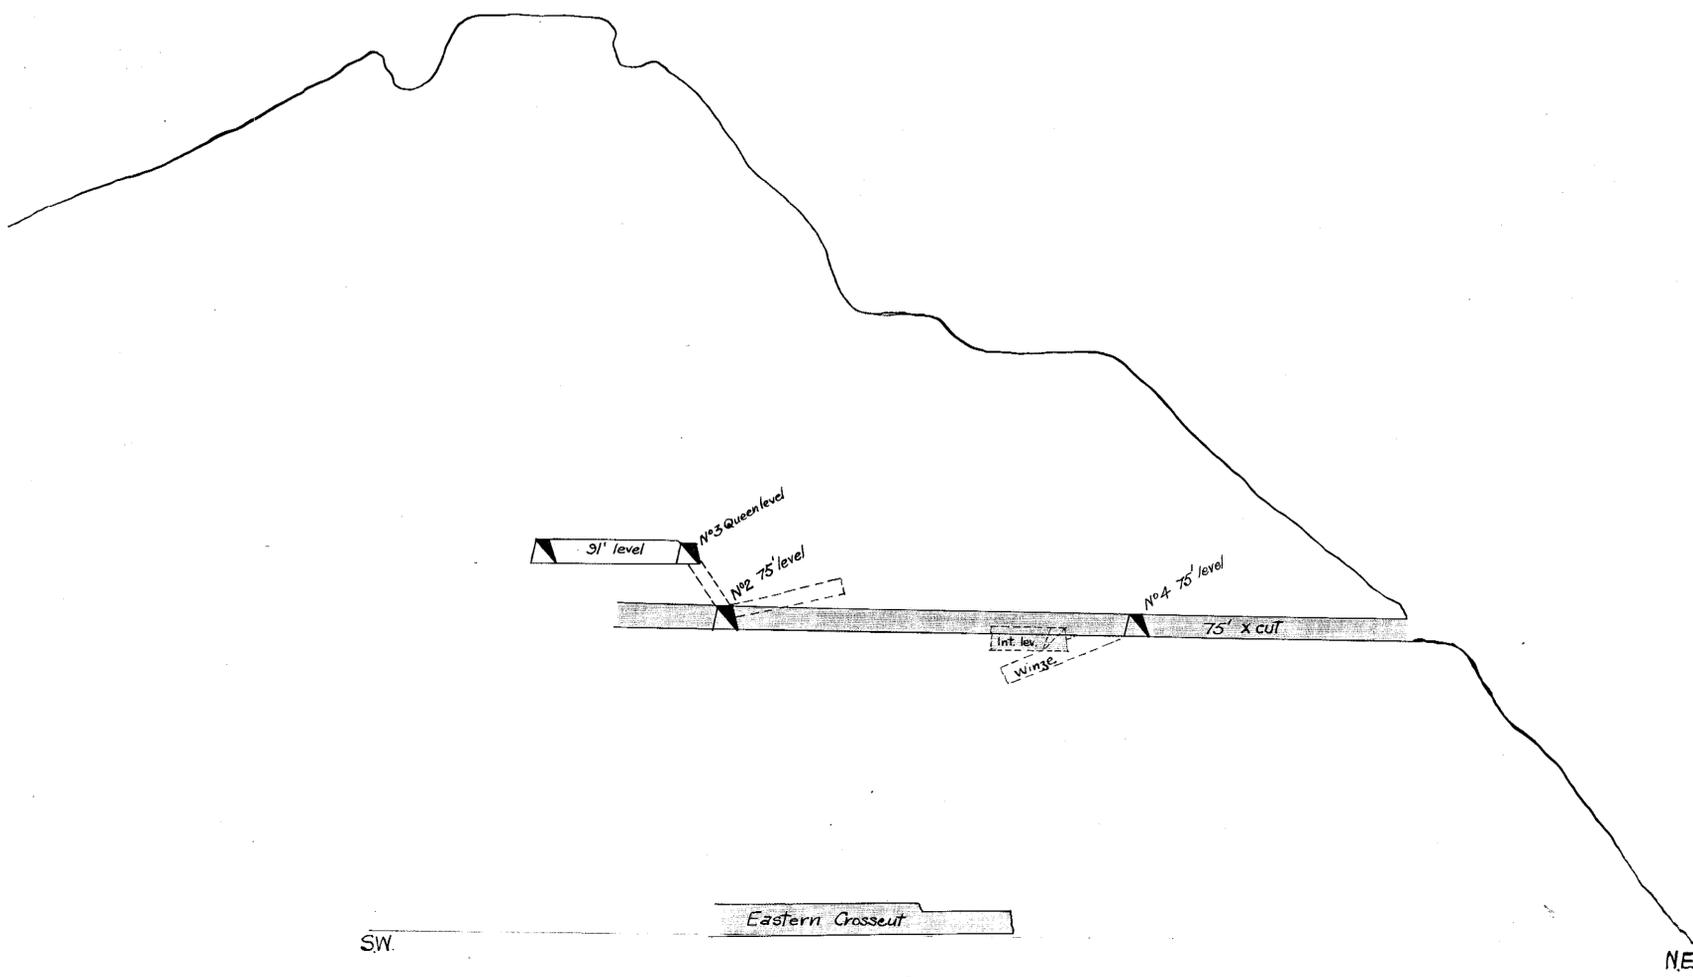

Transverse Section