


5 cm

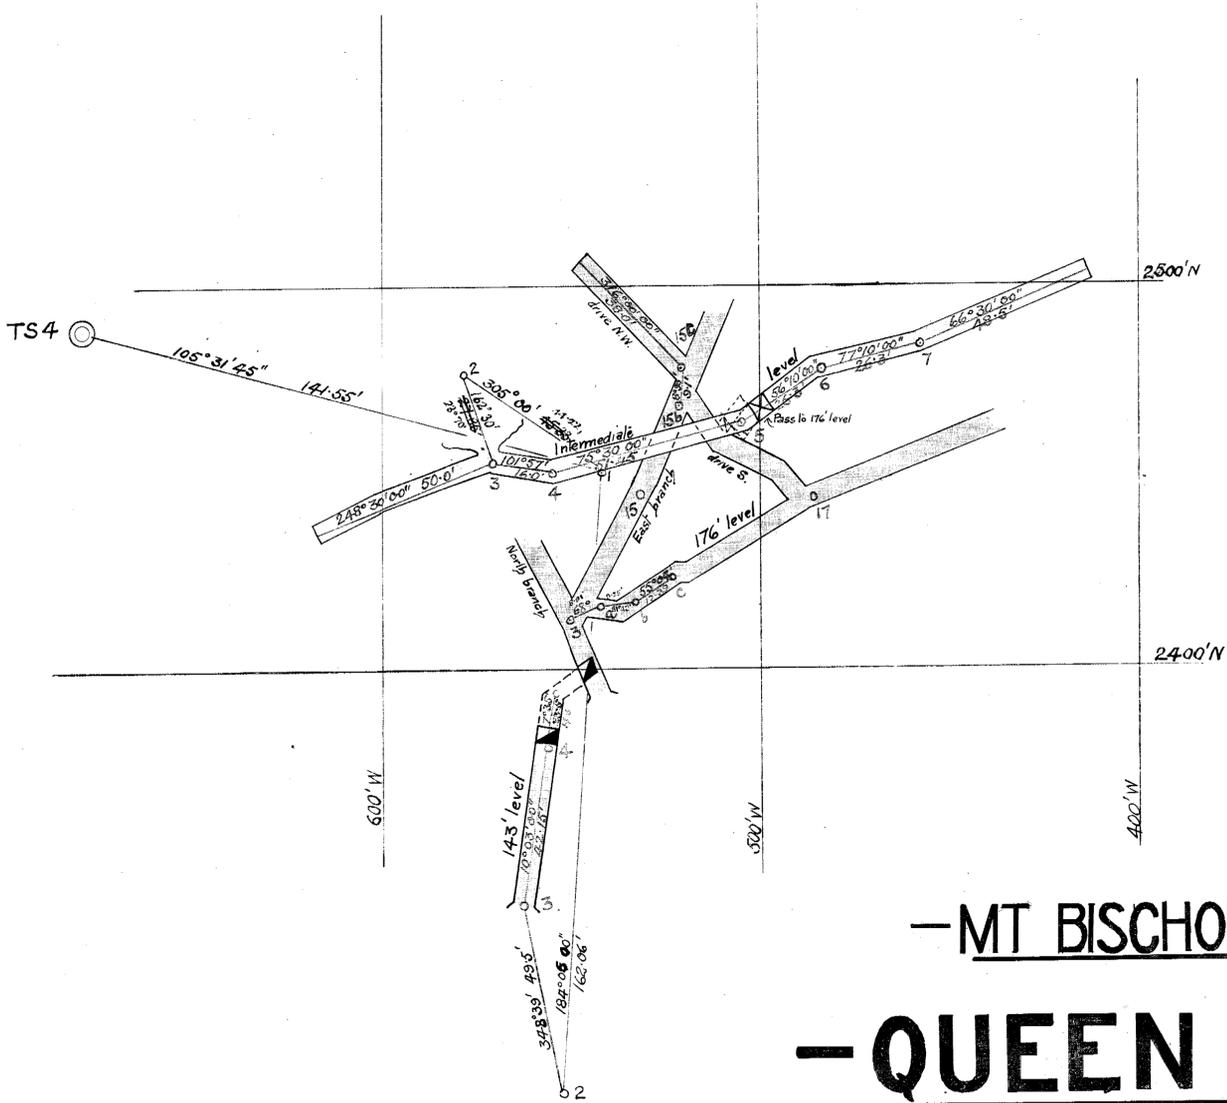


— MT BISCHOFF T. M. CO. REG. —
— QUEEN WORKINGS —

UNDERGROUND WORKINGS FOR YEAR ENDING 31.12.25.


— Scale 25 Feet to 1 Inch —

— J. H. Fowings —
 General Manager

— Date —
 Feb. 11th 1926

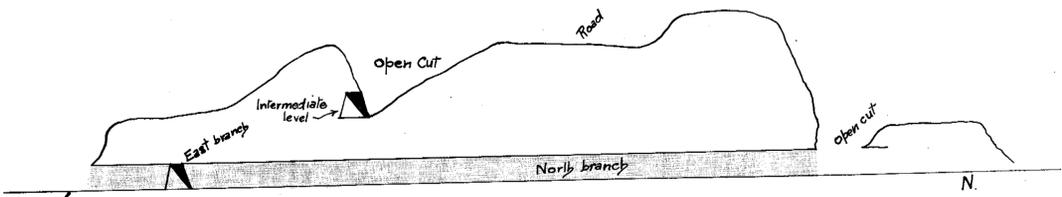

Longitudinal Section
along North Branch
 Transverse across Intermediate level.

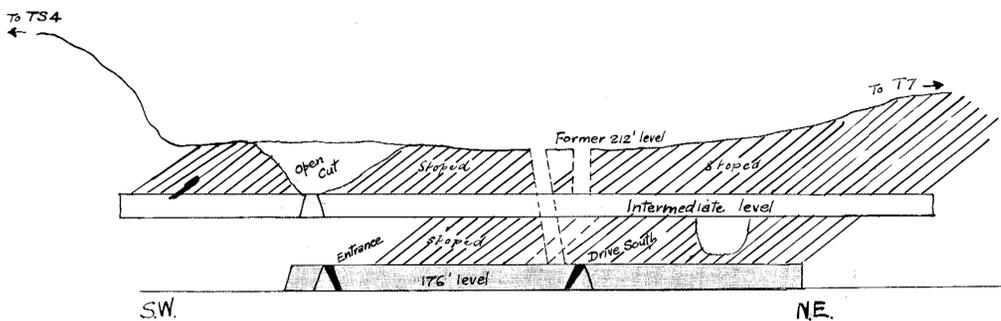

Longitudinal Section Intermediate Level