

Nº 9
80 A



BOUNDARY LINE

Nº 36

80 A

MT B. T. M. Cos N. L.
Underground Works
30 feet = 1 inch.

Waratah.
30: 1: 1901.
J. J. J. J. J.
J. J. J. J. J.

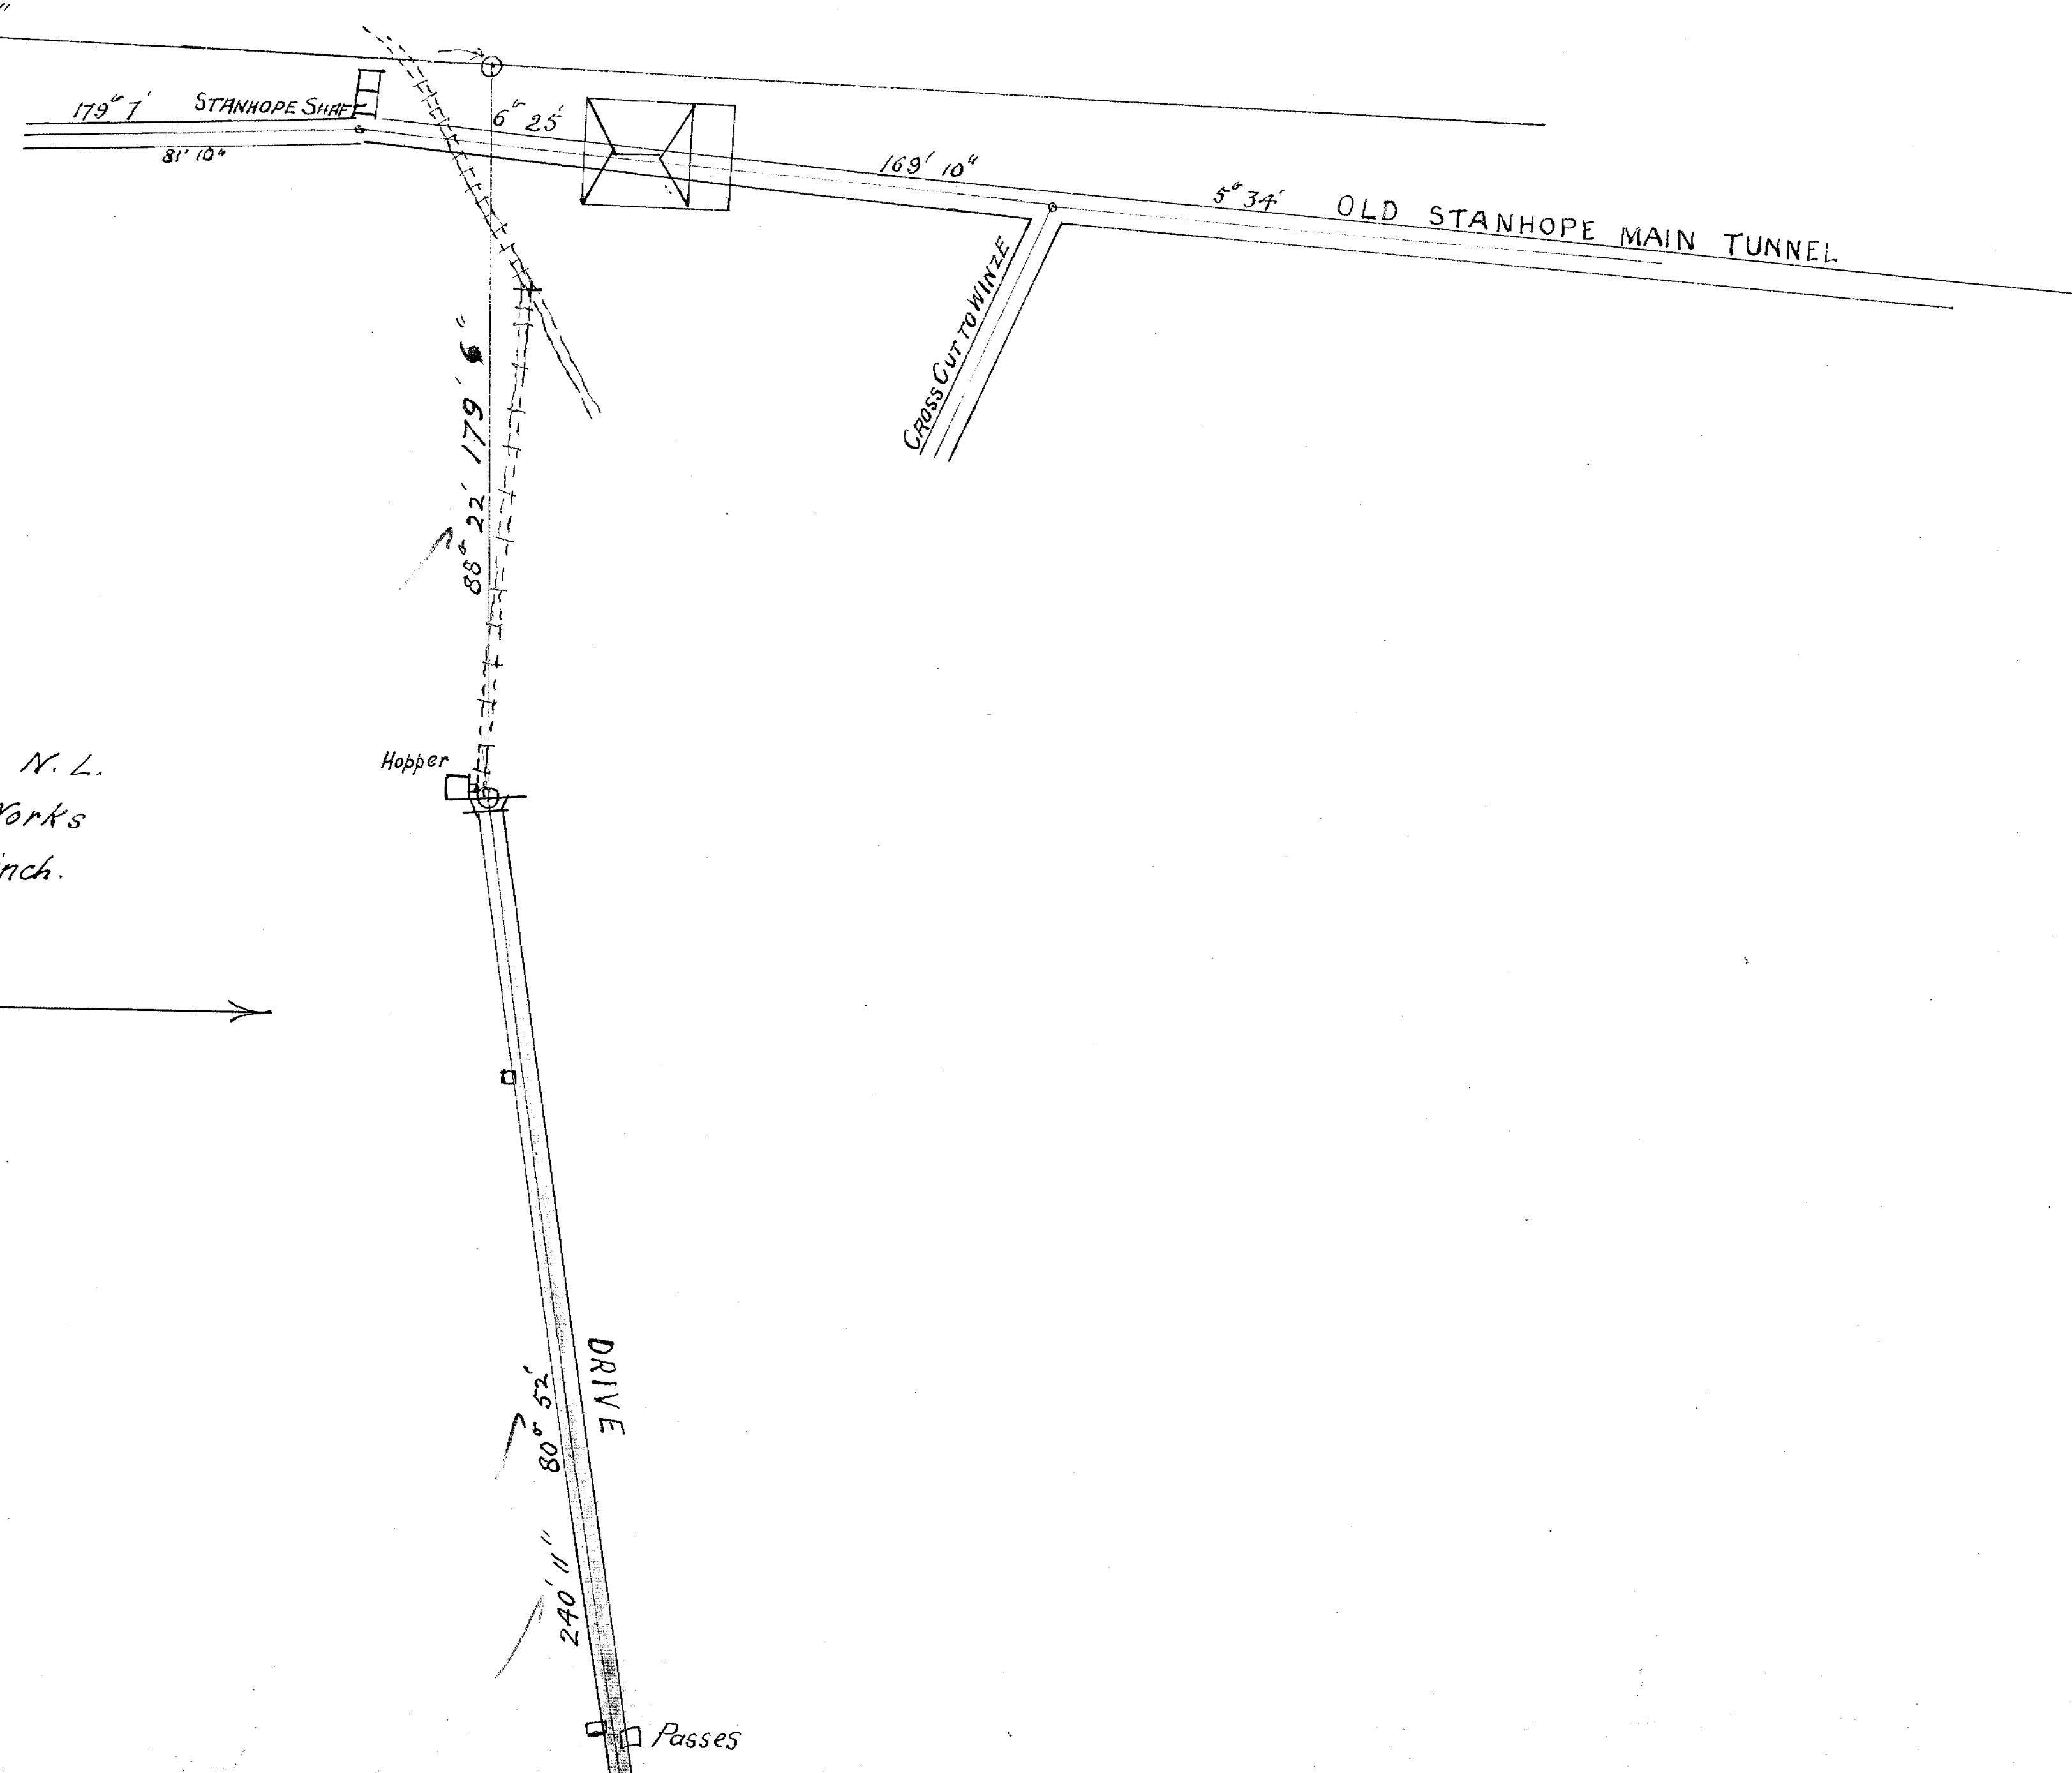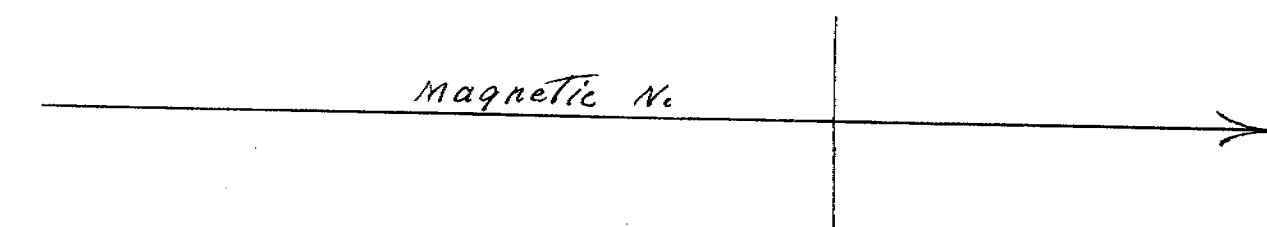

217-296

5 cm

217-296

1001
J. J. J. J. J.
J. J. J. J. J.