


— W^t Bischoff, I. 956. C^o. Reg. —

— **STANHOPE WORKINGS** —

— LONGITUDINAL SECTION —

— Scale 50F^t to 1 Inch —

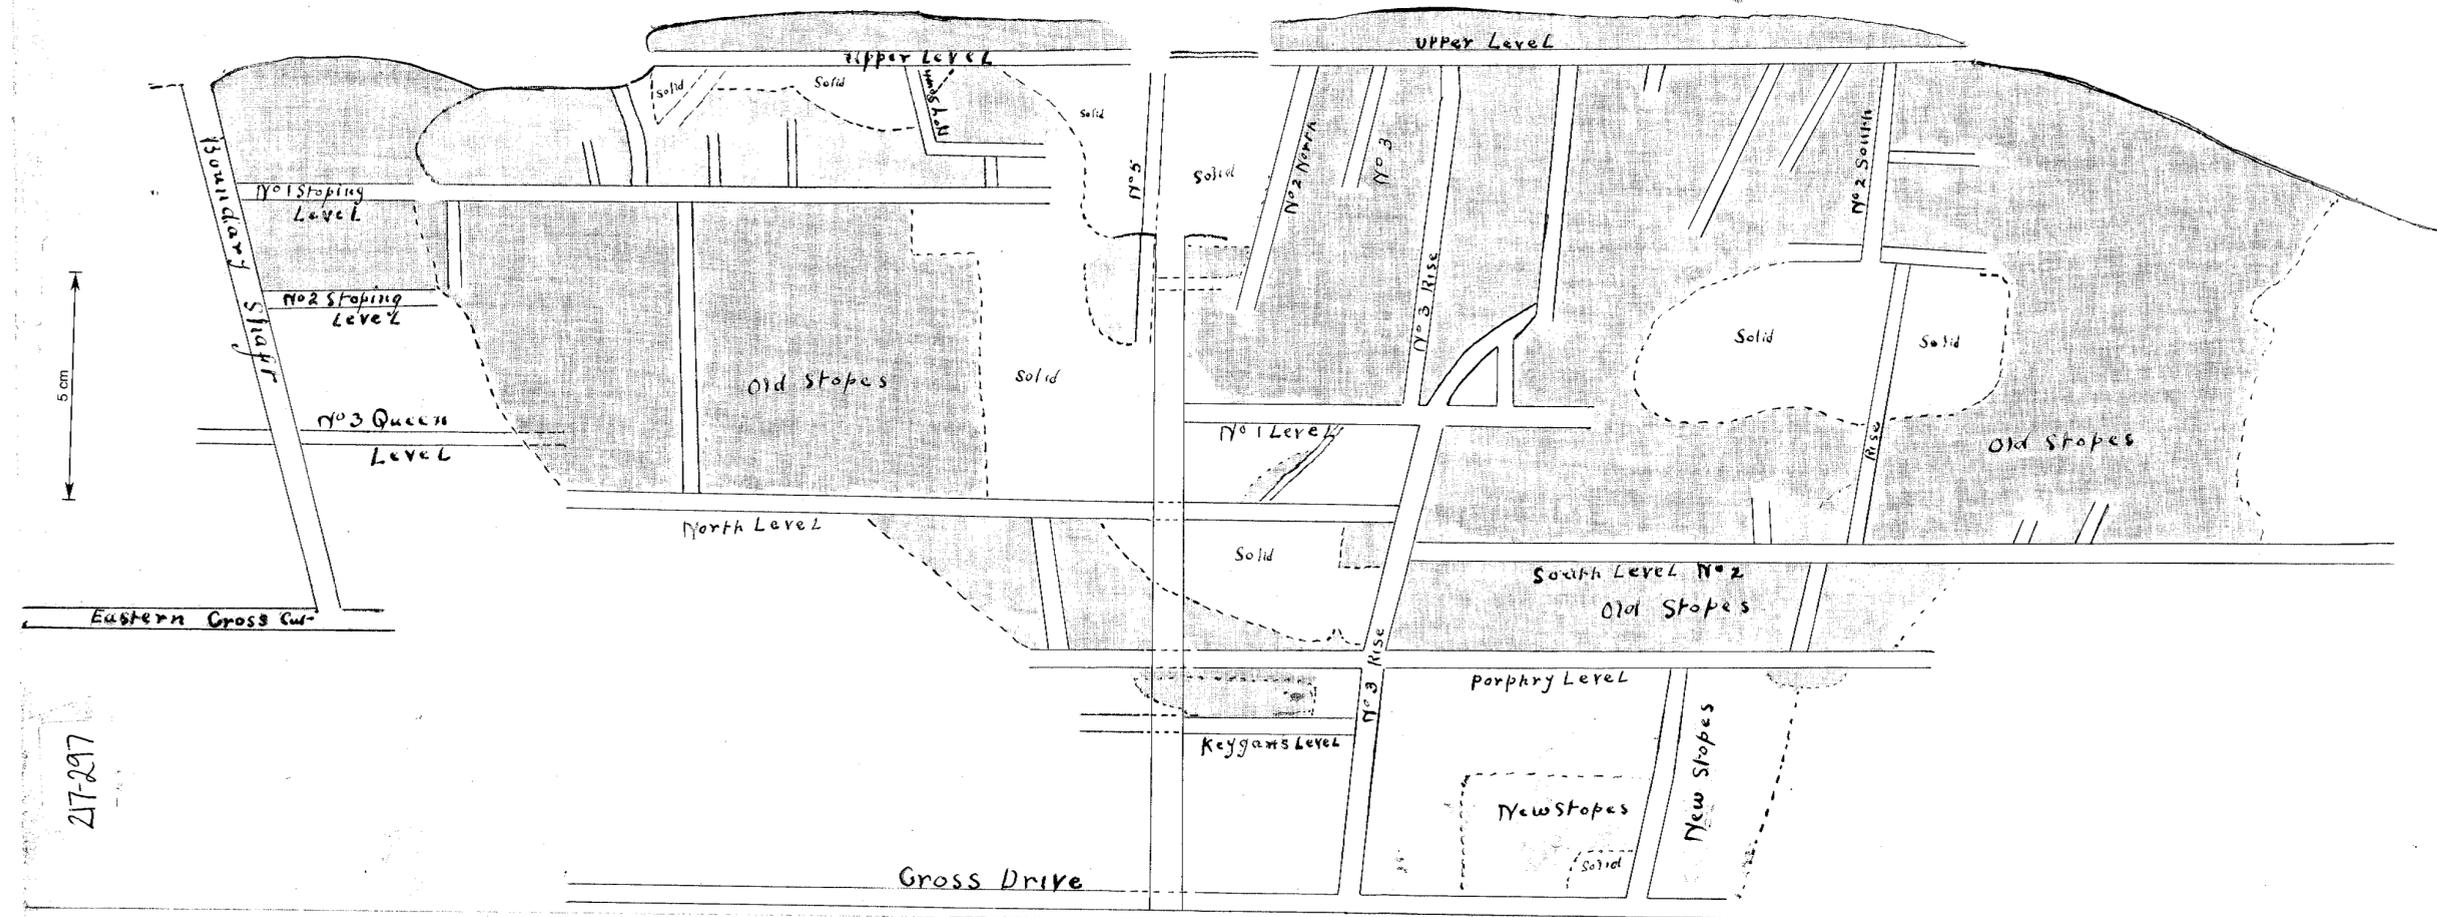

217-297

217-297

Work 1923
Survey taken from Old Plan by D Jones 1891
Instrument used 5" Theodolite