


5 cm





217-299

**PLAN**  
**OF**  
**STANHOPE T. M. COMPANY'S**  
**UNDER GROUND WORKS.**

Scale 50 Feet to one Inch.

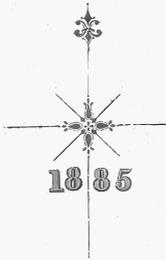

THE MOUNT BISCHOFF T. M.  
 COMPANY.  
 LESSEES  
 No 8

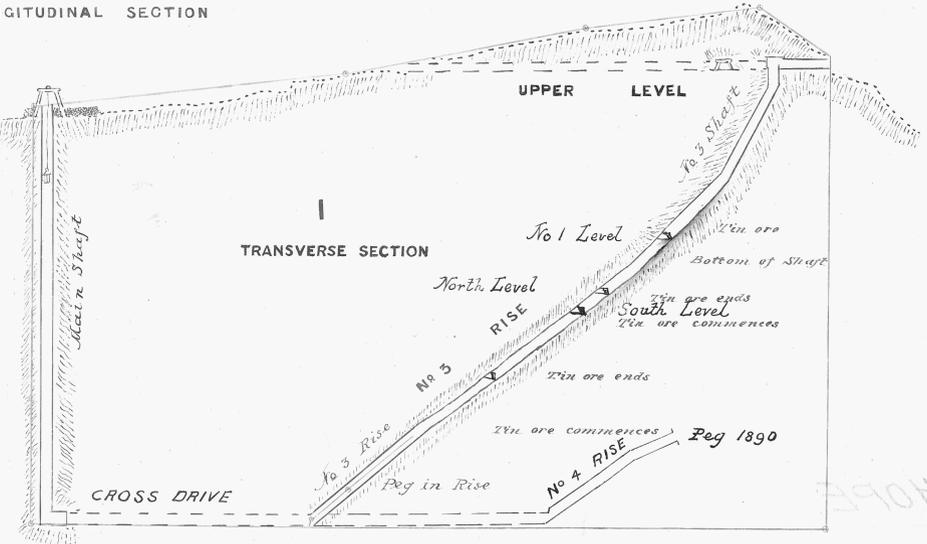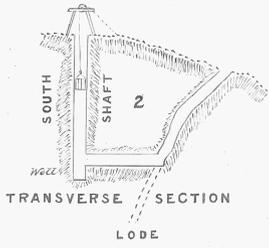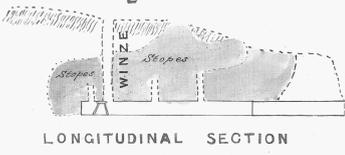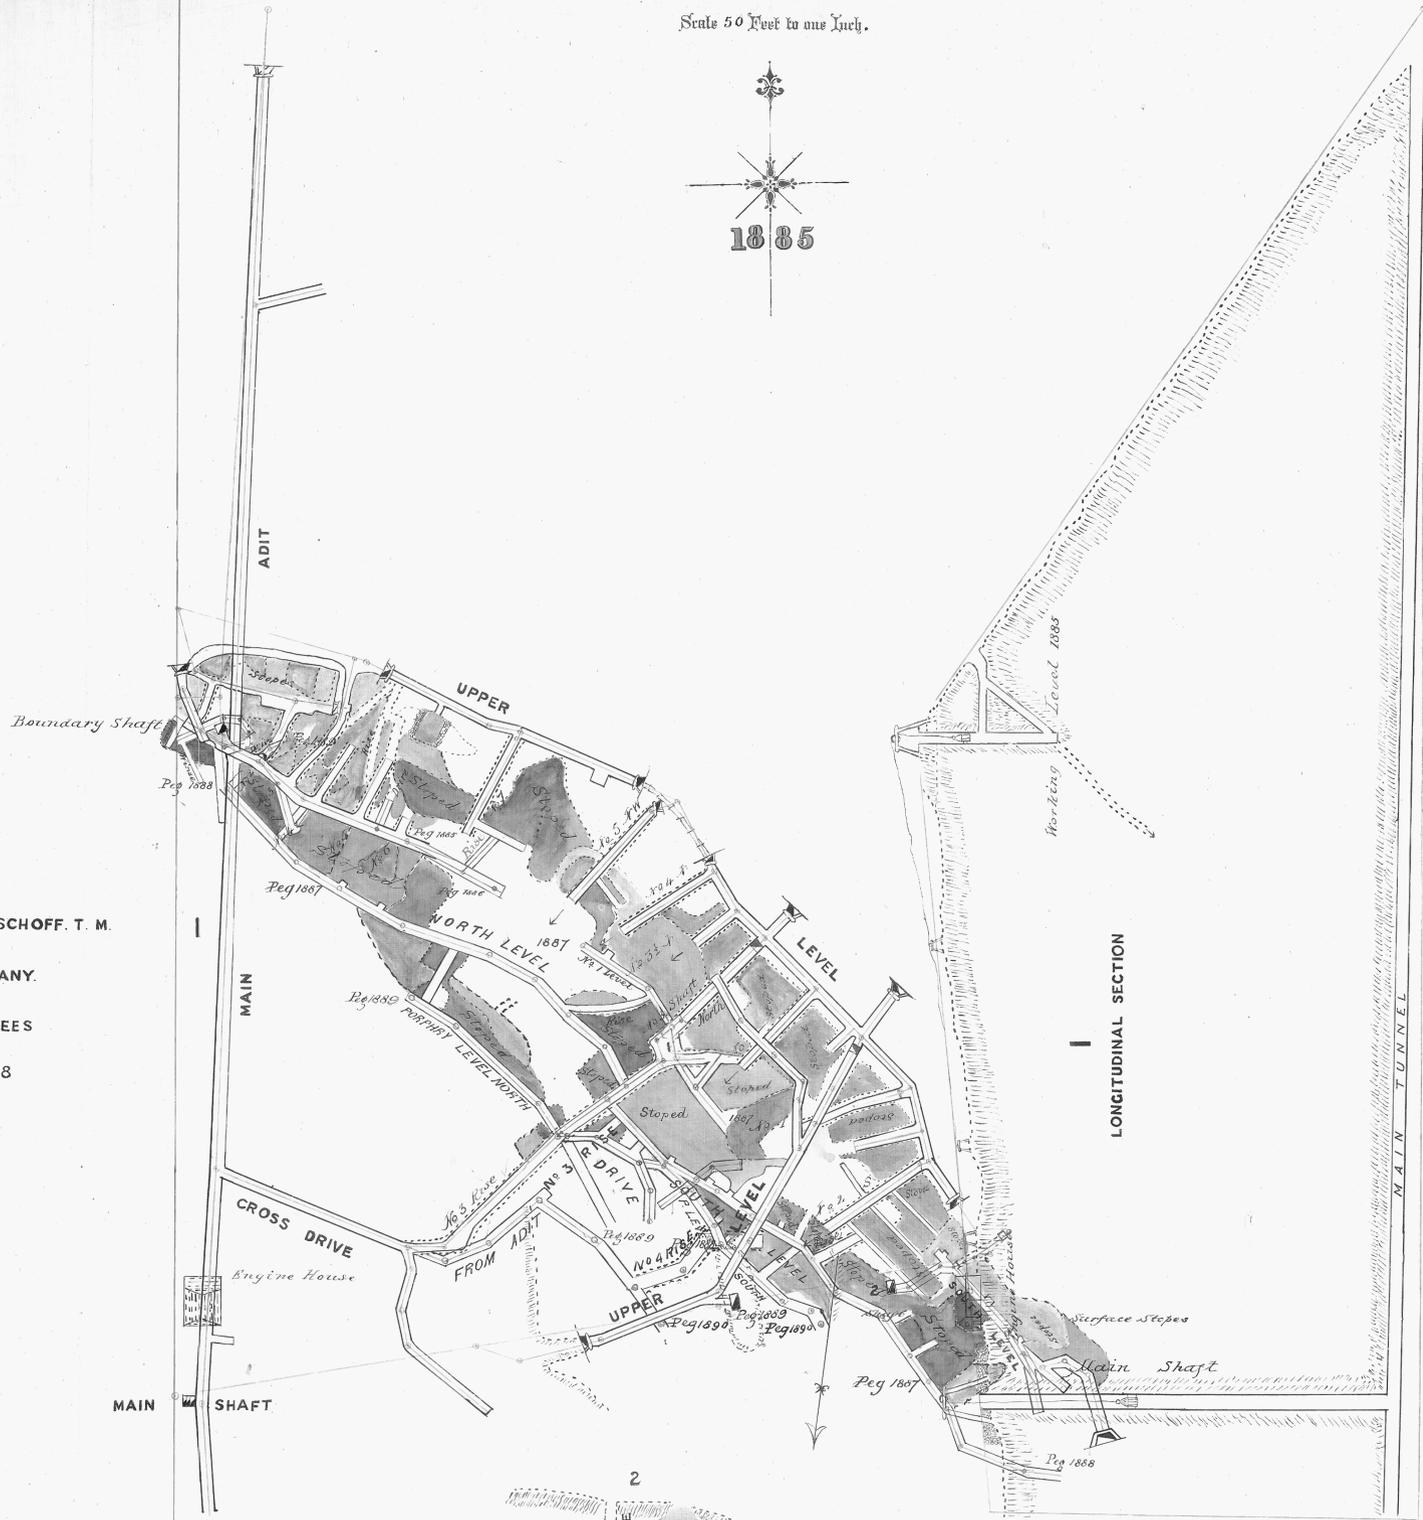

Tracing from plan made by

David Jones.

District Surveyor

Waratah, 1885 and 1890

*David Jones*  
 District Surveyor

STANHOPE