

217-301

217-301


5 cm

NORTHERN BOUNDARY

Mount Bischoff Extended. I. M. Co. N.L.

Section showing additions year 1918.

Scale 50' = 1 inch

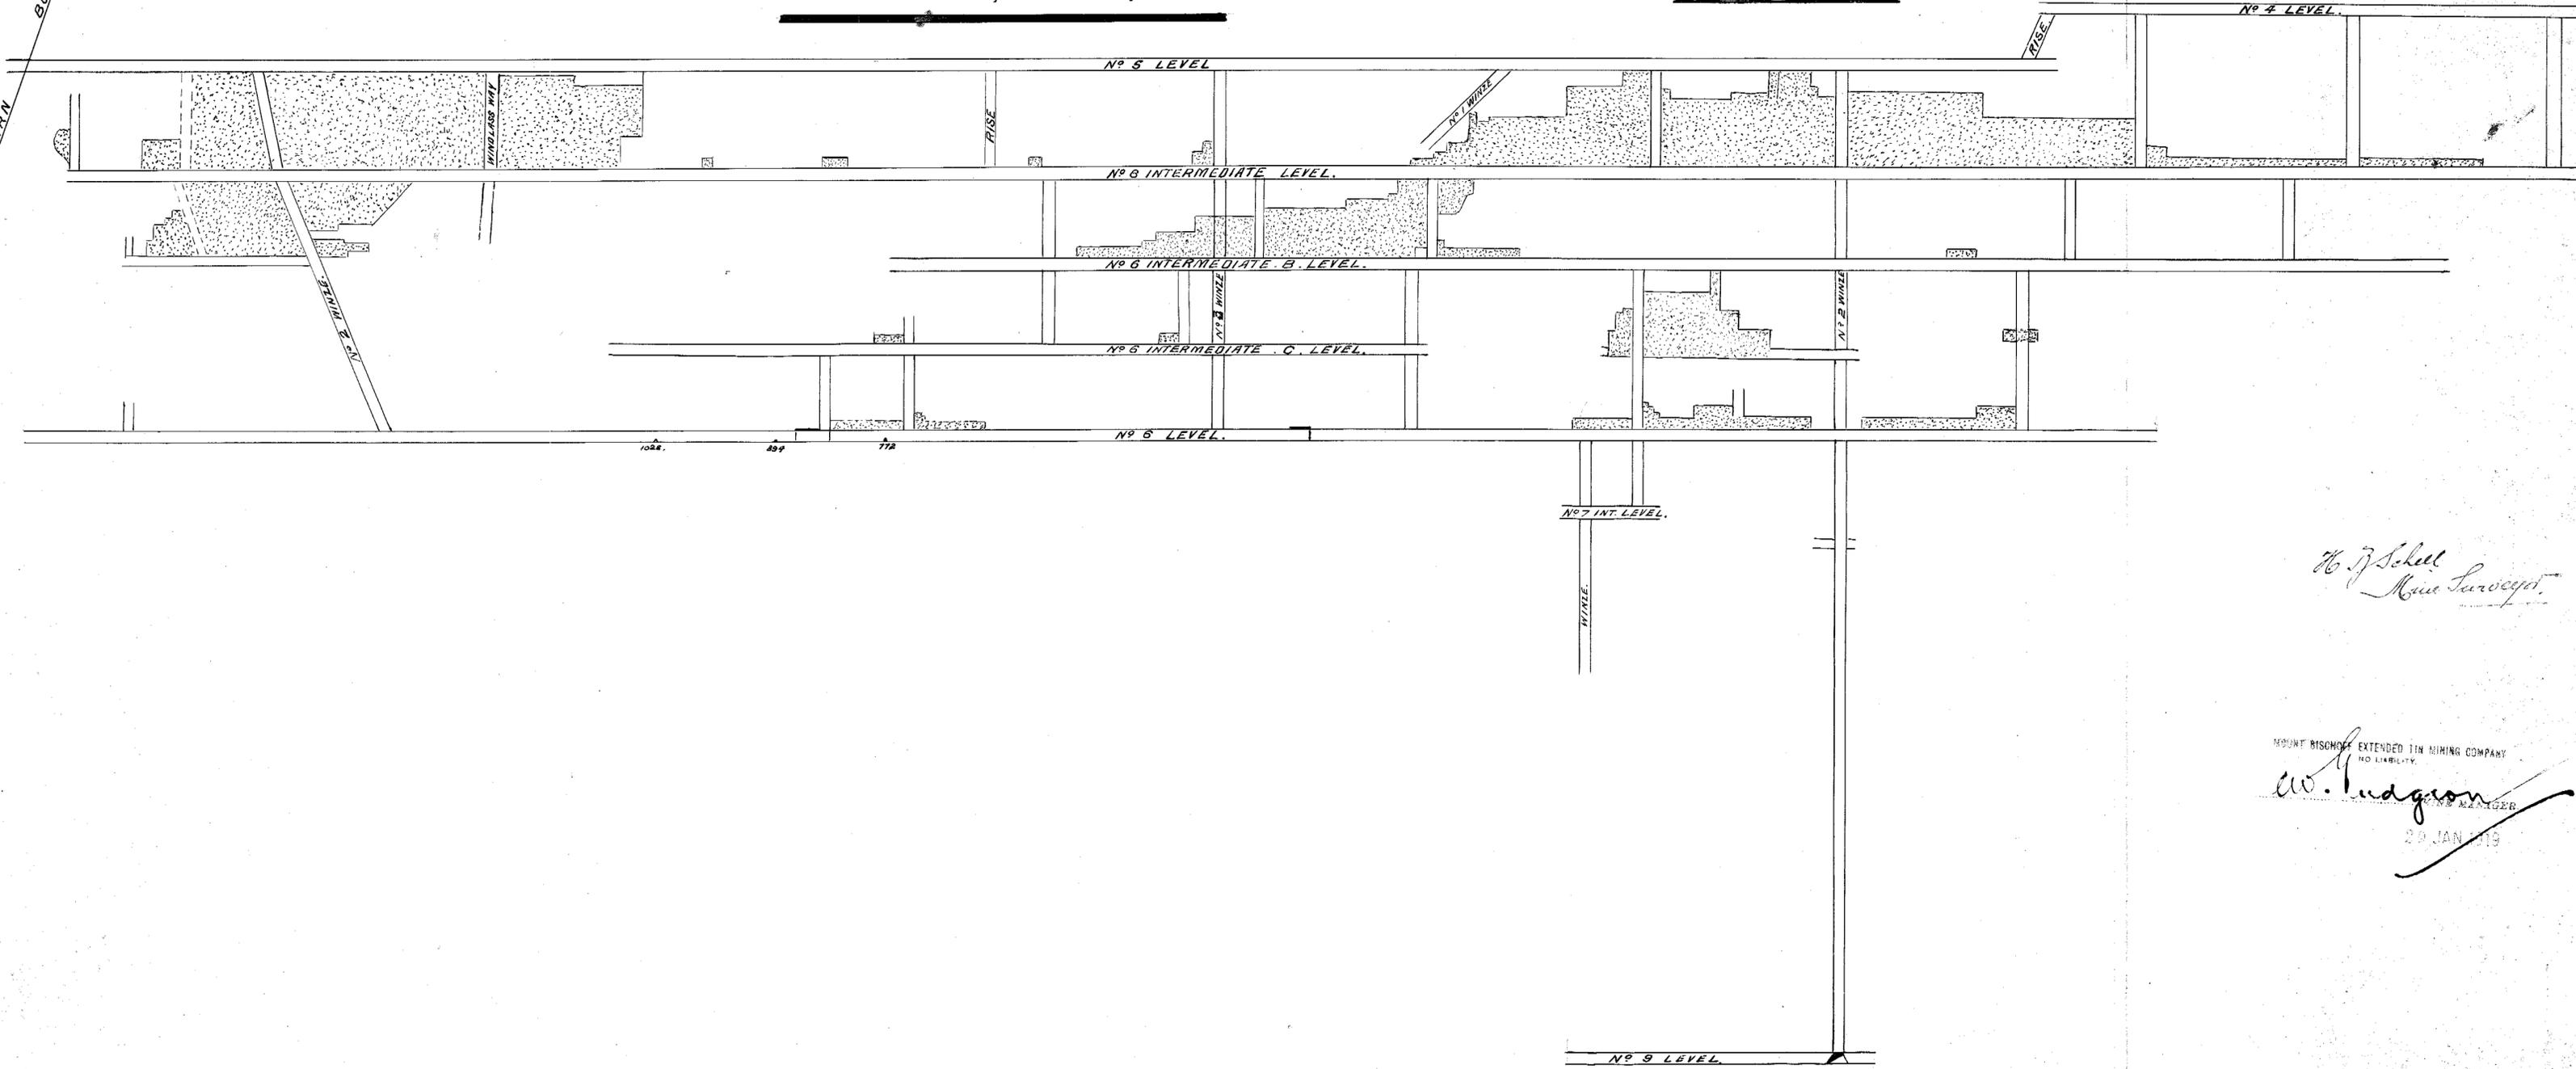

H. J. Schell
Mine Surveyor

MOUNT BISCHOFF EXTENDED TIN MINING COMPANY
INCORPORATED

W. Hudson
MANAGER

20 JAN 1919