


16  
217-302

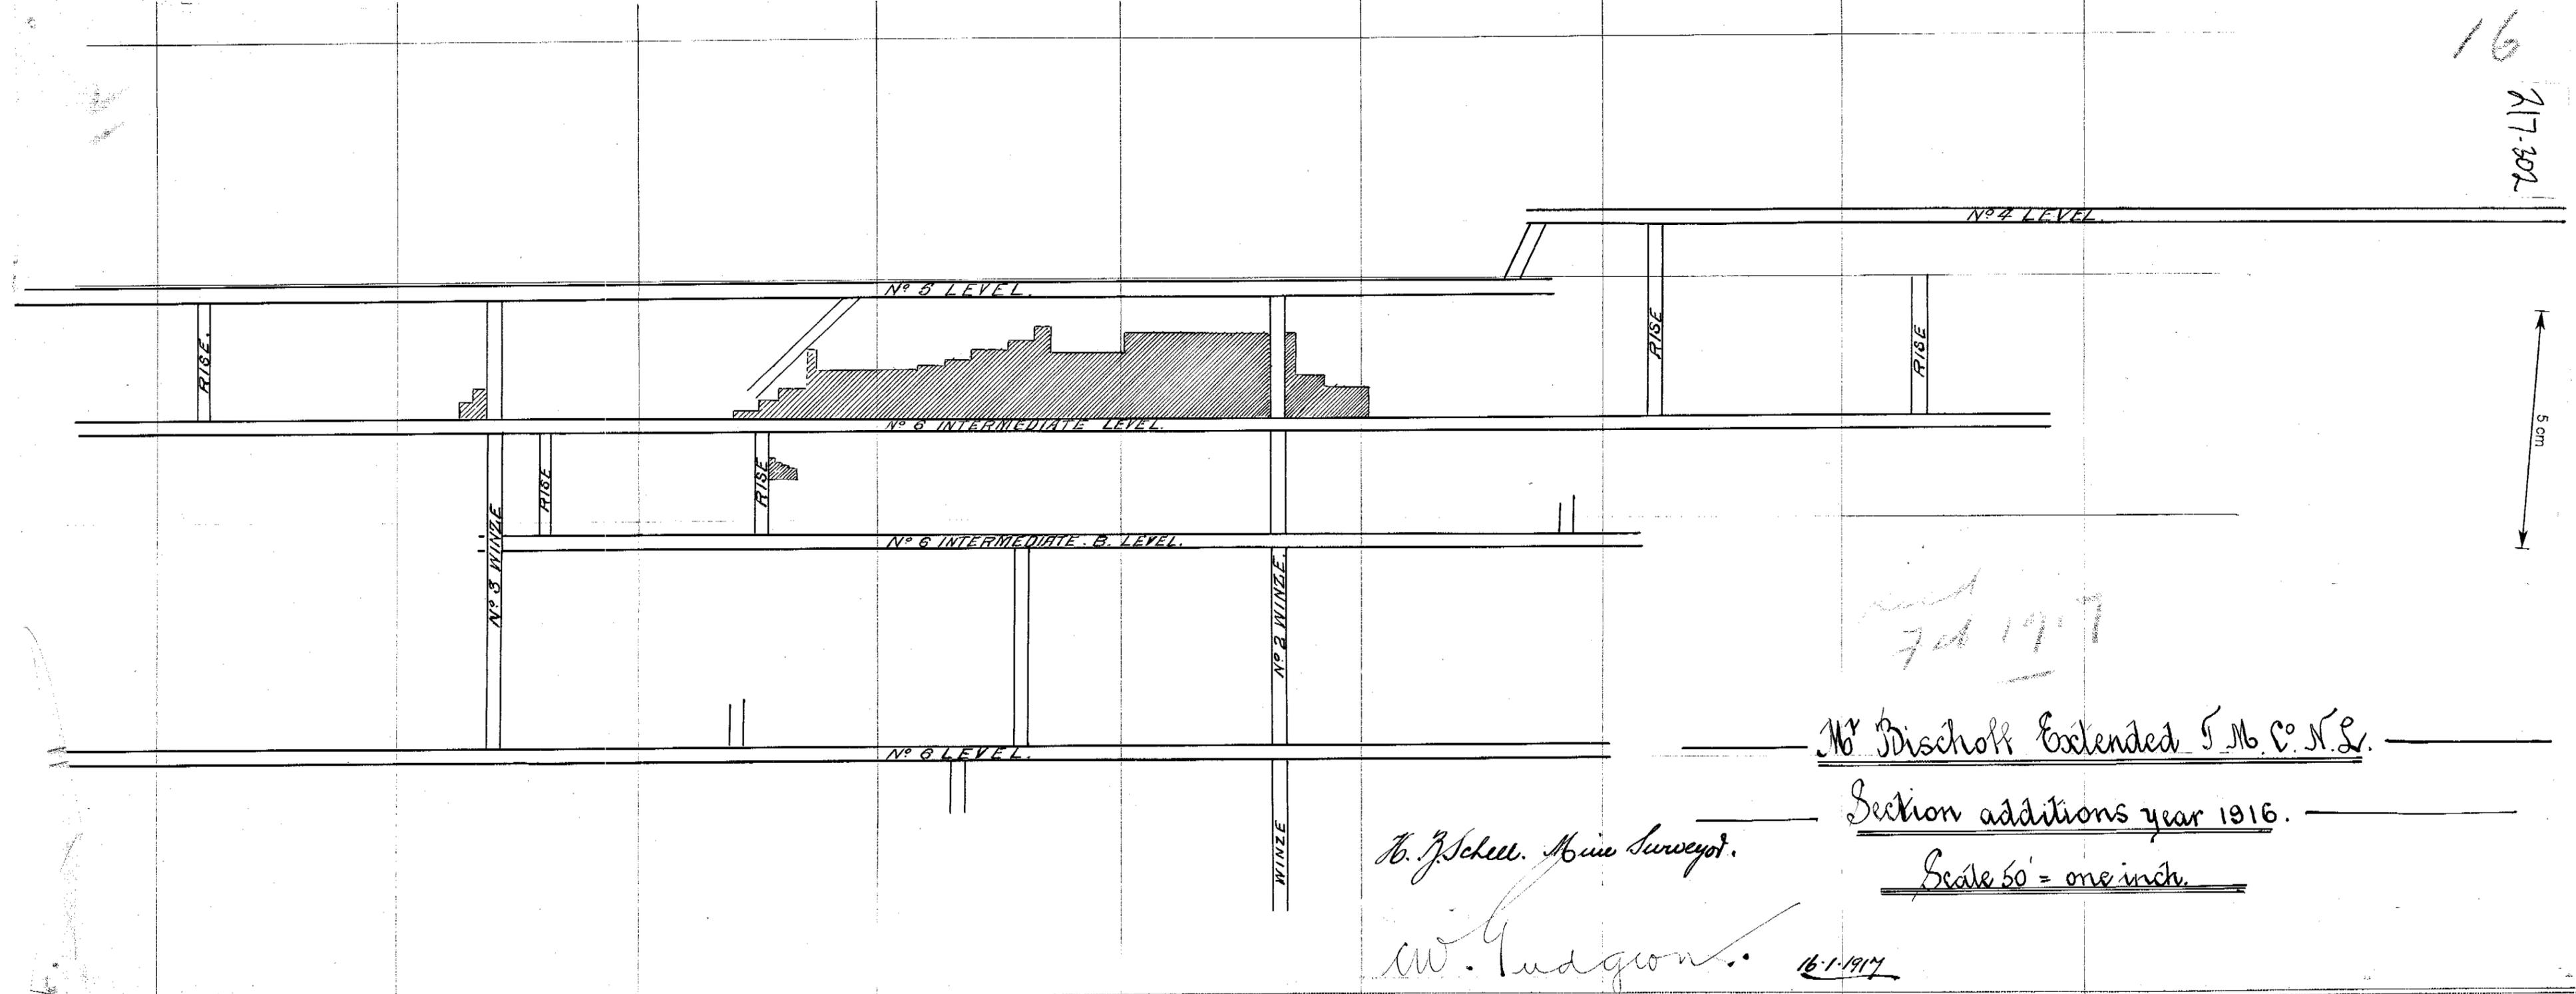

Mr Bischoff Extended T.M.C. N.L.

Section additions year 1916.

Scale 50' = one inch.

H. Zschell. Mine Surveyor.

W. Judson. 16-1-1917

217-302