


Mount Bischoff Extended Tin Mining Co. N.L.

Section of Workings - 23. 3. 1921

Scale 50' = one inch

NORTHERN BOUNDARY

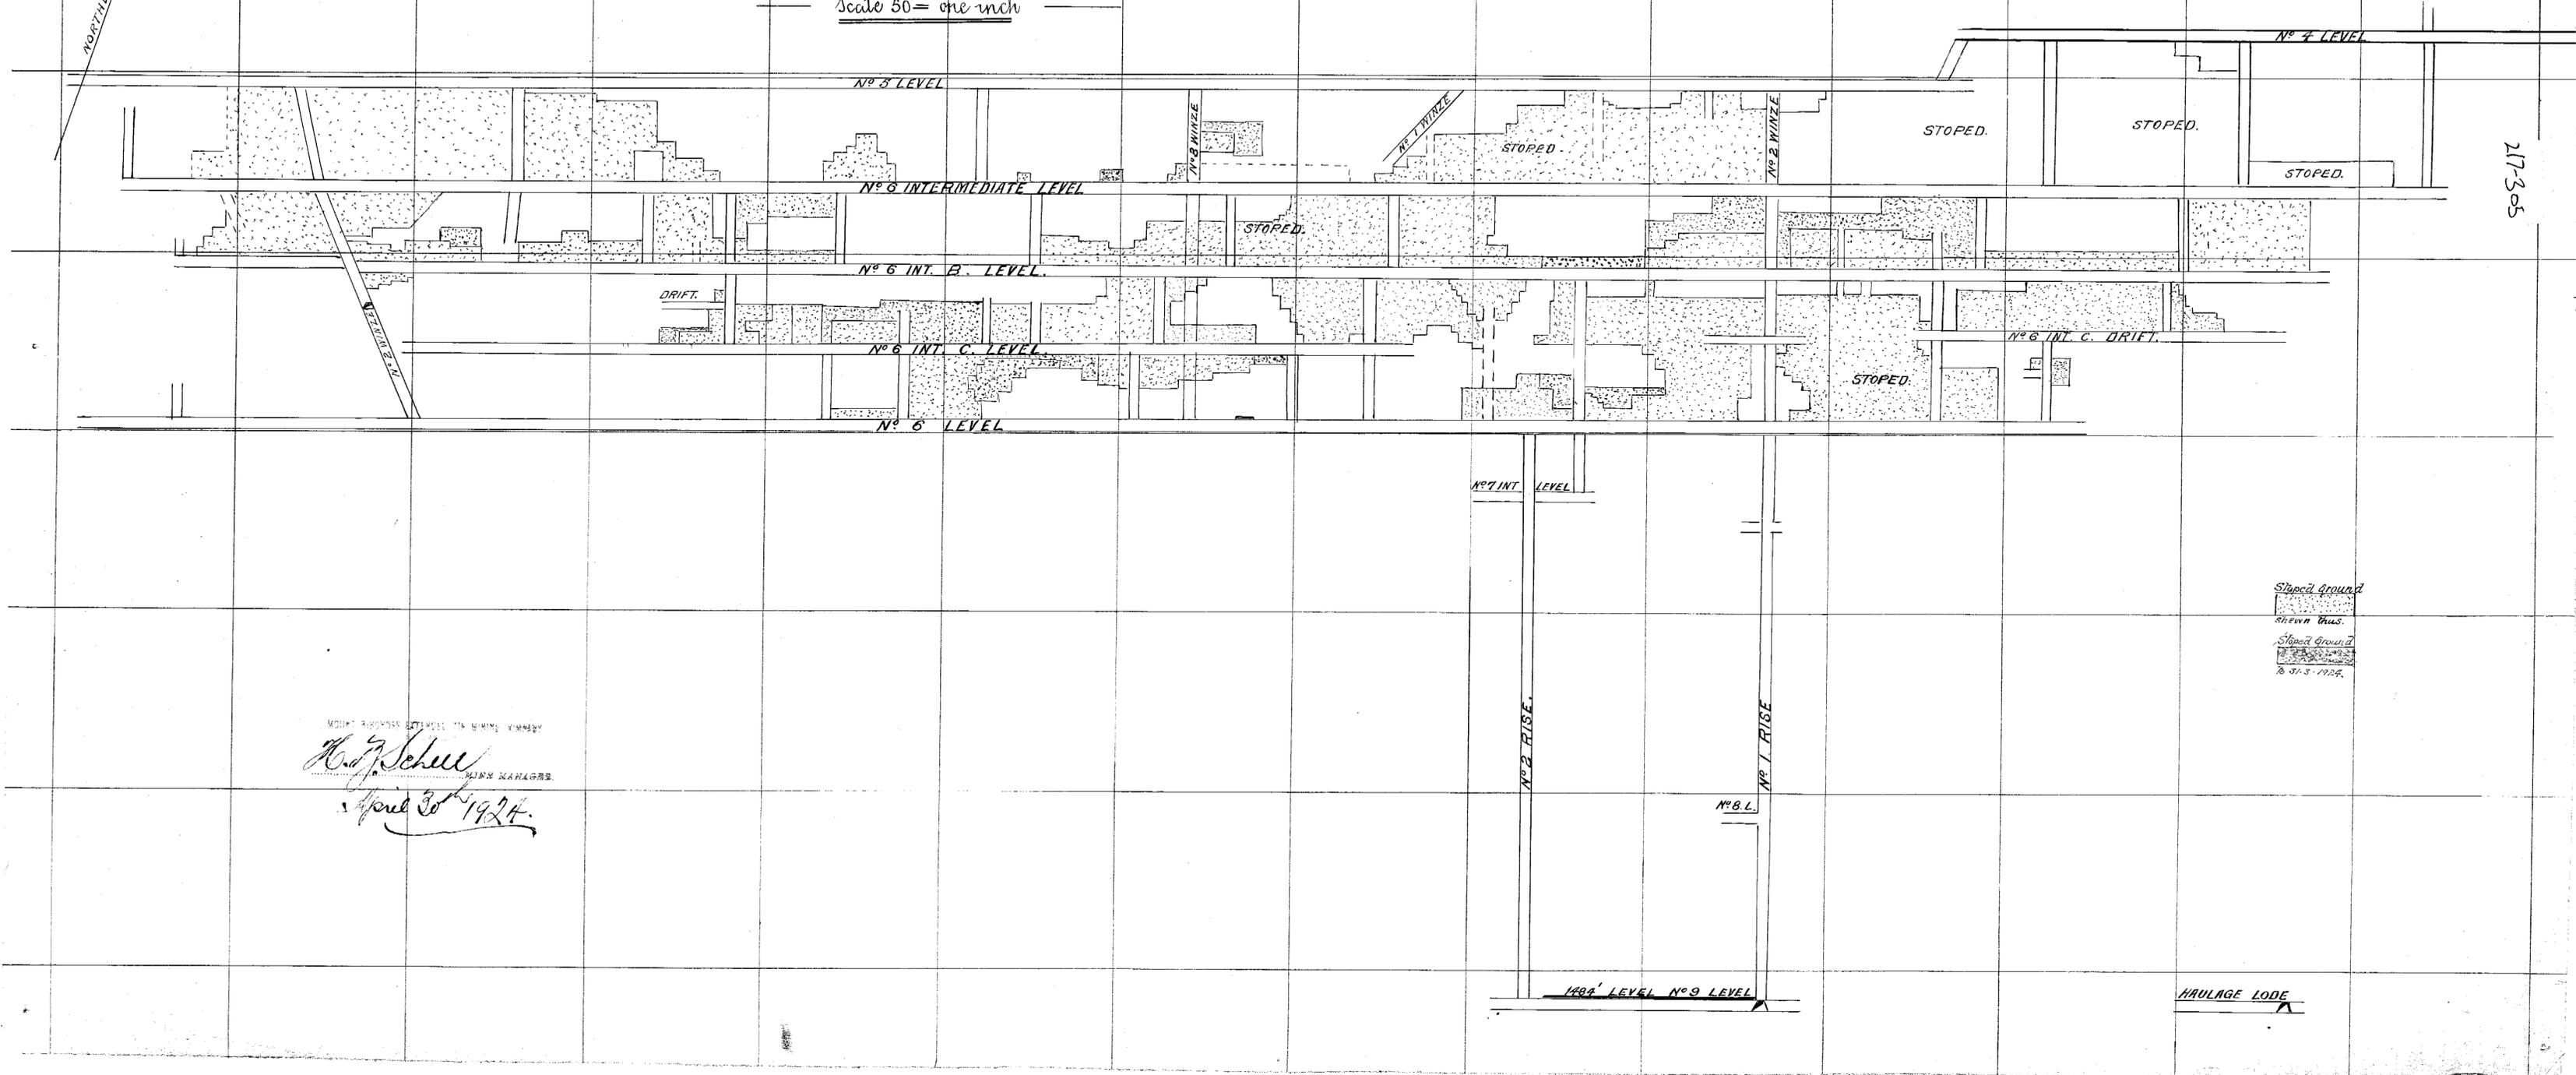

217-305

5 cm

Stippled Ground
 Shewn Thus
 Stippled Ground
 23. 3. 1921

MOUNT BISCHOFF EXTENDED TIN MINING COMPANY
H. J. Schell
 MANAGER
 April 30th 1924

1484' LEVEL No 9 LEVEL

HAULAGE LODE

217-305