


M^T BISCHOFF EXT^D T.M.C^o NL

MINE SECTION.

50' = 1"

217-307

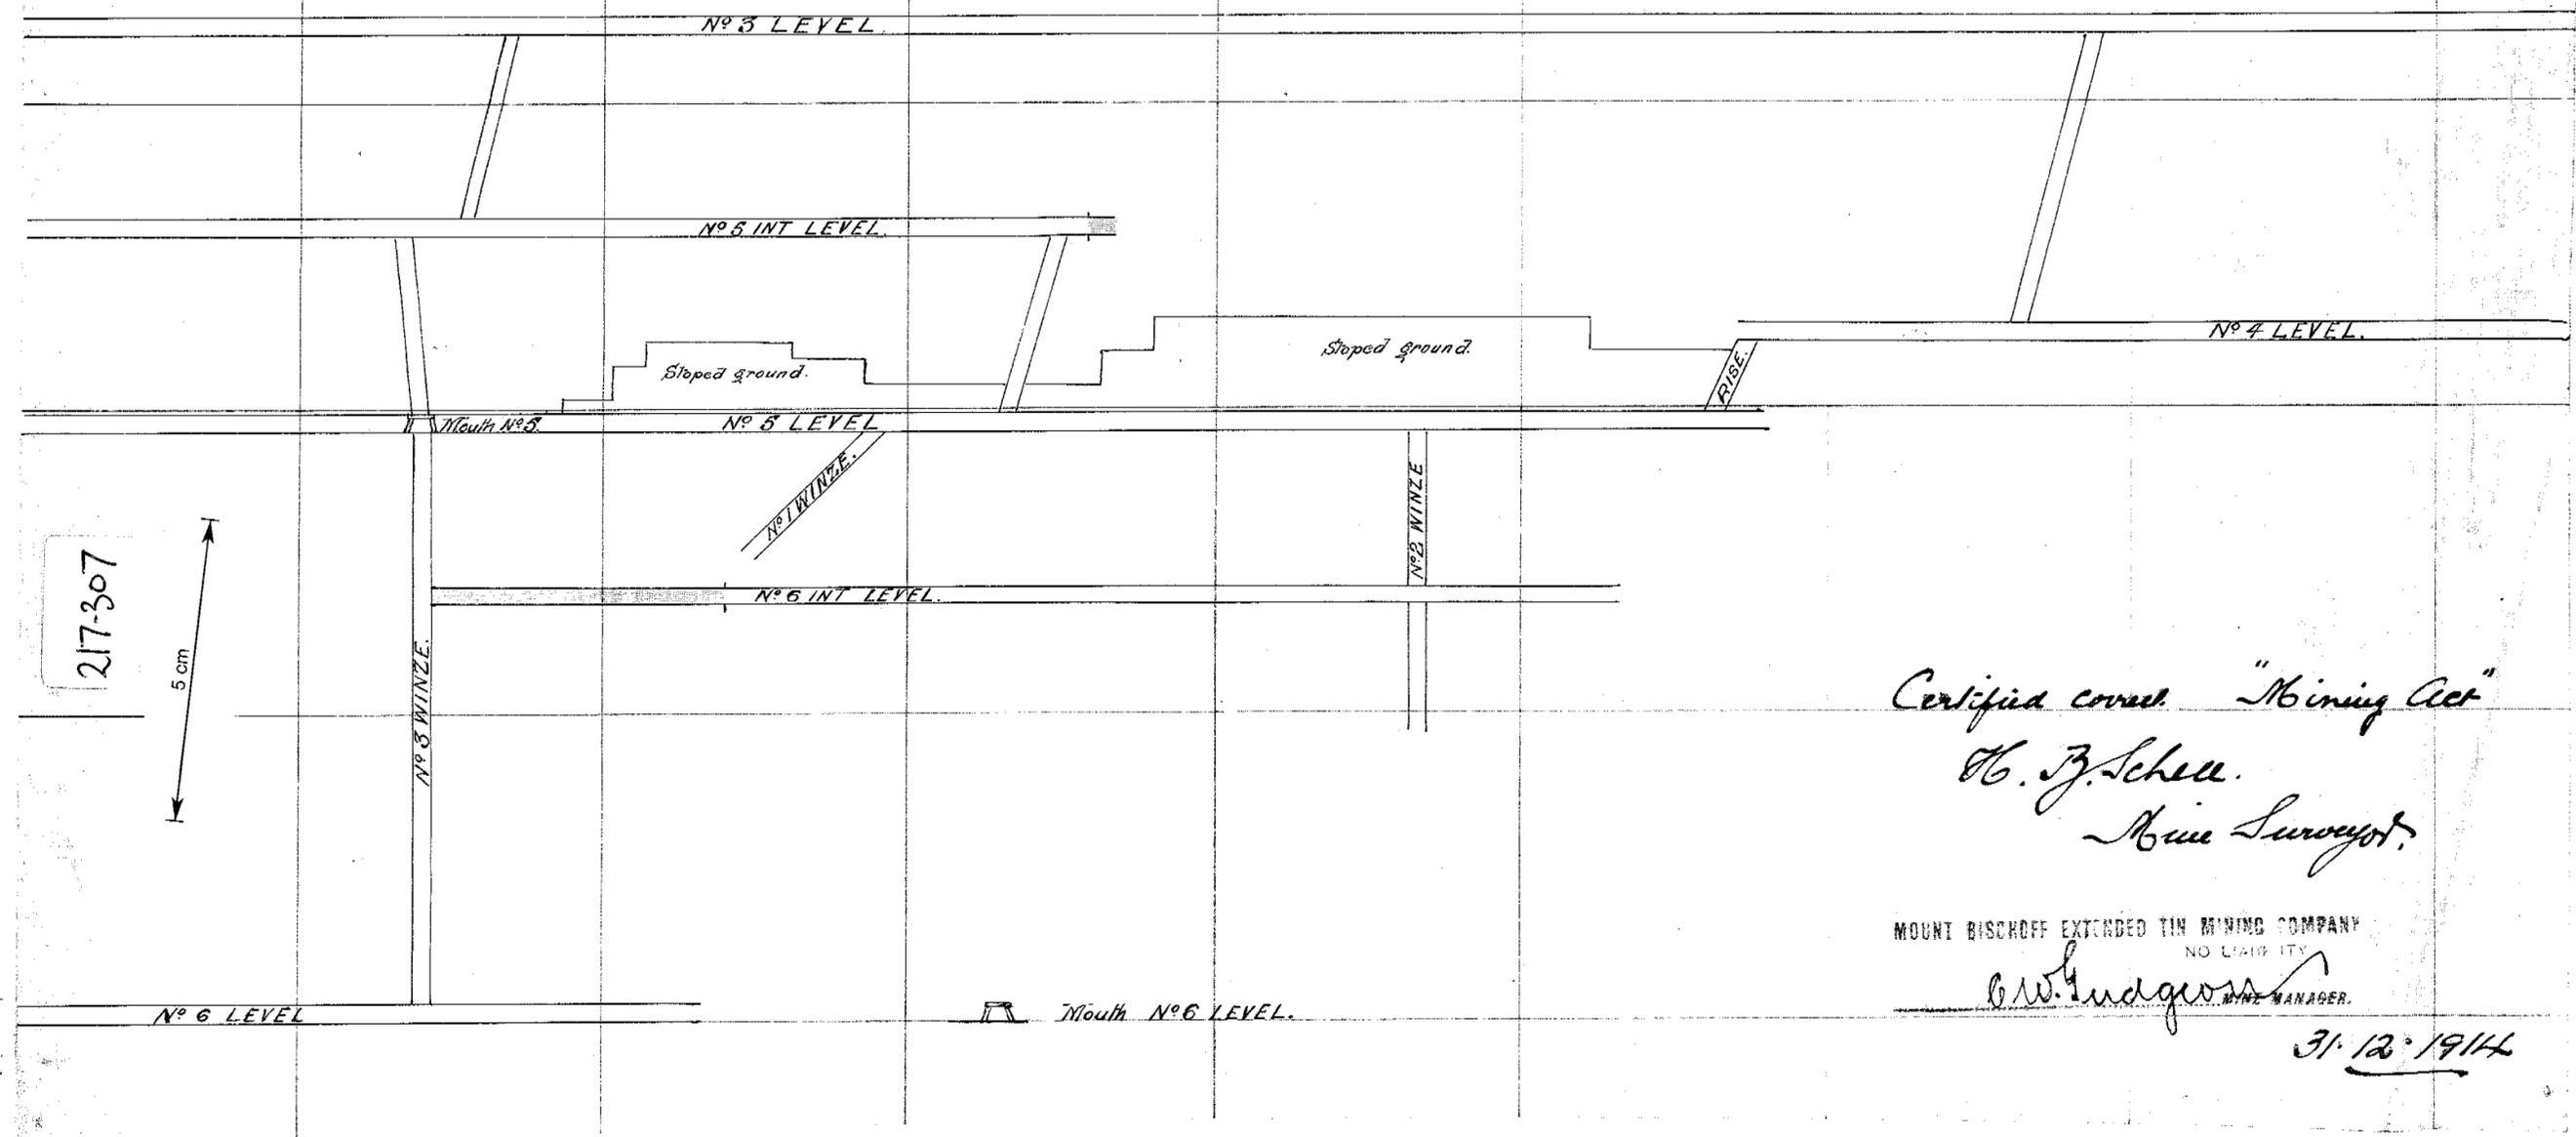

Certified correct "Mining Act"
H. B. Schee.
Mine Surveyor.

MOUNT BISCHOFF EXTENDED TIN MINING COMPANY
 NO LIABILITY
C. W. Anderson
 MINE MANAGER.

31.12.1914