


— Mount Bischoff Extended, J. M. Co. N.L. —

— Under-ground workings Year ended 1918. —

Scale 50' = 1 inch

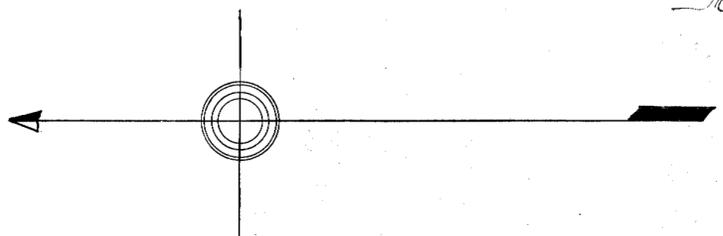

H. J. Schell
Mine Surveyor

B. W. Hudson
29 JAN 1919

217-309

5 cm

217-308
rod line

217-309

505