


M^r BISCHOFF EXTENDED T. M. C^o


PLAN OF N^o 5 LEVEL

Scale of 30 feet to 1 inch.

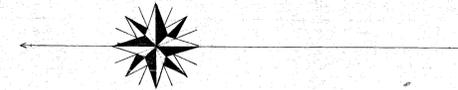

Tilted portion surveyed with Troughton's Transit reading to 20°

J. K. Seelye 25. 9. 08.

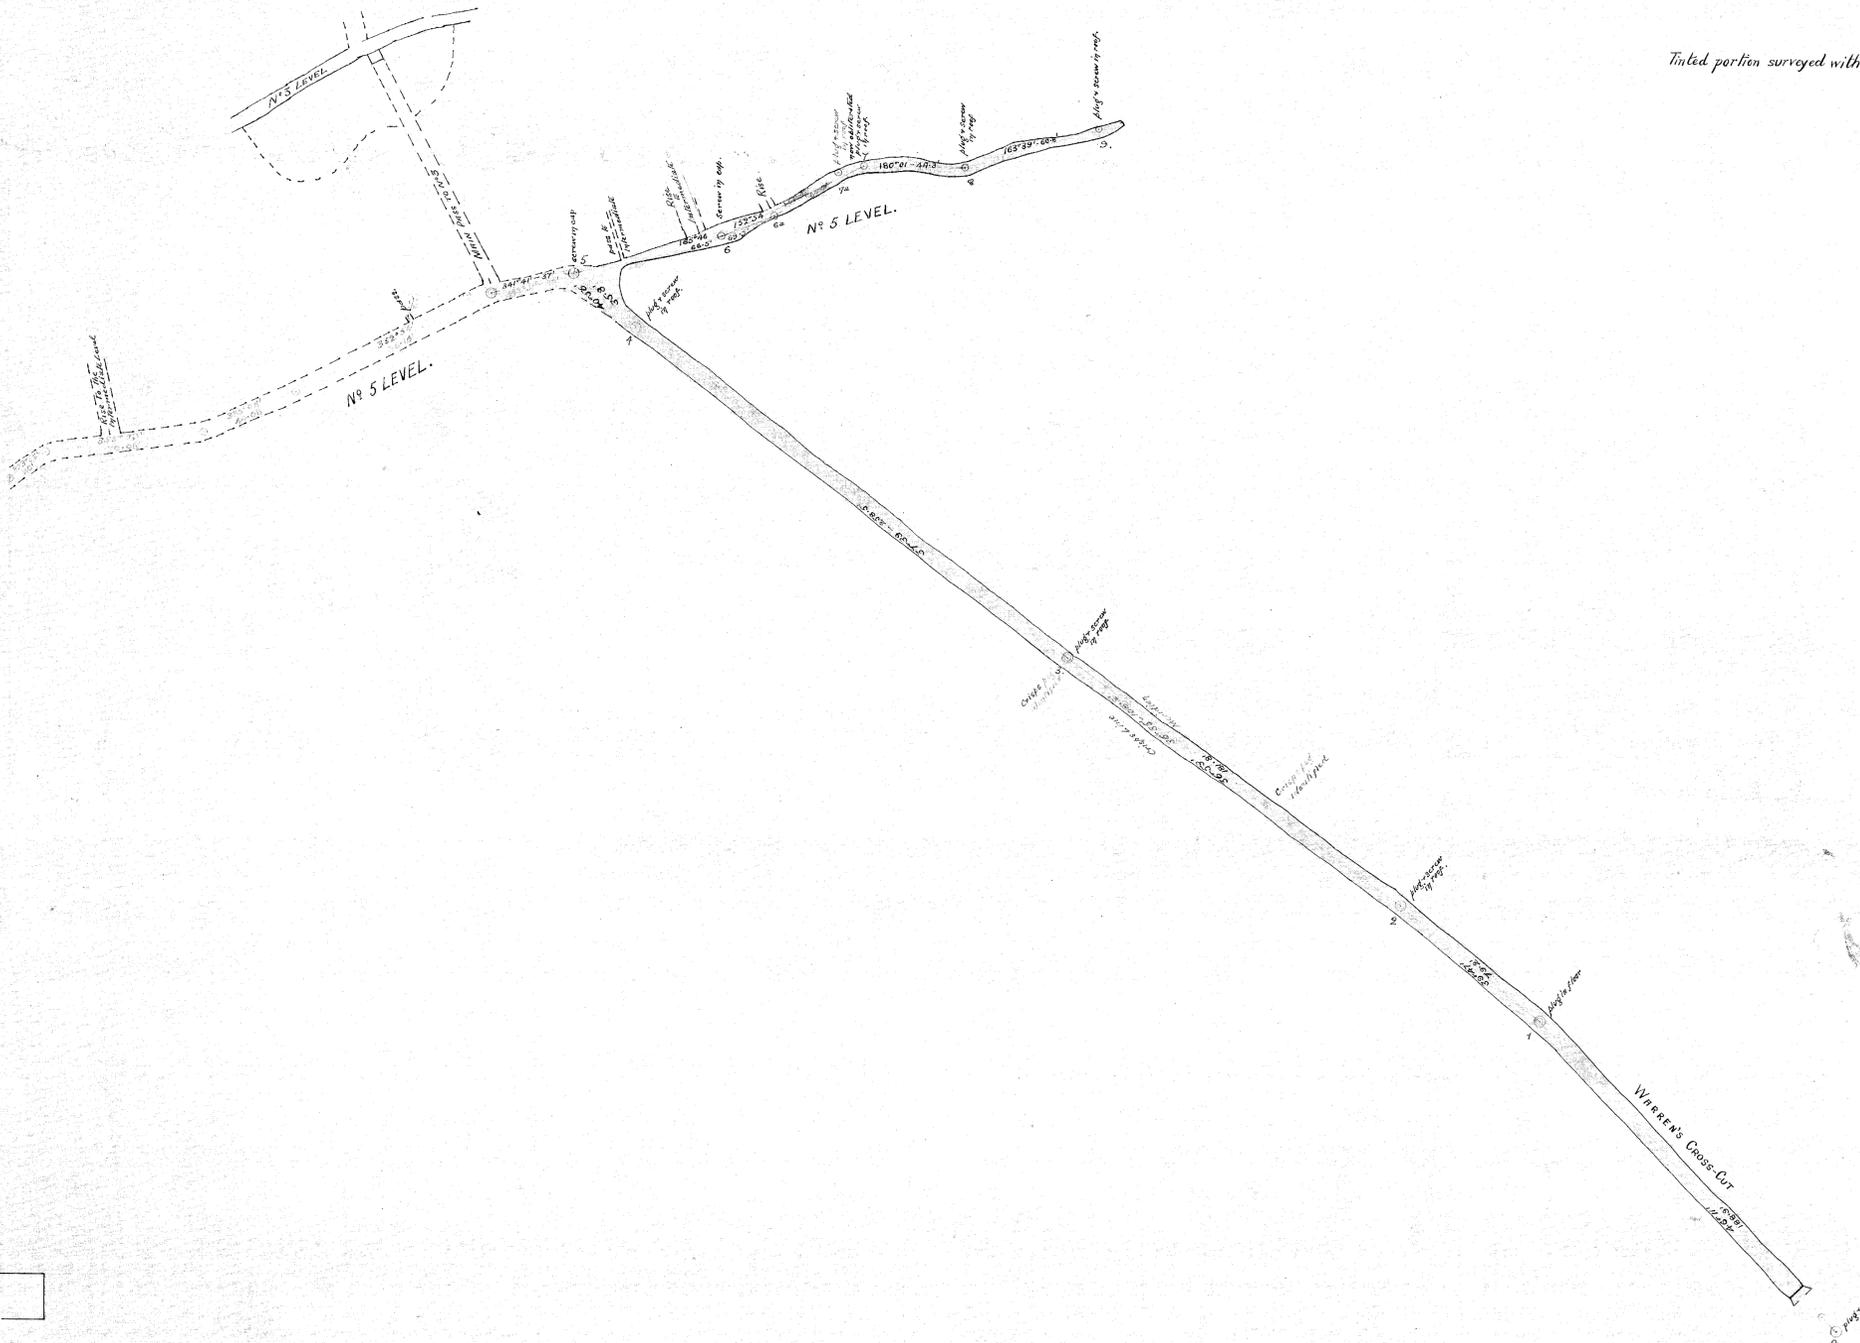

21-310

50m

21-310



Handwritten notes and signatures in the bottom right corner, including a signature that appears to be 'J. K. Seelye'.