
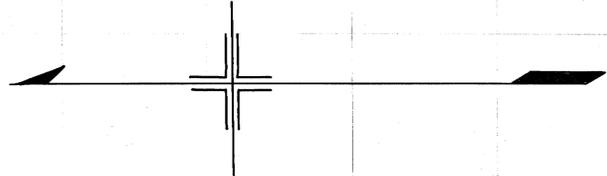


505

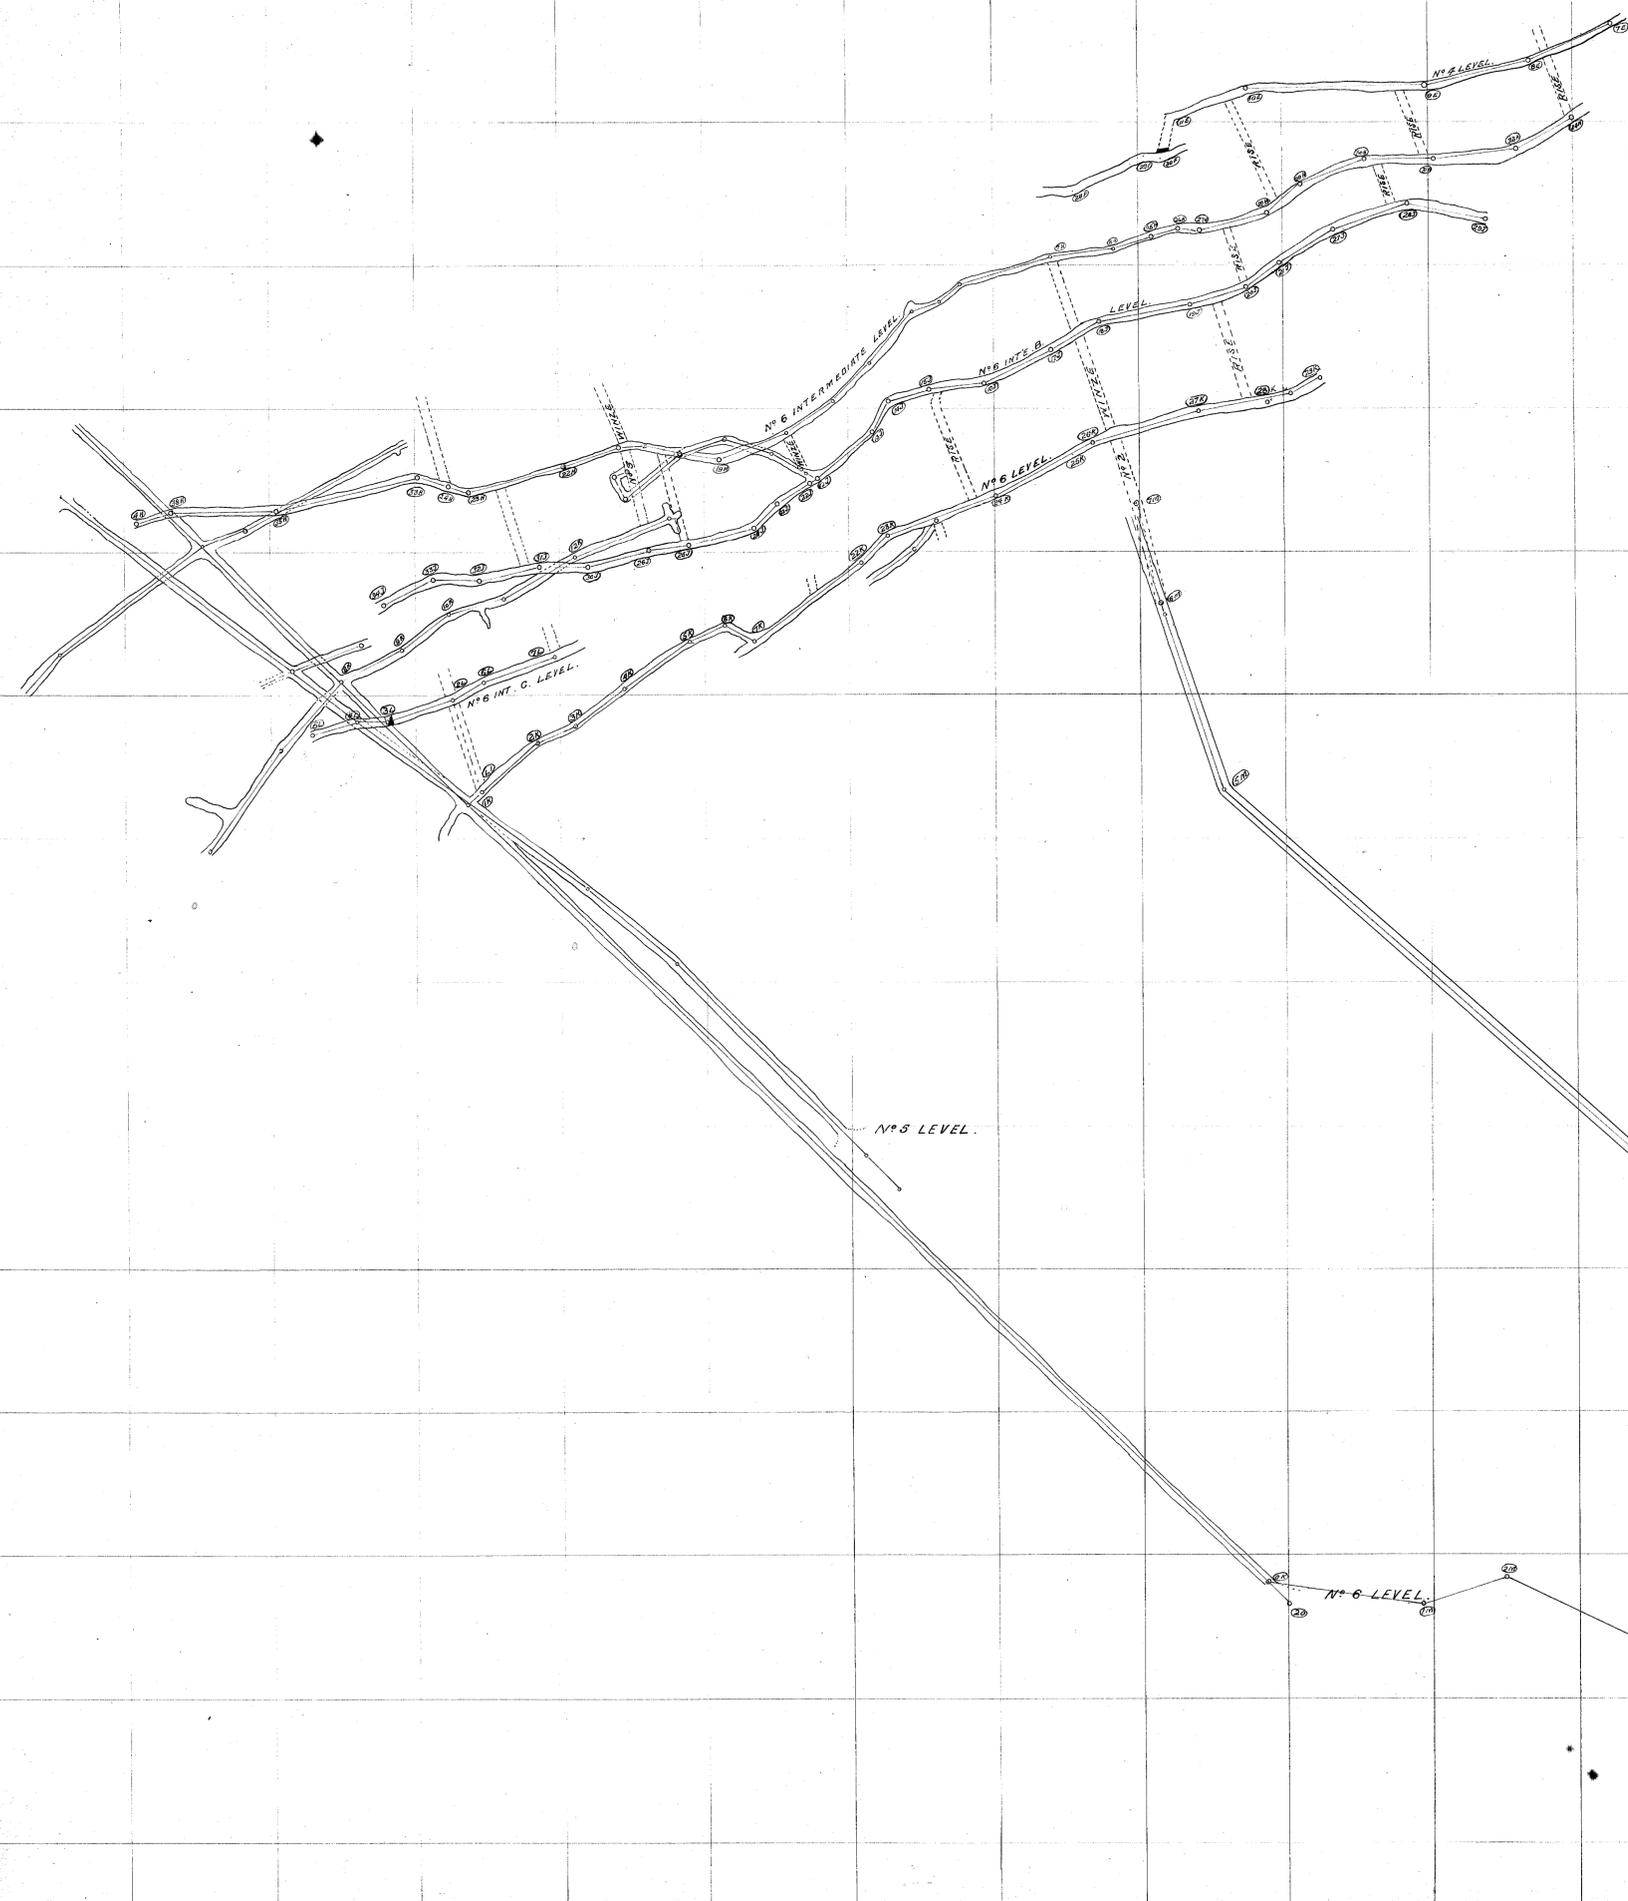

MOUNT BISCHOFF EXTENDED MINING COMPANY  
 W. H. A. G. G.

H. J. Schell. Mine Surveyor.  
 July 9, 1918

50 ft