


217-312
TOS LARGE

217-312

5 cm

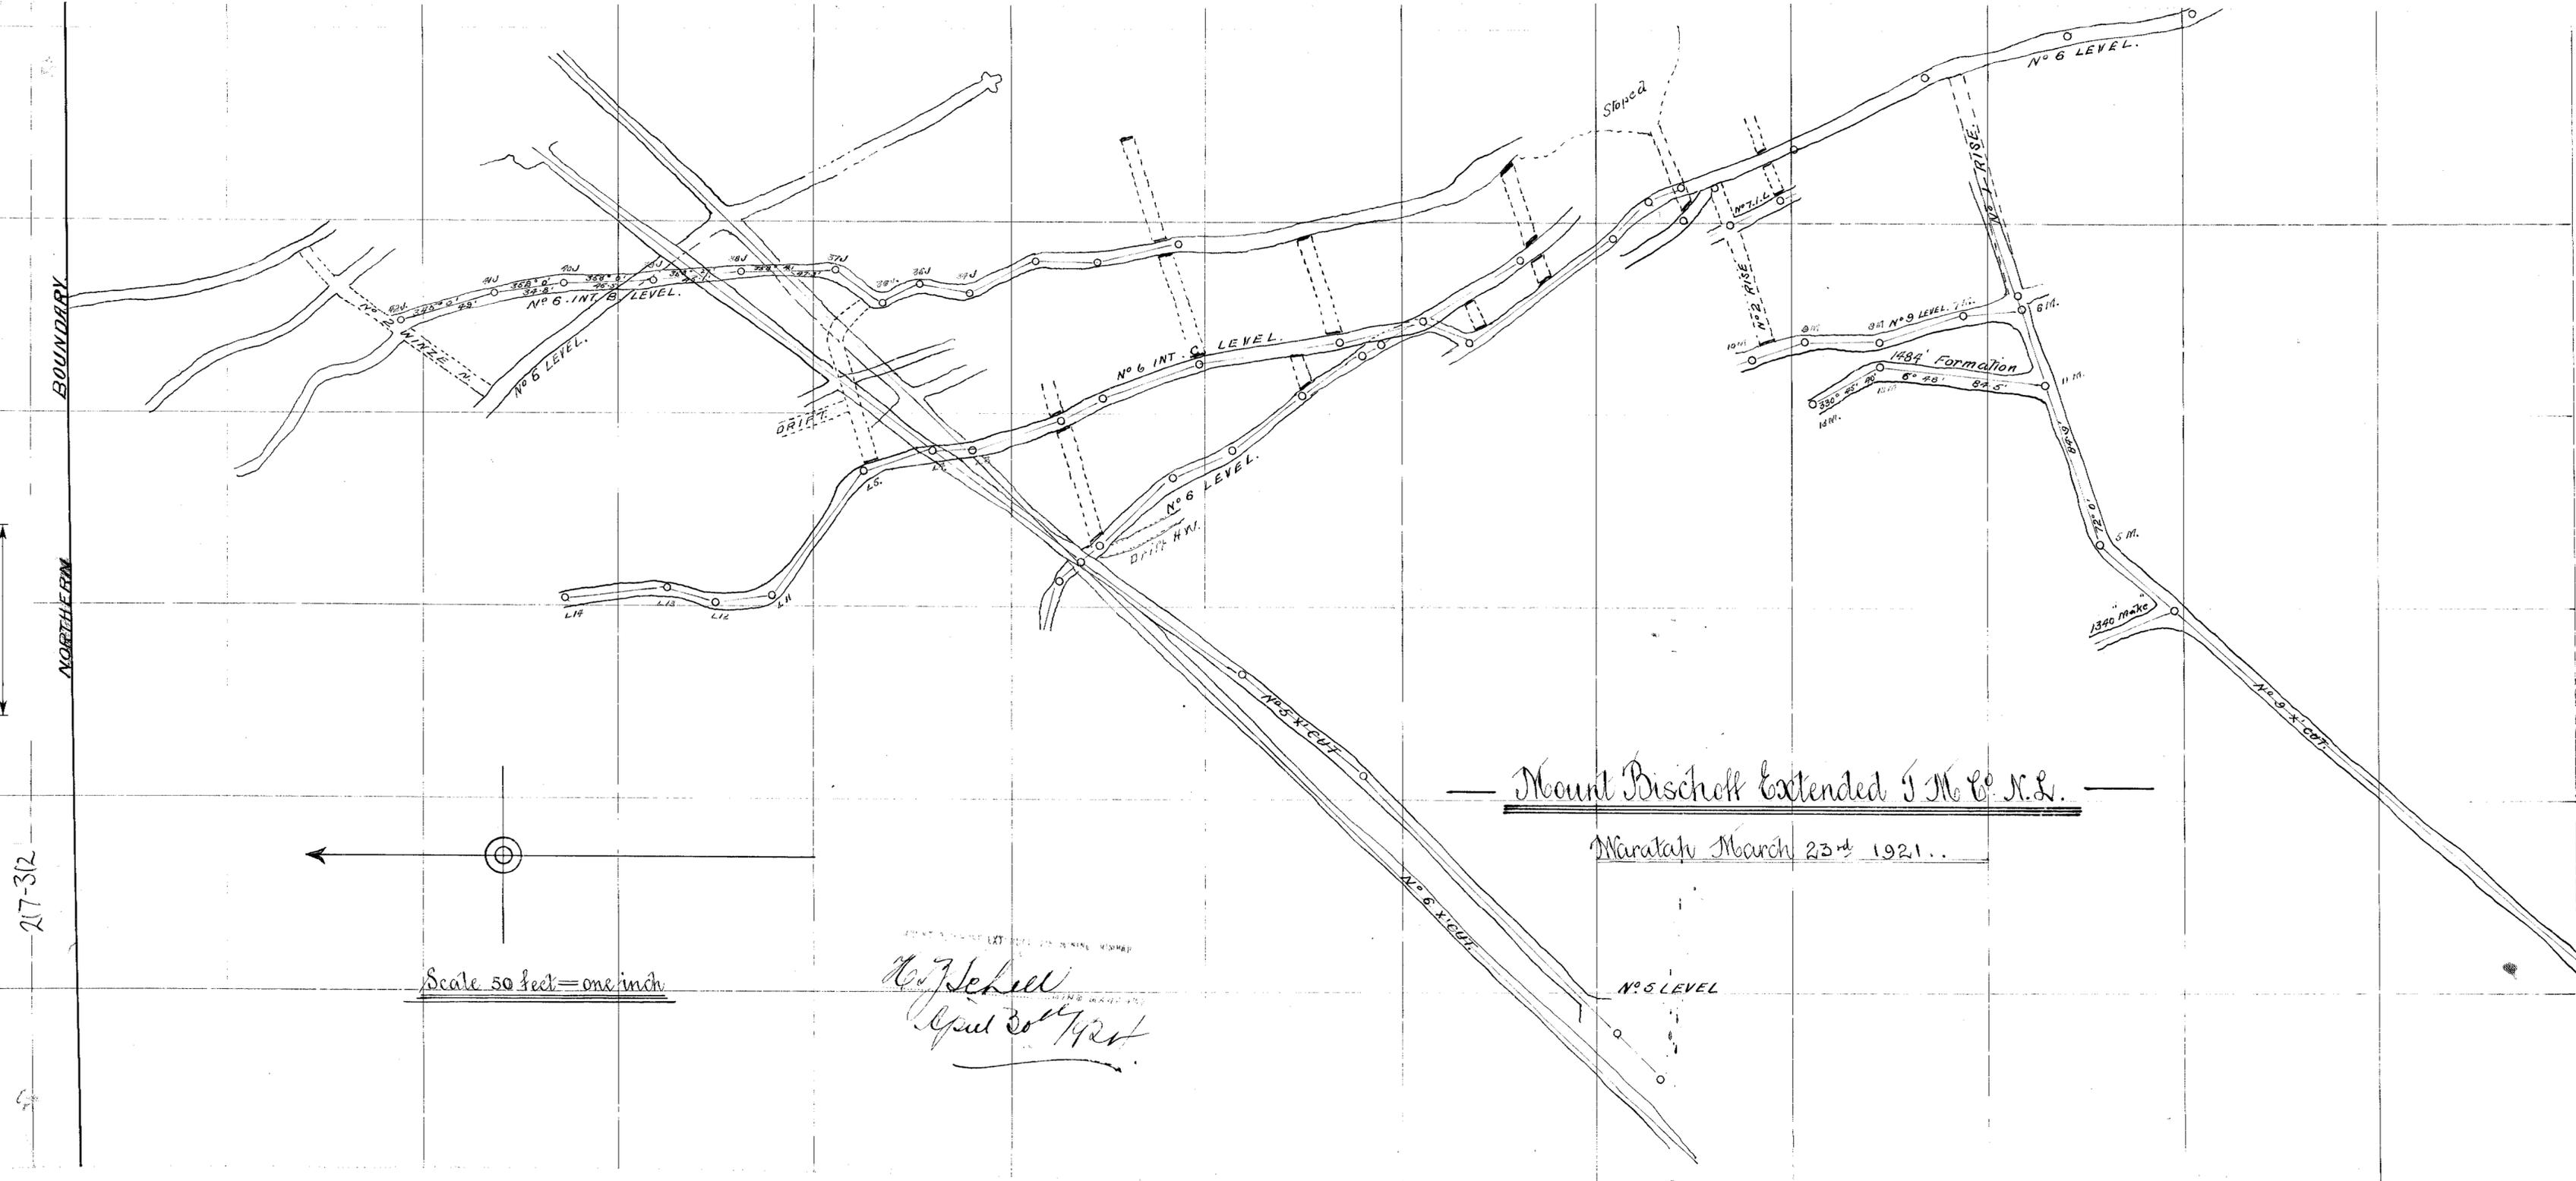


Mount Bischoff Extended I No. 6 N.L.

Maratak March 23rd 1921..

Scale 50 feet = one inch

W. J. Schell
April 30th 1921

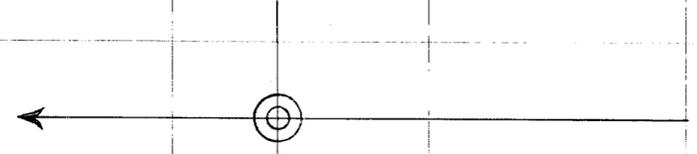

217-312