


T  
S  
R  
Q  
P  
O  
N  
M  
L  
K  
J  
I  
H  
C  
F  
E  
D  
C  
B  
A

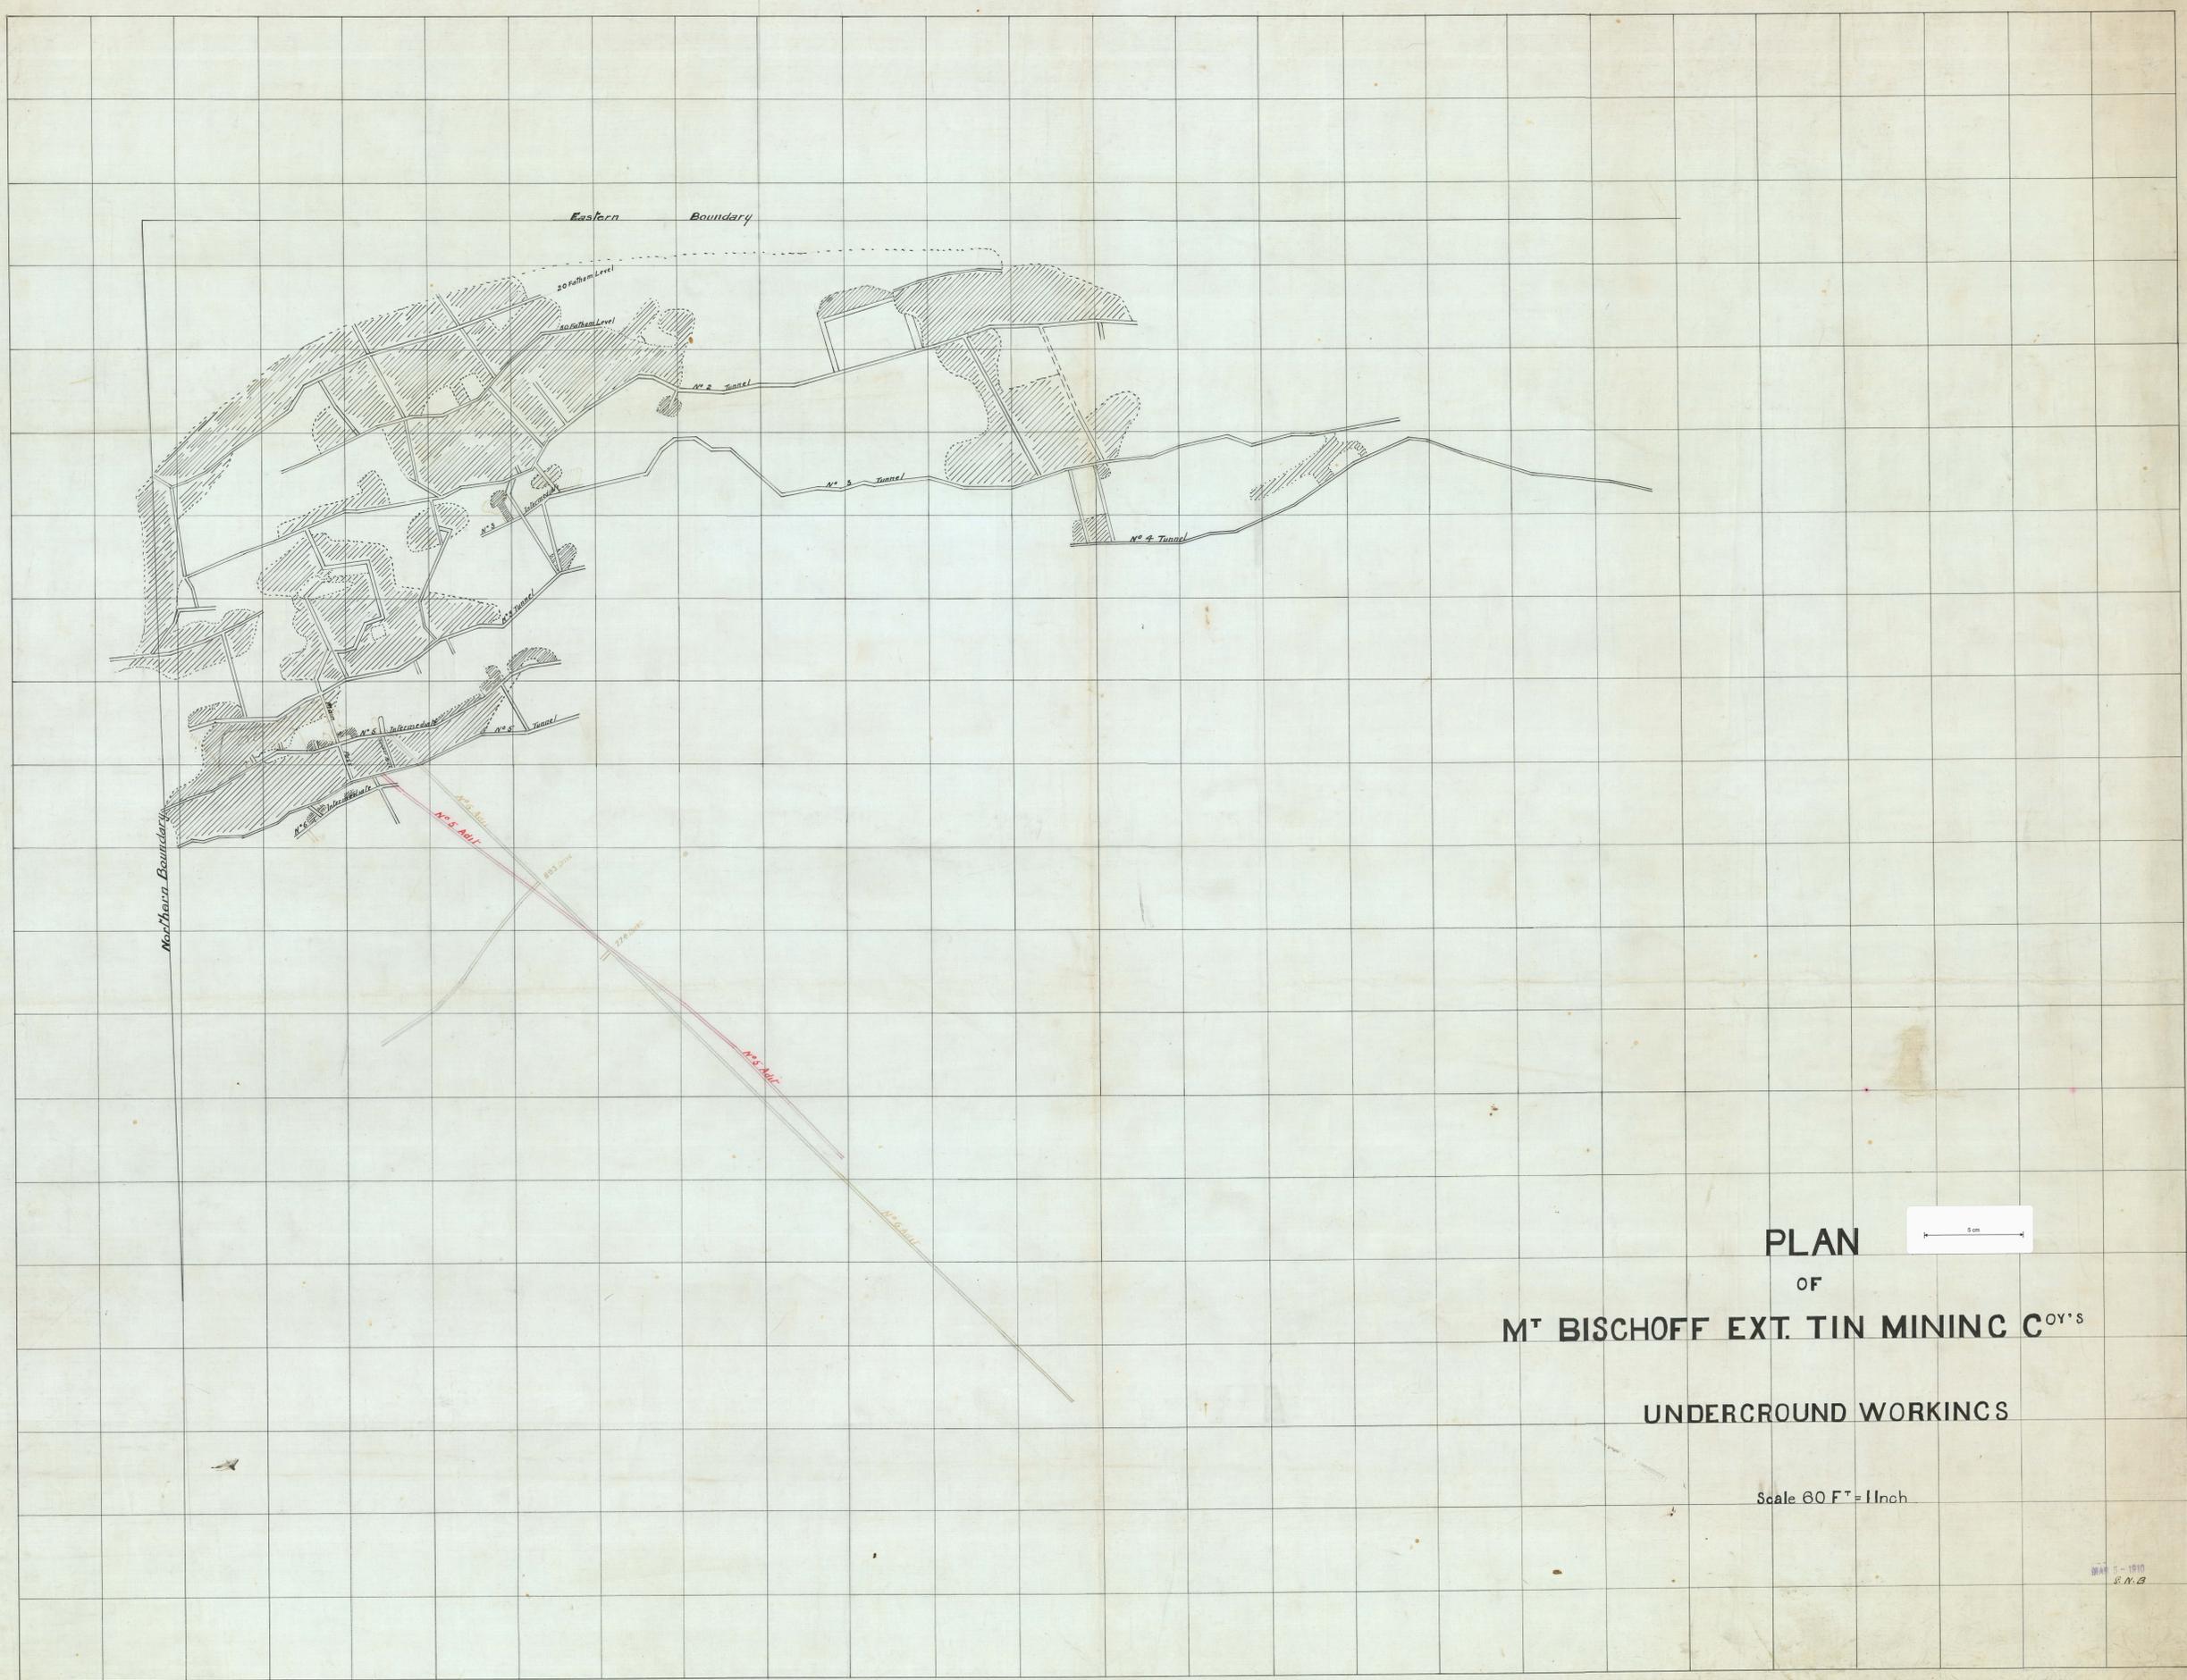

PLAN  
OF  
M<sup>r</sup> BISCHOFF EXT. TIN MINING COY'S  
UNDERGROUND WORKINGS

Scale 60 F<sup>t</sup> = 1 Inch

MAY 5 - 1910  
S.M.B.

217-313

26 25 24 23 22 21 20 19 18 17 16 15 14 13 12 11 10 9 8 7 6 5 4 3 2 1