

Mount Bischoff Extended T. M. Co. N. L.

Under-grounds workings 1919


Scale 50' = 1"

217-315

5 cm

NORTHERN BOUNDARY.

217-312

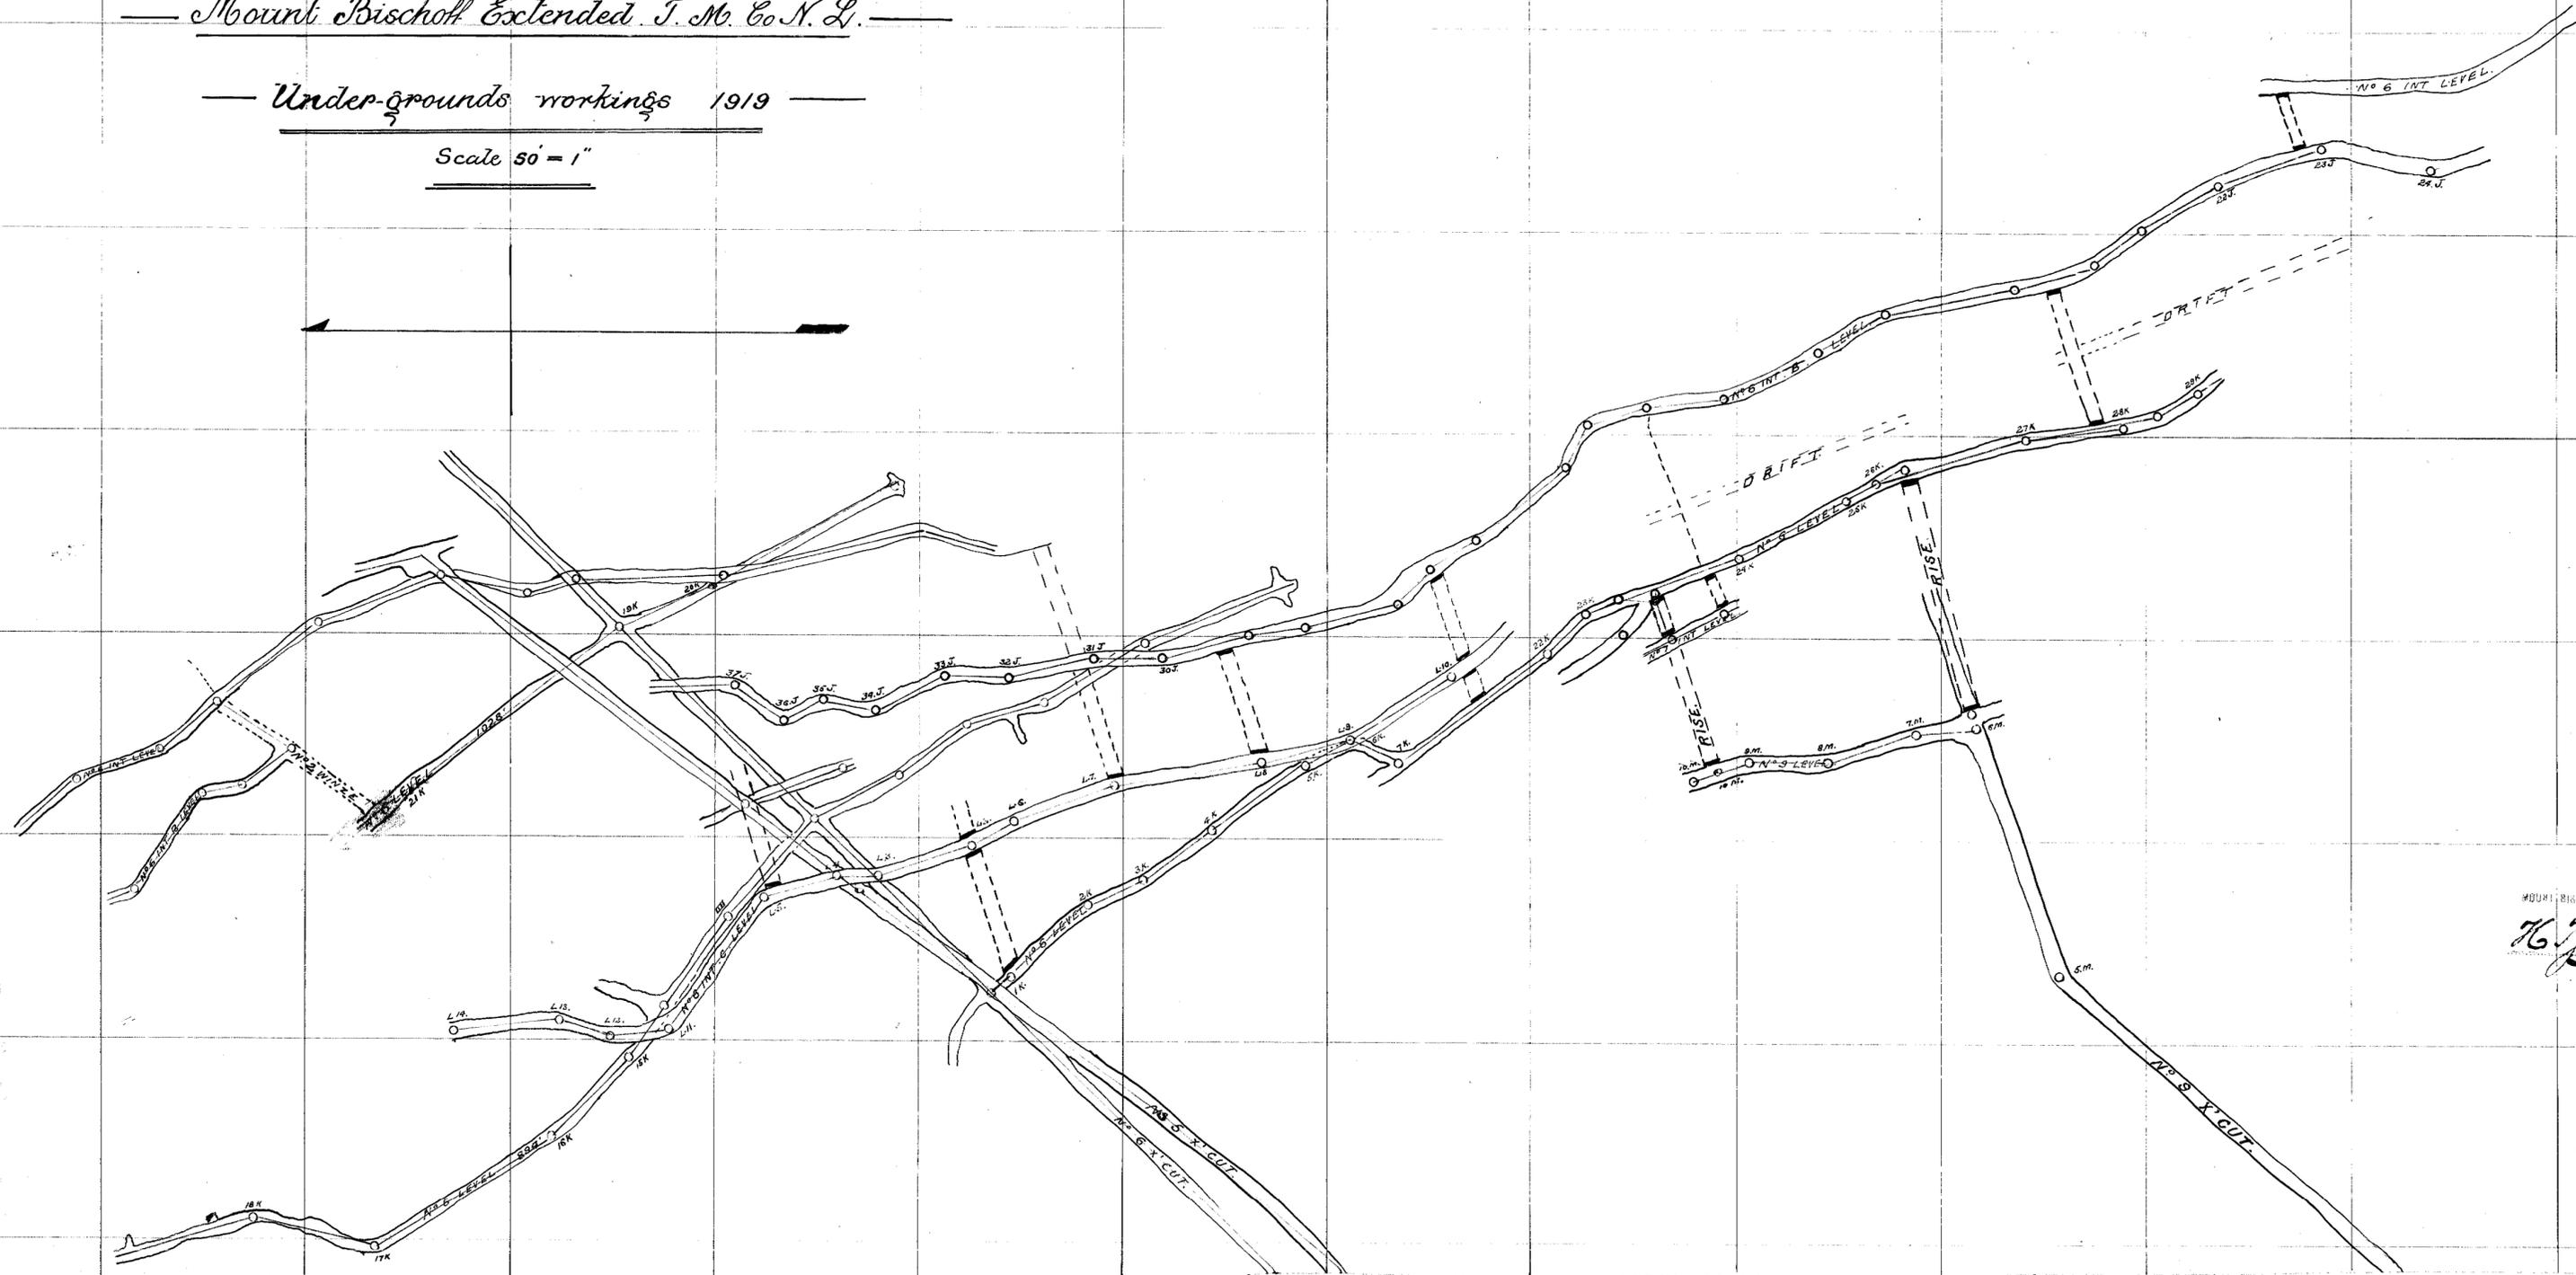

MOUNT BISCHOFF EXTENDED T. M. CO. N. L. COMPANY  
H. J. Schell  
MINE MANAGER