


217-317

217-317

5 cm

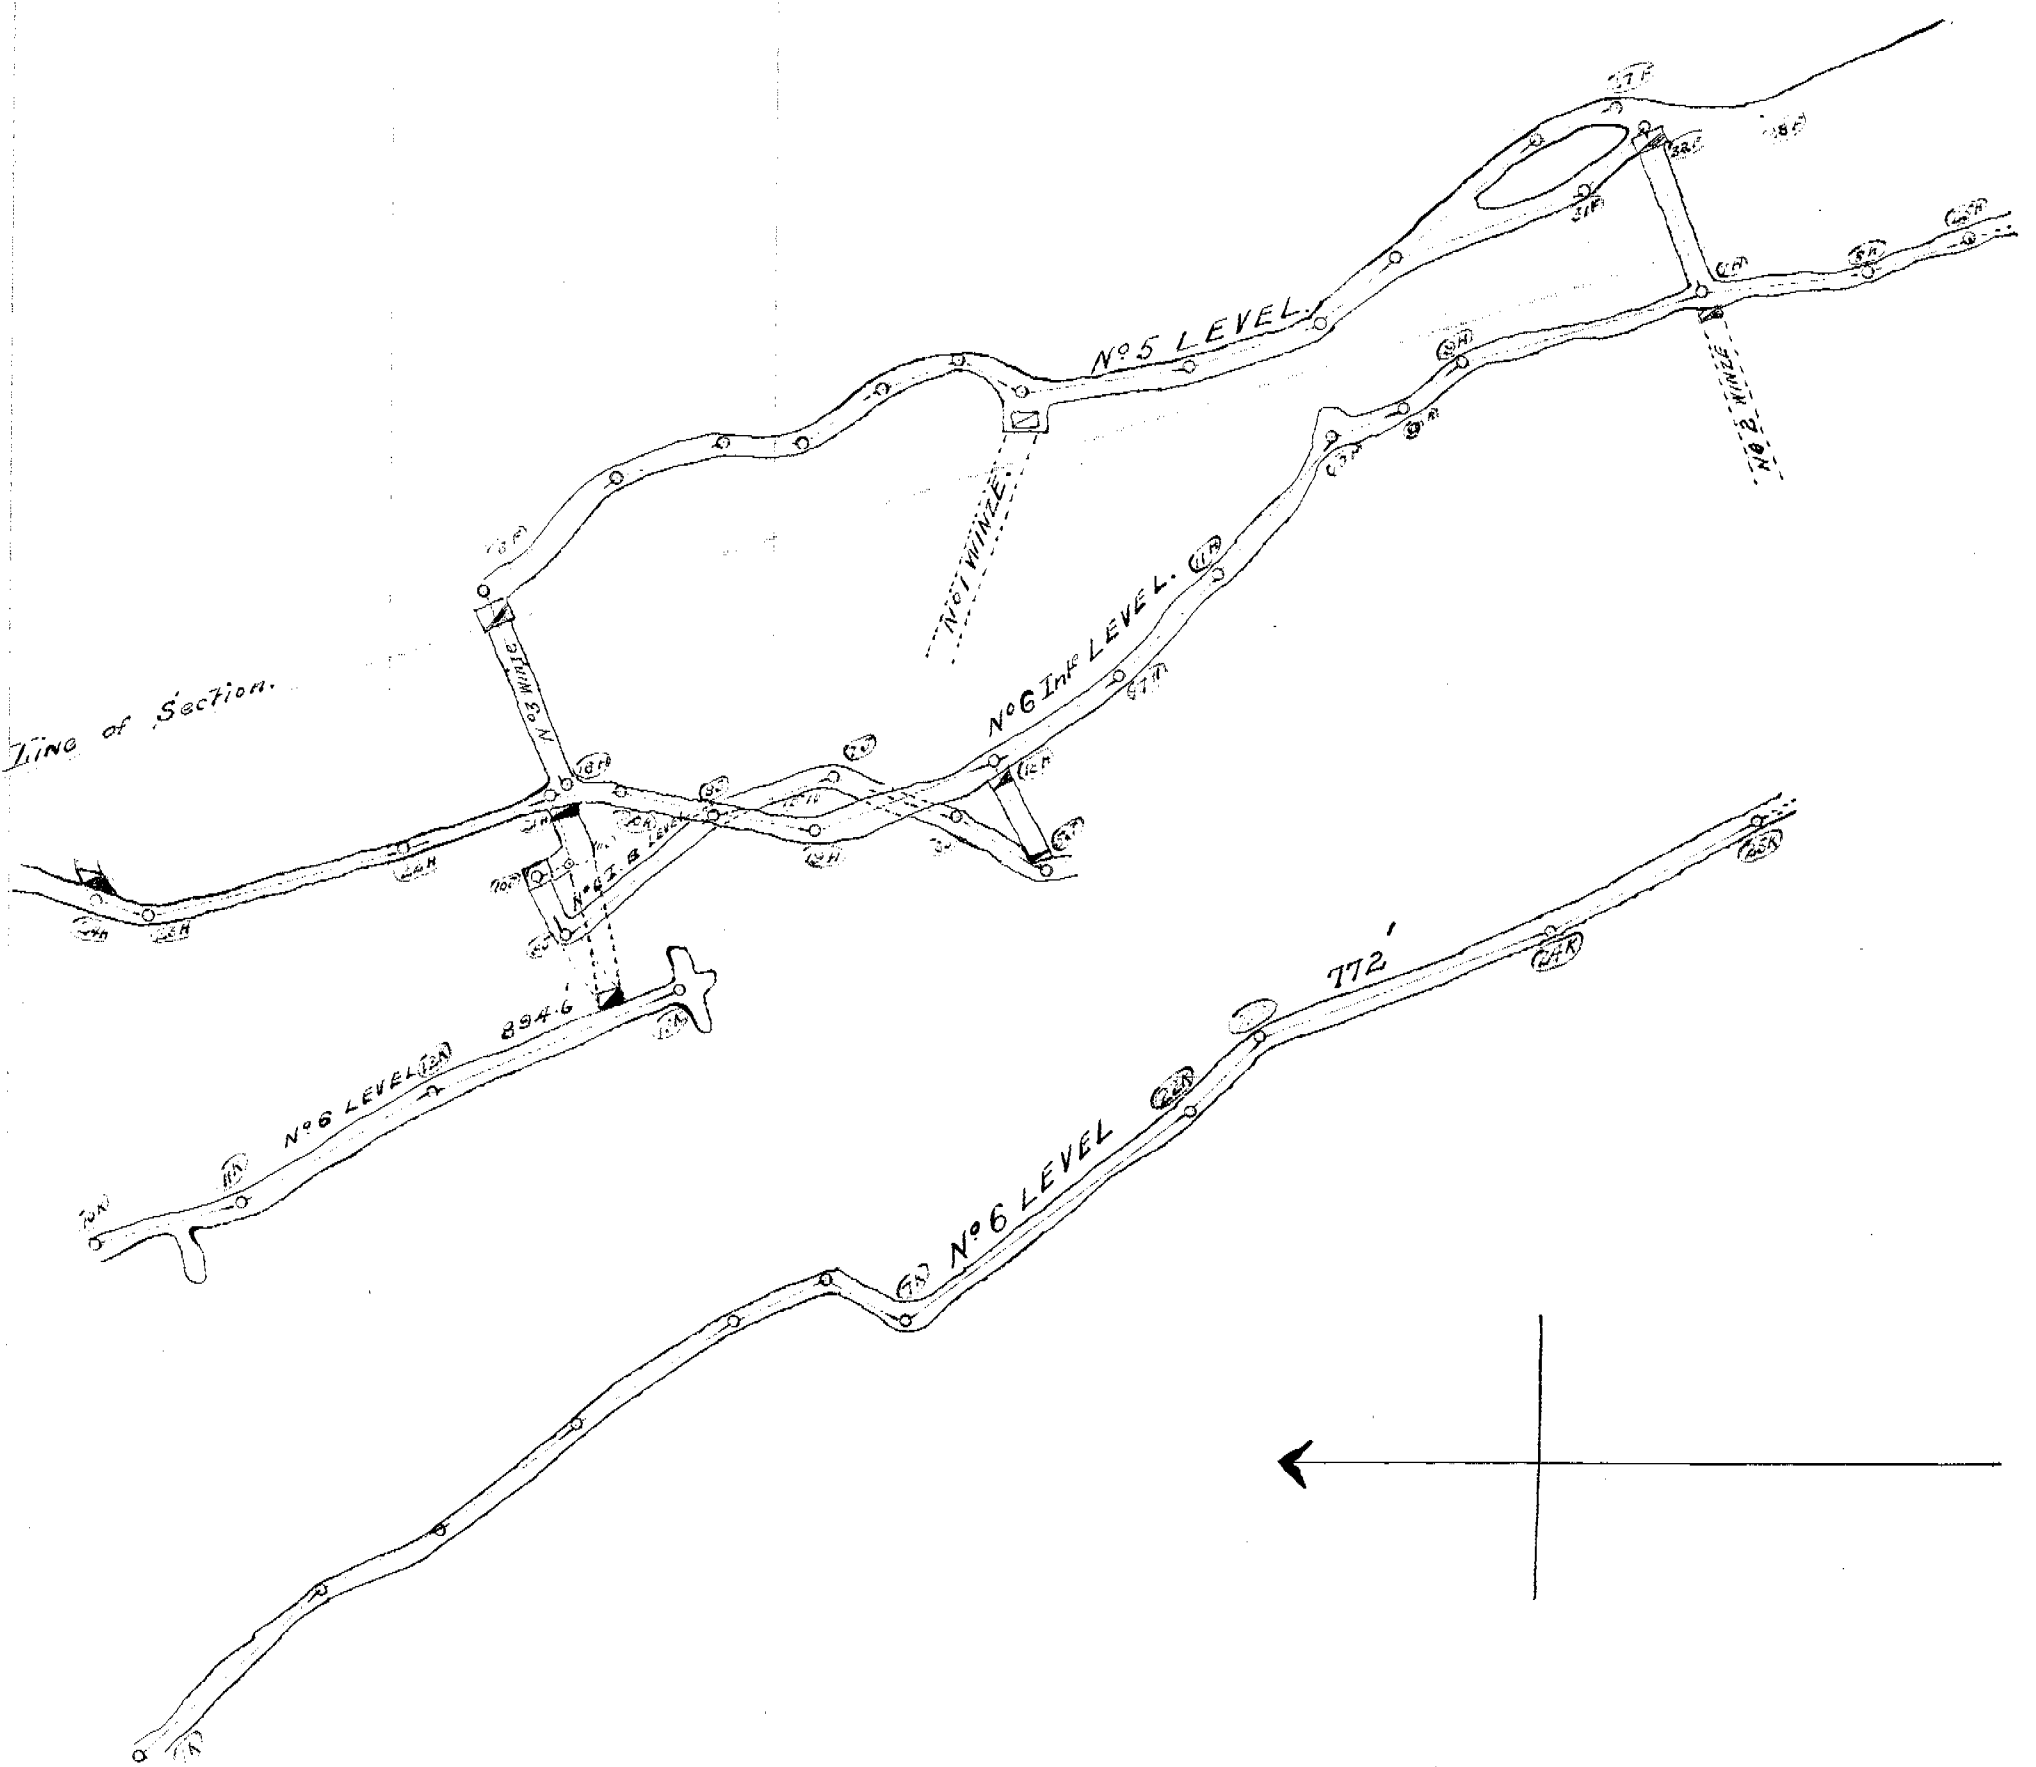

Mount Bischoff Extended Tin Mining Co. Ltd.
Extensions Etc 1915.
Scale 50' = 1"

MOUNT BISCHOFF EXTENDED TIN MINING COMPANY

C.W. Mason
MINE MANAGER

28 FEB 1916

H. J. Schell
Mine Surveyor