


**MOUNT BISCHOFF TIN MINE
NORTH VALLEY WORKINGS
LONGITUDINAL SECTIONS**

50 0 50 100 Ft
Vert. & Hor. Scale

Based on surveys by A. S. Clark
and
C. L. Knight


MAIN LODE

(Projected on to vertical plane bearing N 41° W)

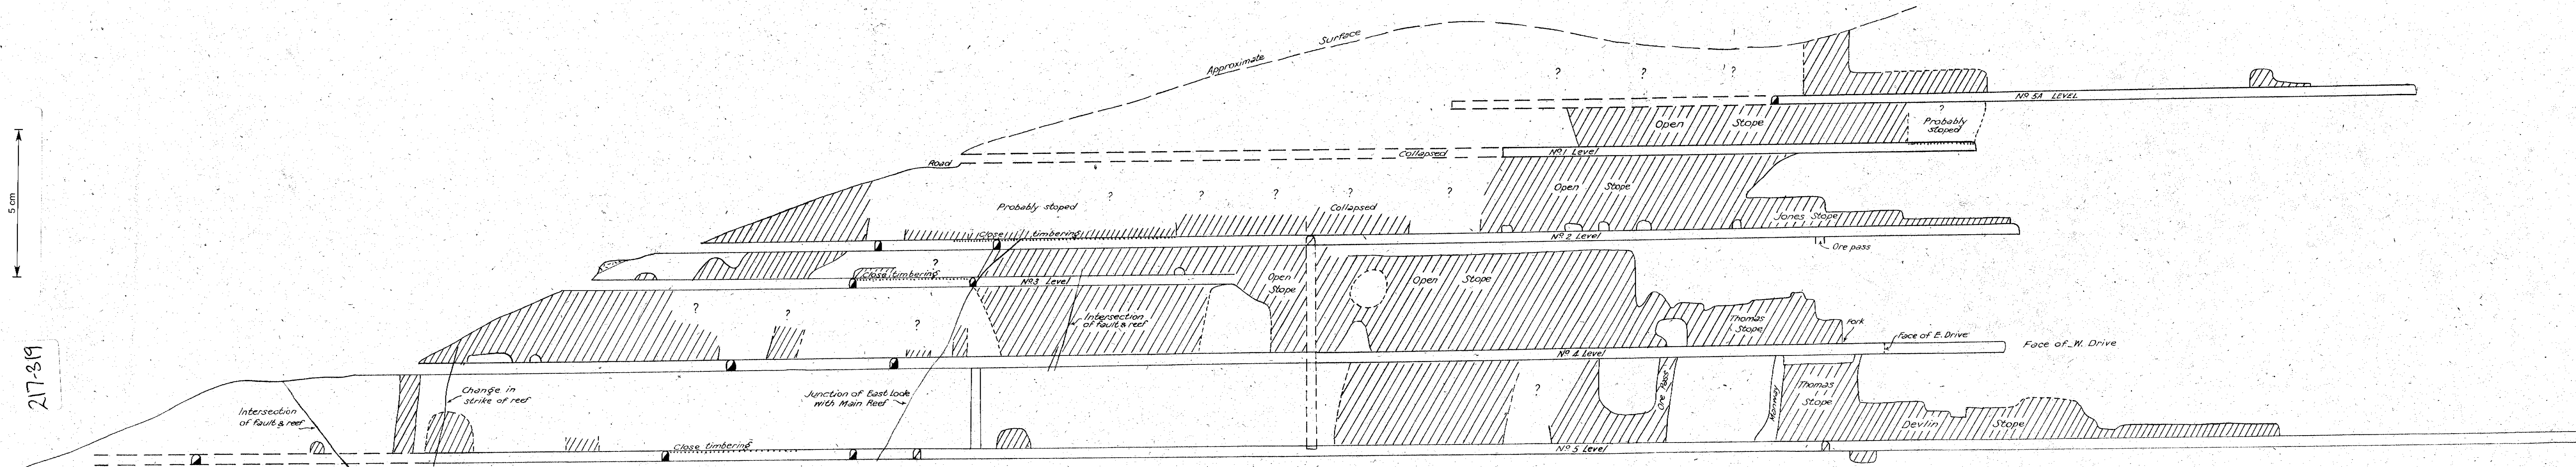

EAST LODE

(Projected on to vertical plane bearing N 16° W)

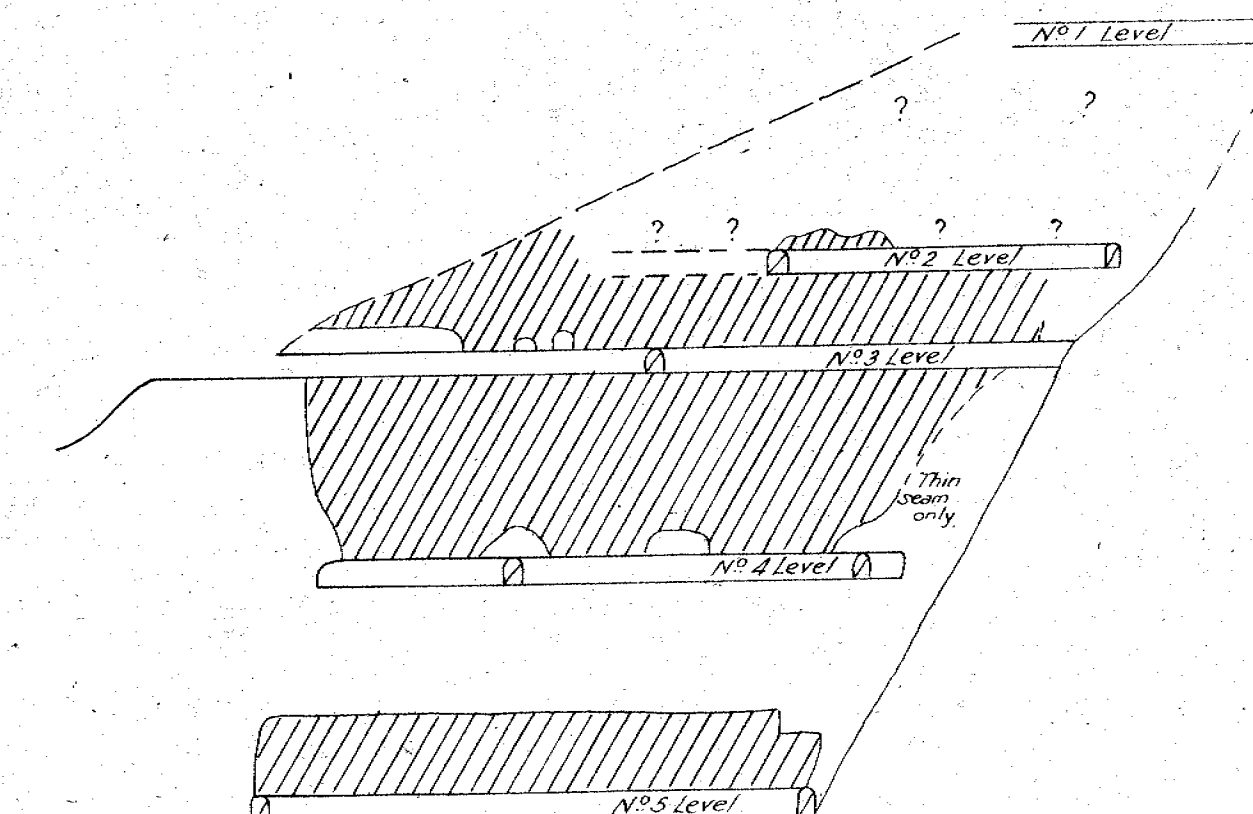

C. L. Knight
Geologist
Mineral Resources Survey
1888