


THE MOUNT BISCHOFF T.M. COMPANY.


LESSEES

Sec 7.
THE MOUNT BISCHOFF T.M. COMPANY
LESSEES

PLAN
OF
MT BISCHOFF EXT TIN. M. COMPANY'S
UNDERGROUND WORKINGS

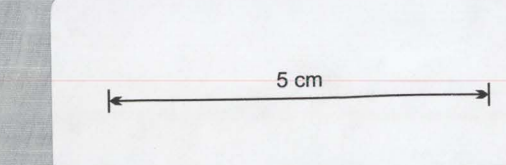

Scale 30 Feet to an inch

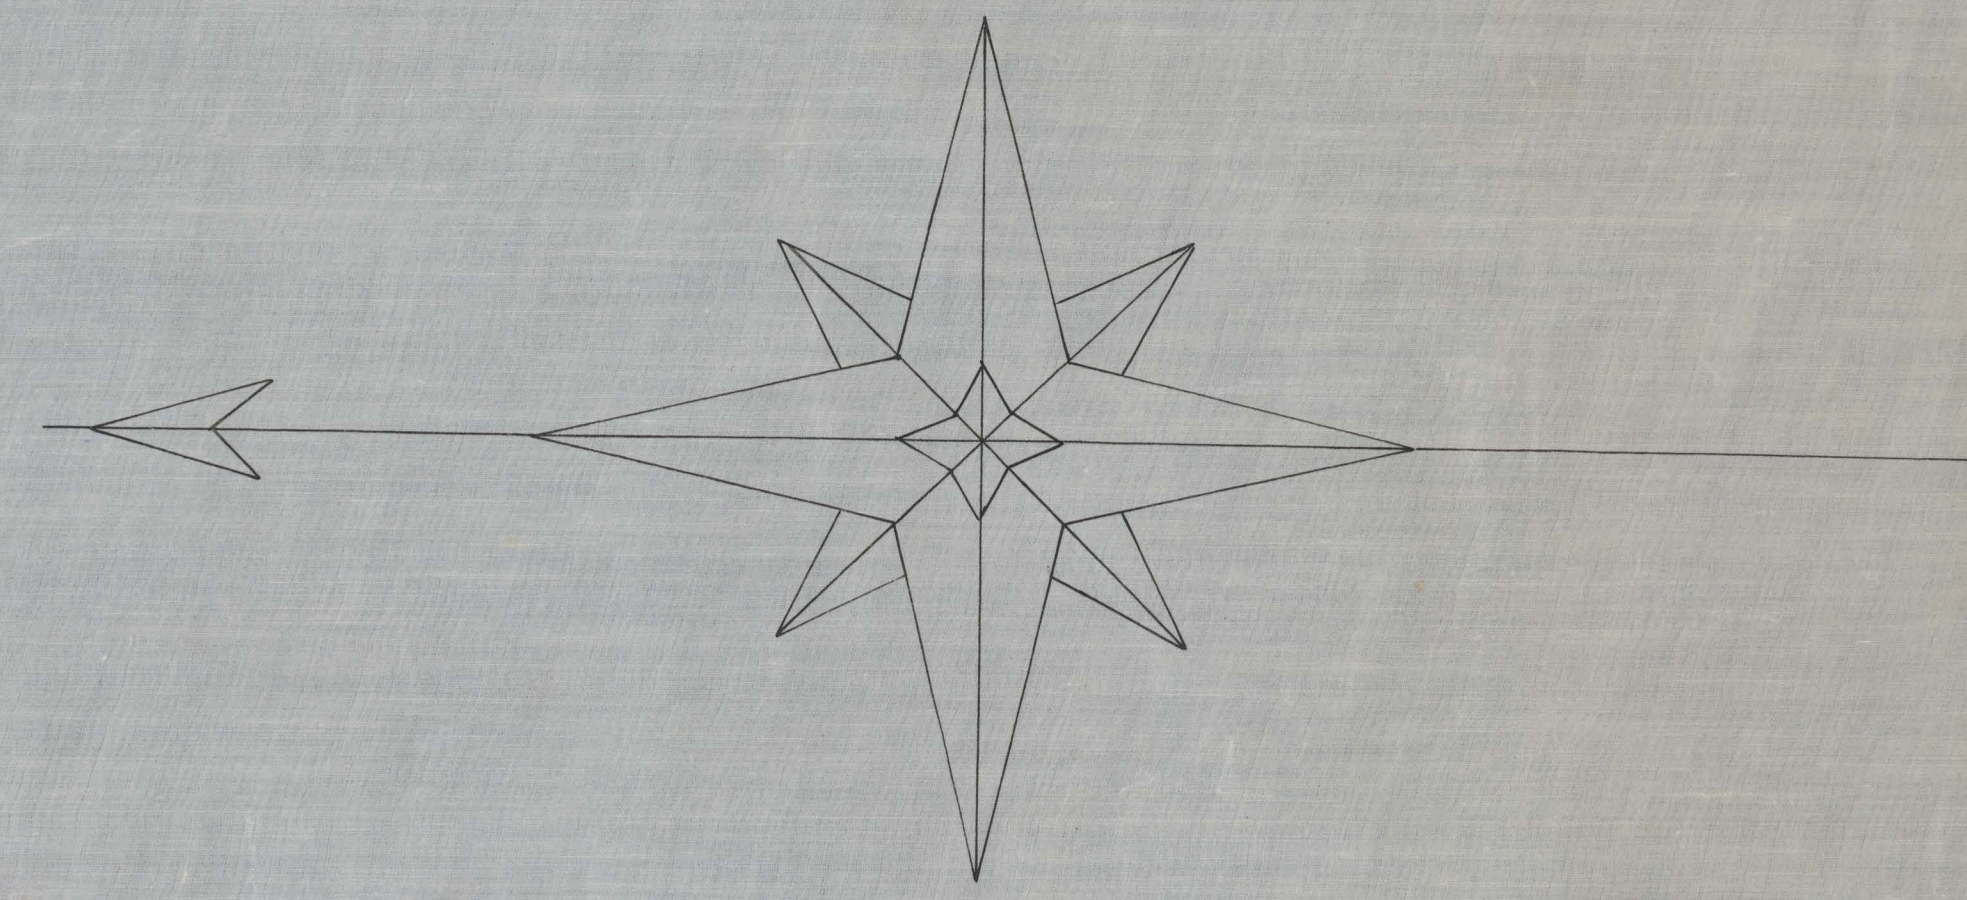

Sec 58.
THE MOUNT BISCHOFF T.M. COMPANY
LESSEES

Oh Wheel Bischoff
Company's Works



I, David Jones, of Maratoh, hereby
declare this plan to be sufficiently
correct for the purposes of the
Mines Act of 1900.

David Jones
District Surveyor,
Maratoh, Tas.
30-6-07

