



M. BISCHOFF EXTENDED TIN MC COY N.L. UNDERGROUND WORKINGS.

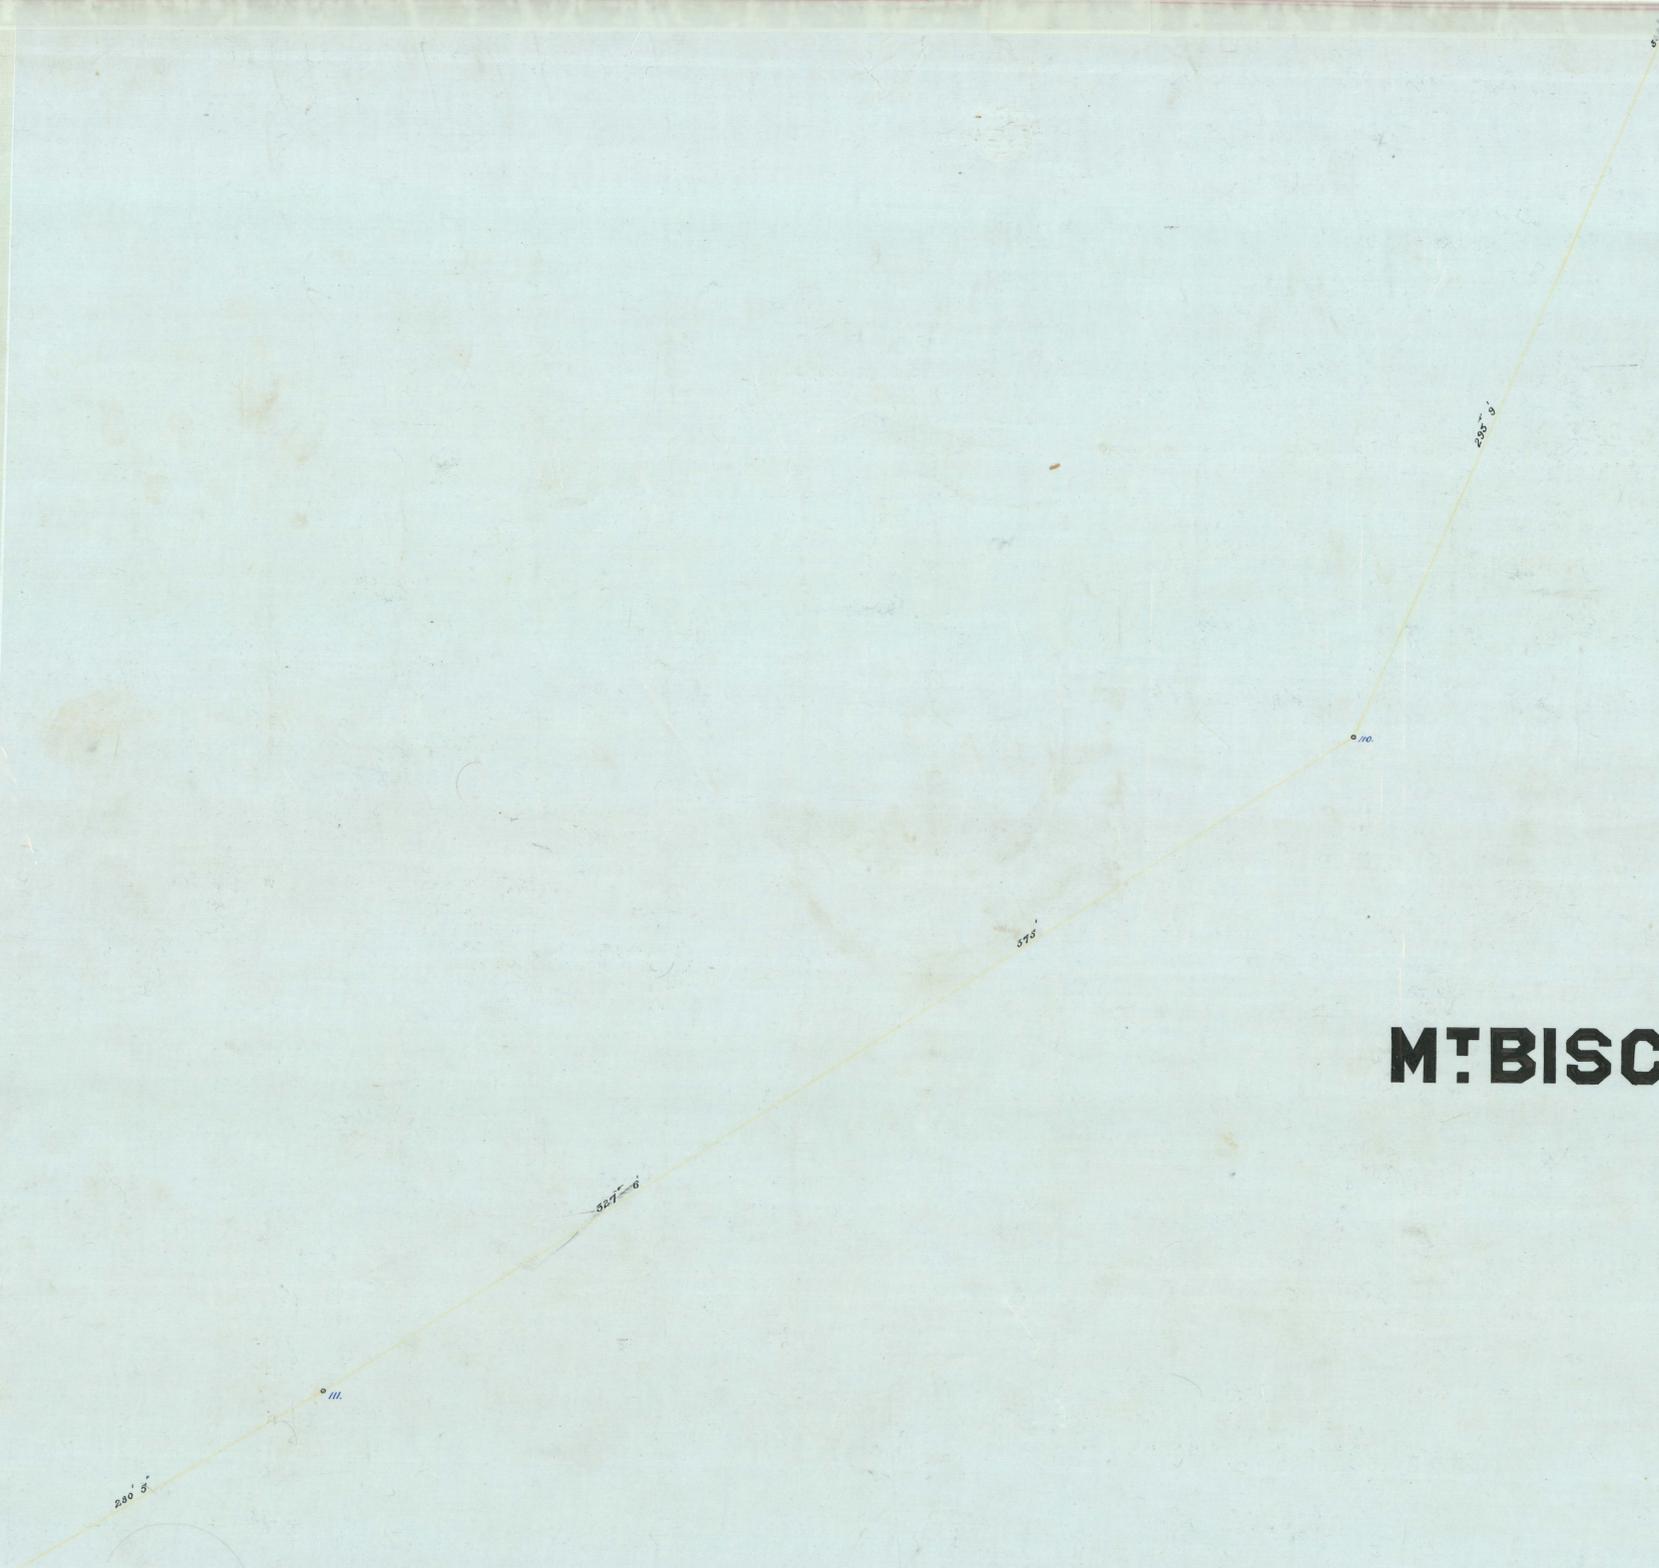

Scale 20 feet to one inch

Survey made with 5" Theodolite
Jones & Co. London, makers.

Reference ——— 27.
Stations marked in Blue figures this
Surface lines marked Green lines
Underground lines marked Red lines
Stops marked in Pale Blue.
Survey made April 1912.

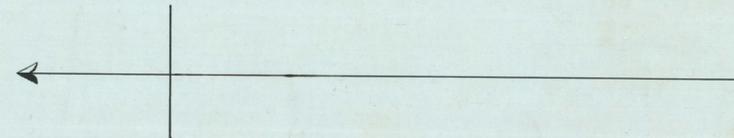

M. BISCHOFF EXTENDED TIN MINING COMPANY
Lonsdale Street
MIDVALE