


217330
217330
217330

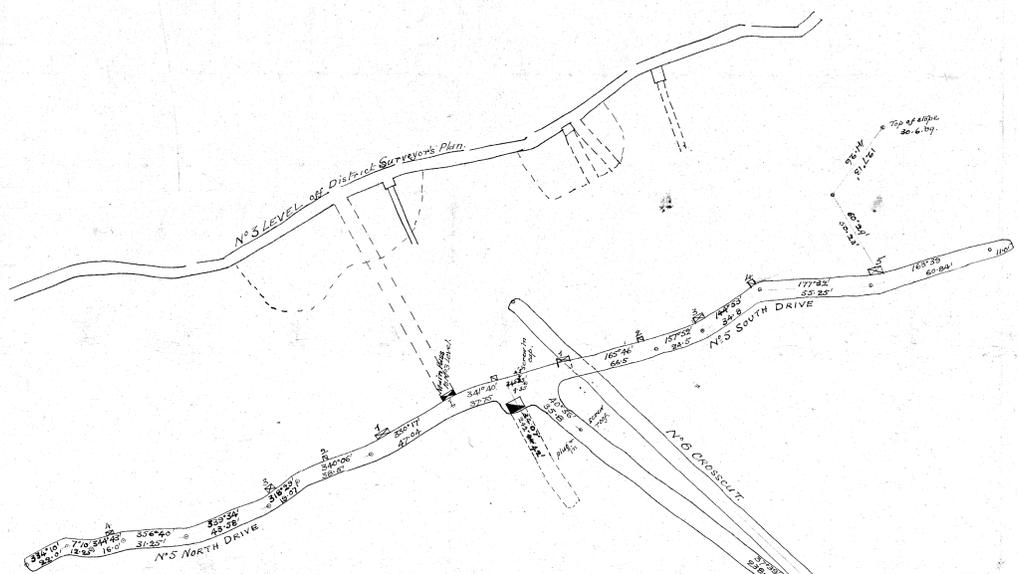


PLAN OF N° 5 + 6 LEVELS

scale of 30 feet to 1 inch.



Troughton & Sims 5" Transit - reading to 30" ~

J. R. Coffey
Surveyor
31.7.09.

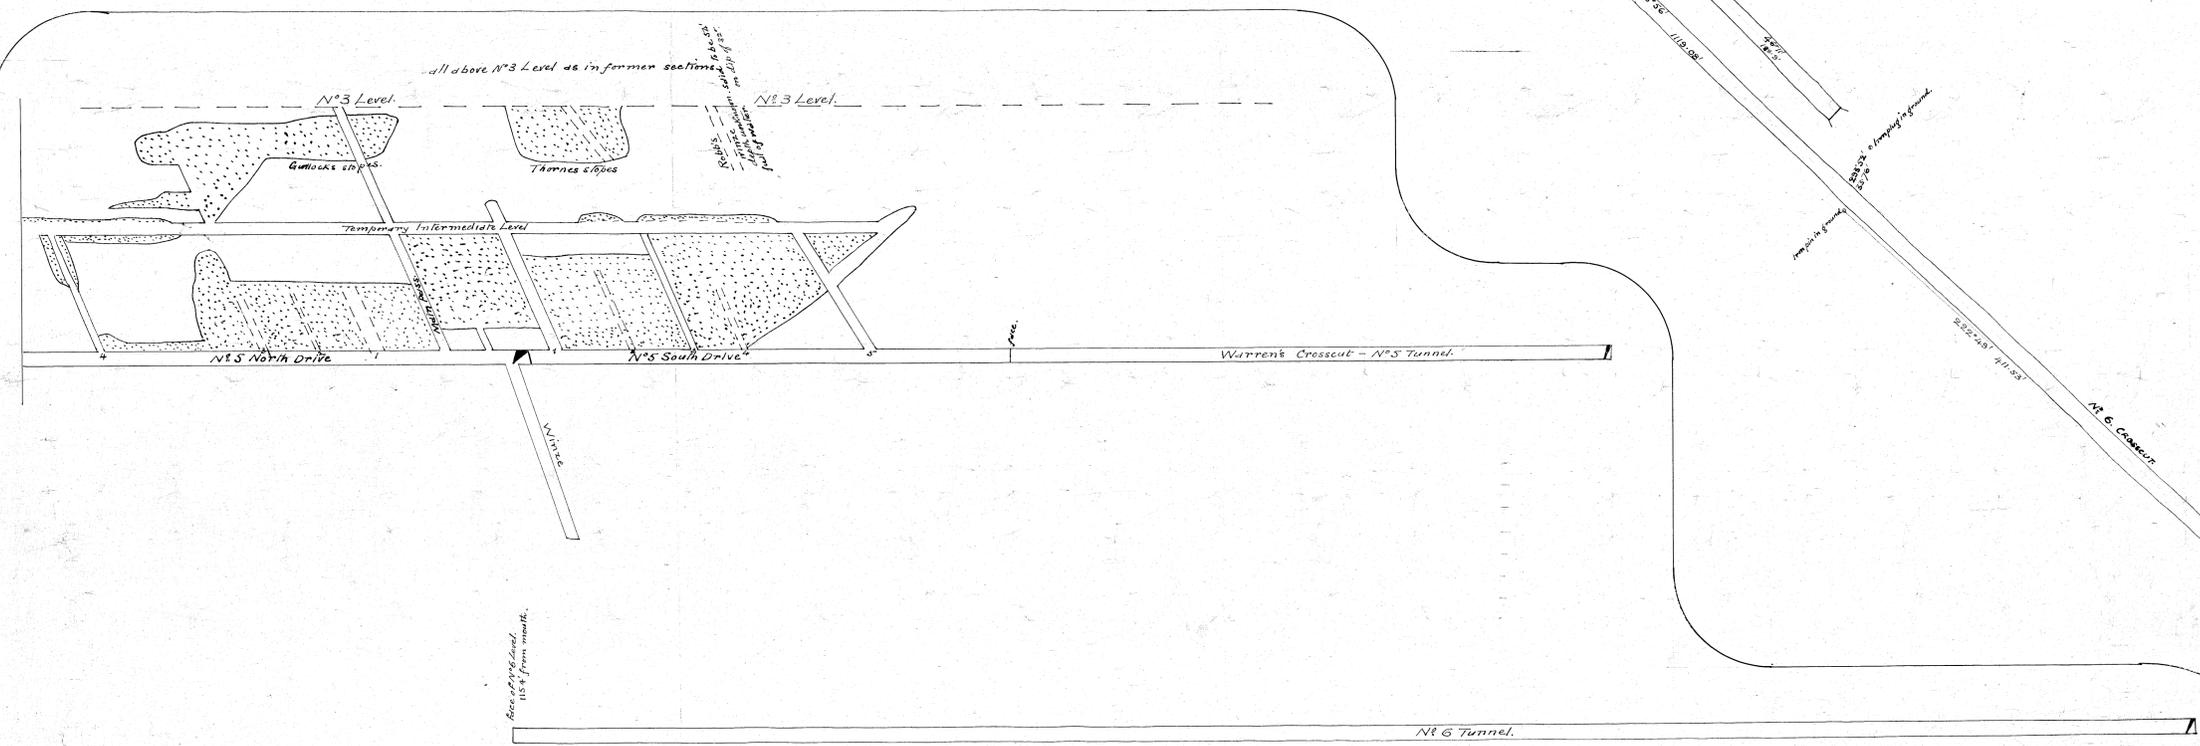

Longitudinal section on N° 6, 5 + 3 Levels - projected on N° 5 line - Scale 30 Feet to 1 inch

217330

217330

217330