


217-356

BRITISH MADE

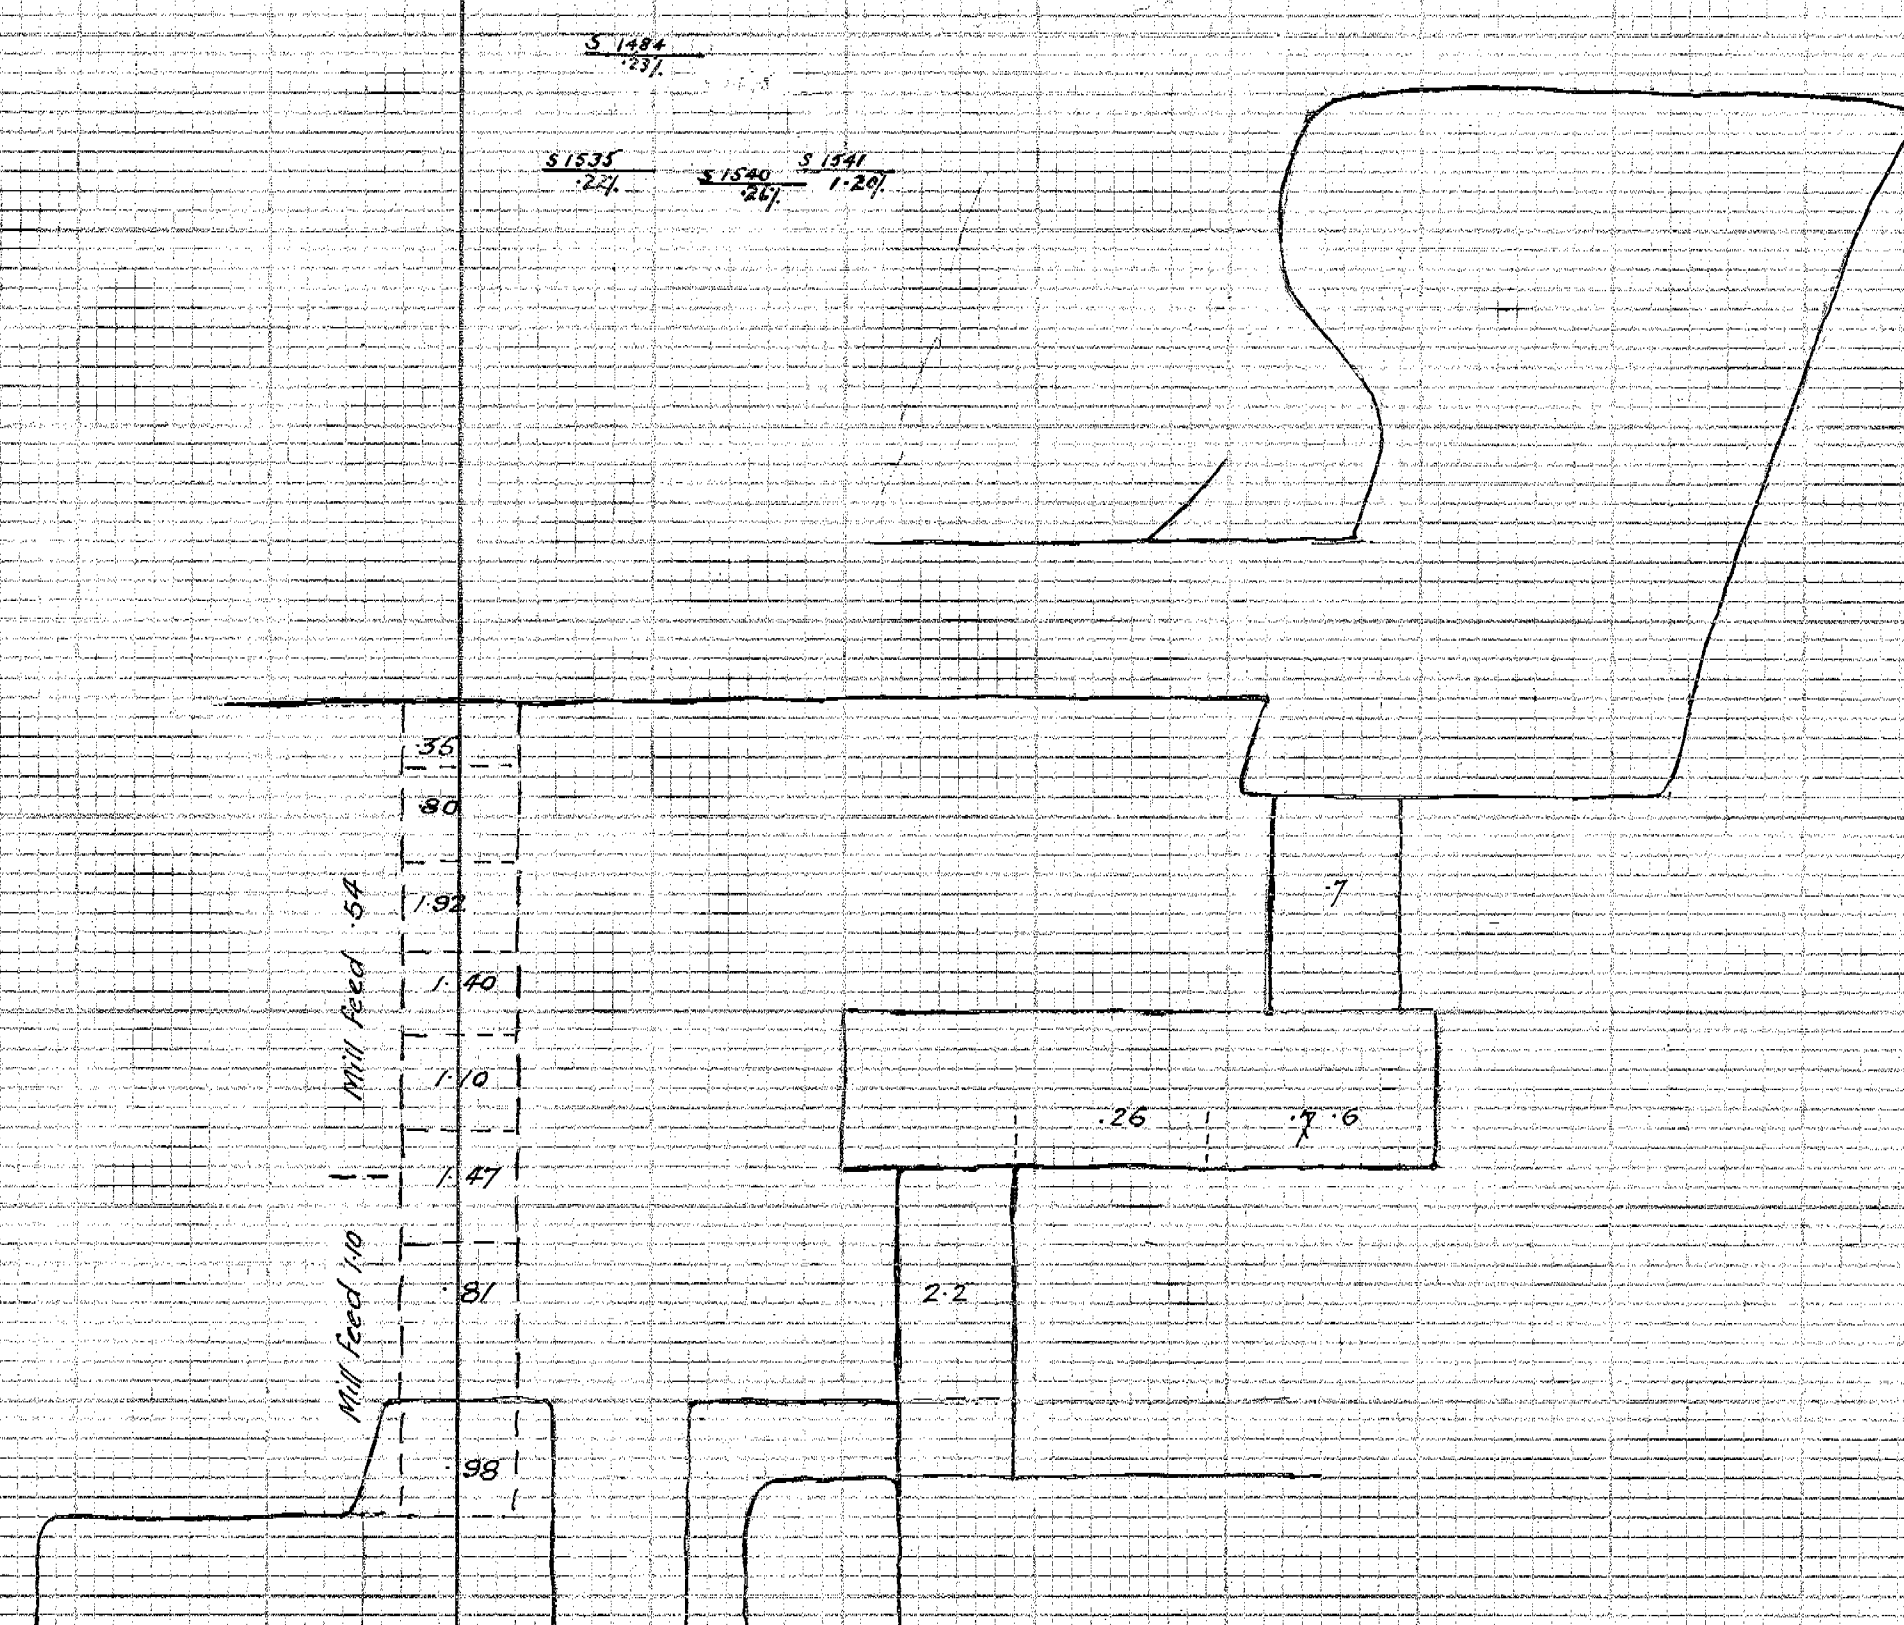

SEALION LINE

TRANSVERSE SECTION AT 250' EAST OF DATUM.