


5 cm

217-361

BRITISH MADE

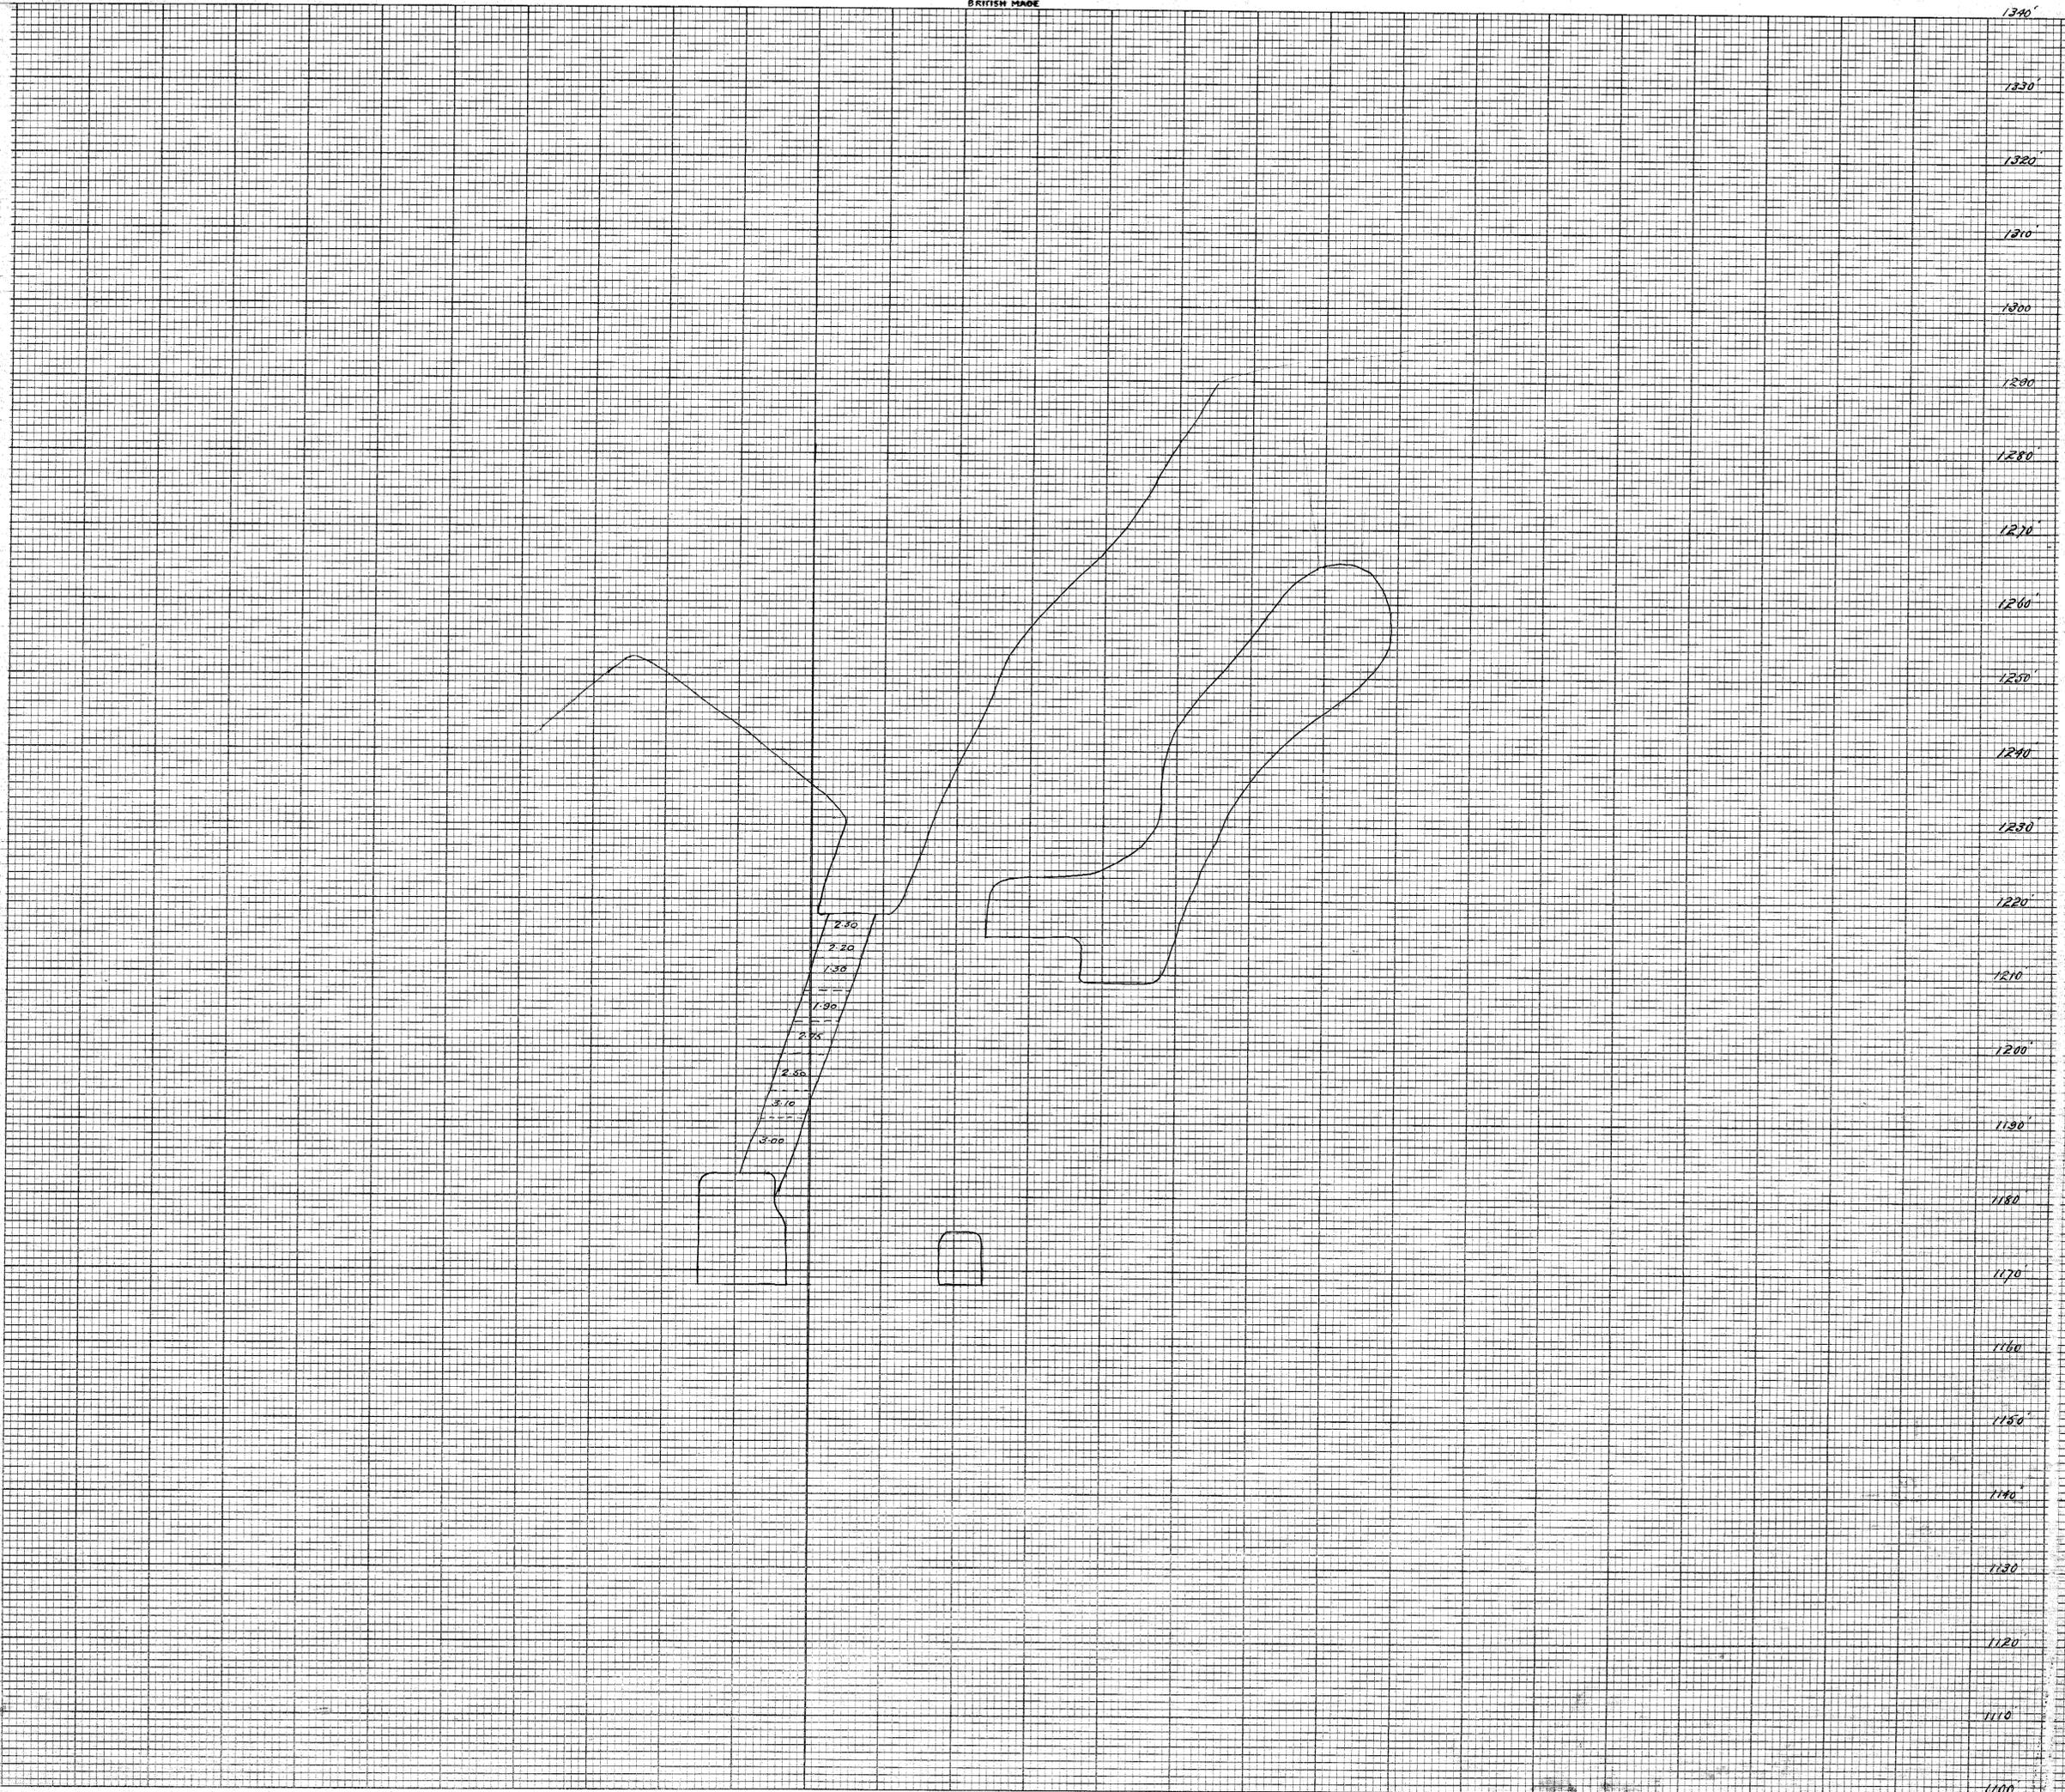

TRANSVERSE SECTION AT 200 EAST OF DATUM