

# SECTIONS






OF

## MOUNT BISCHOFF T. M. COMPANYS

### WHEAL UNDERGROUND WORKS

Scale 50 Feet to one Inch

1886

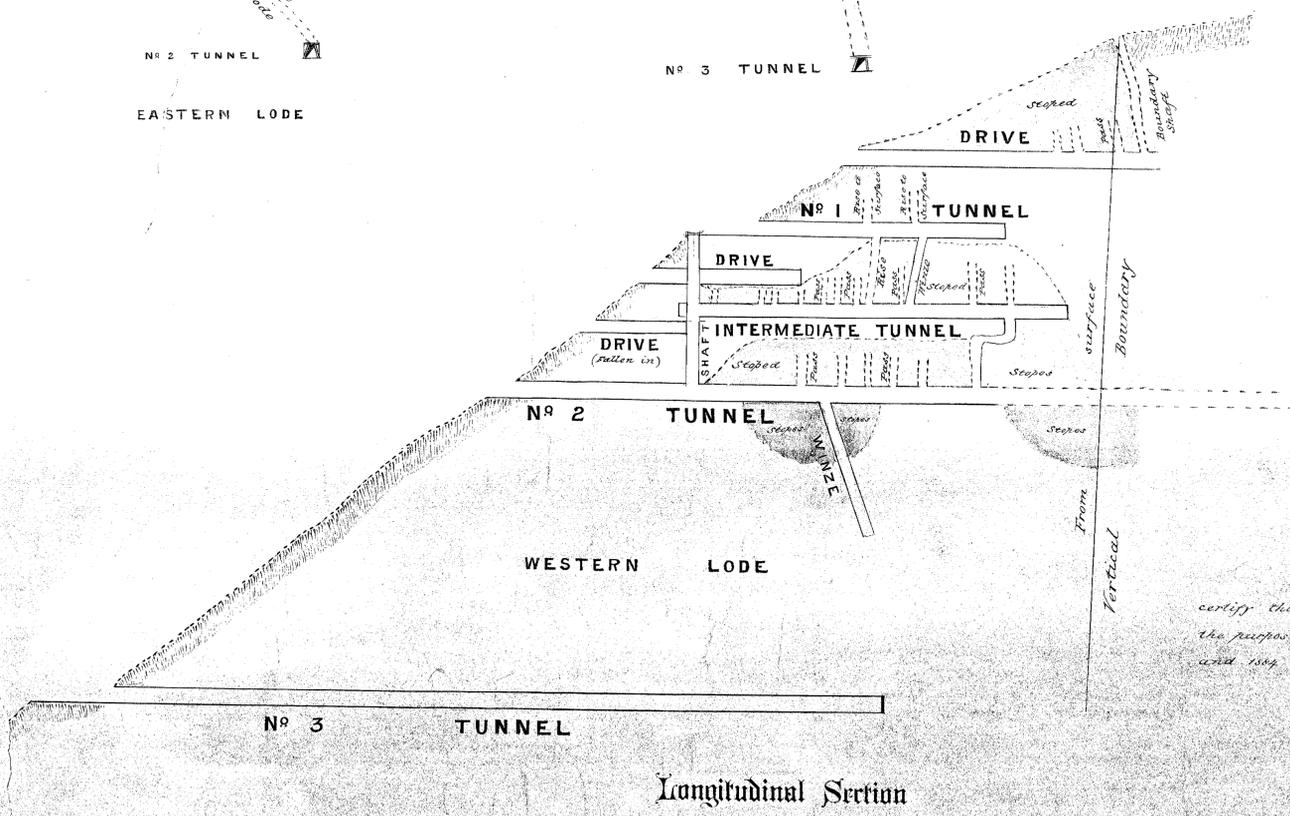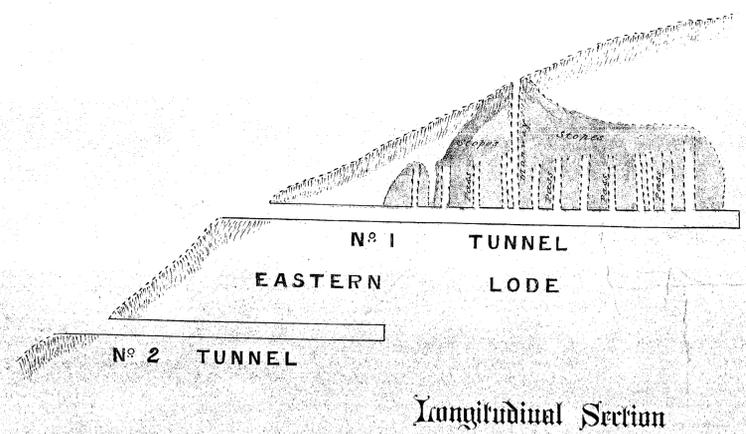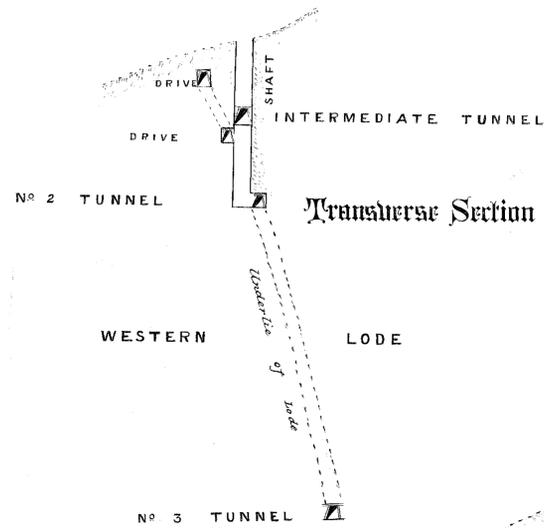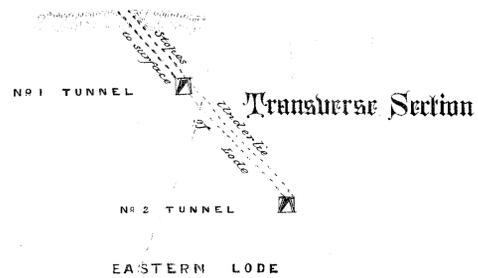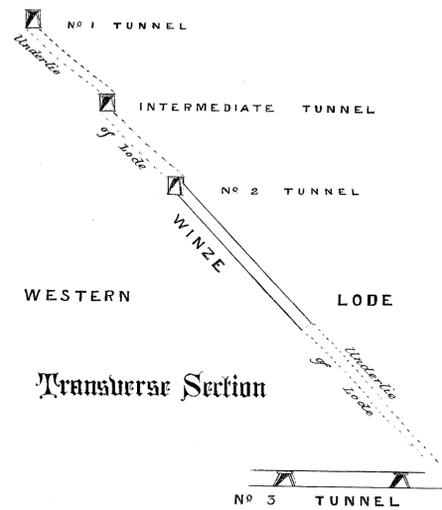

217-363  
5 cm

I, David Jones, Surveyor Warratah, hereby certify that this plan is sufficiently correct for the purposes of the Regulation of Mines Act 1861 and 1862.

David Jones  
Mining Surveyor  
22<sup>nd</sup> February 1886