
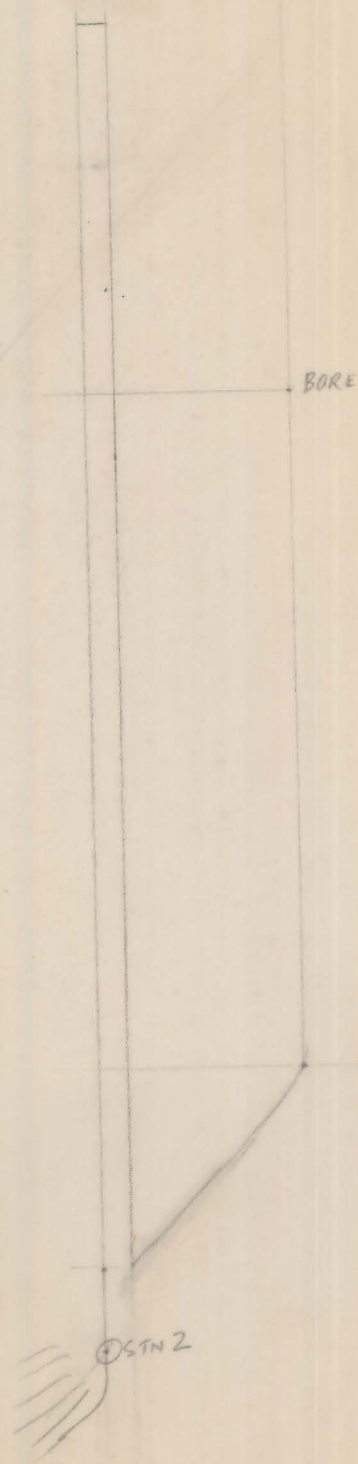
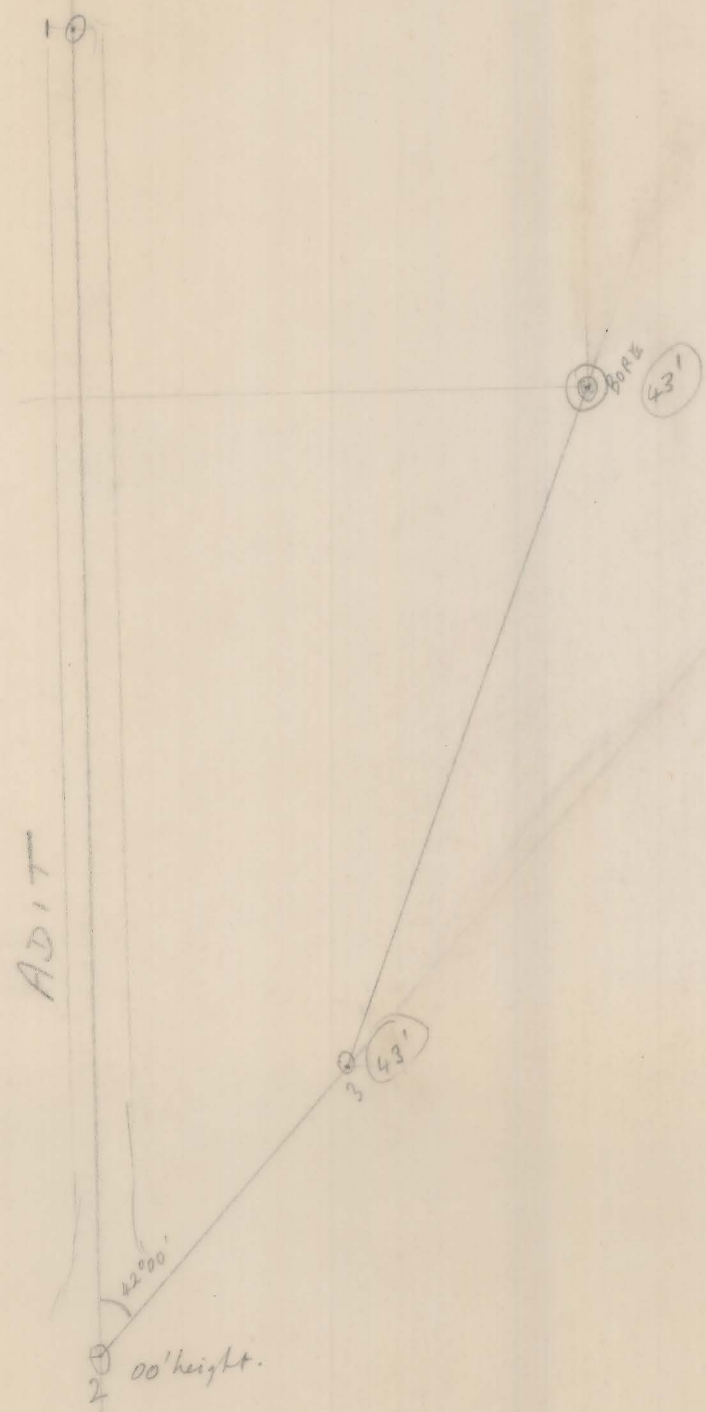


0217-370

E. ALLEN'S TRIBUTARY
GREISEN LODE
MT BISCHOFF

5 cm

0217-370

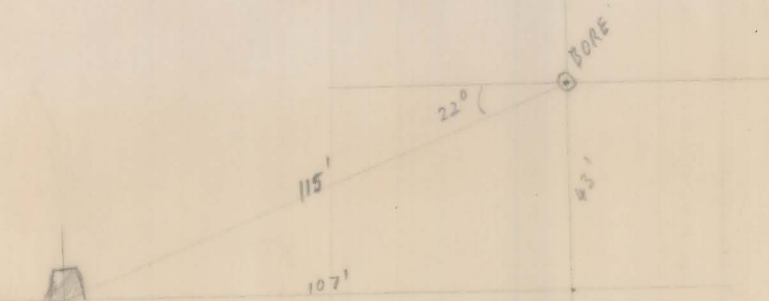

Scale 1" = 40'