


0217-397

G. KENWORTHY

5 cm

0217-397

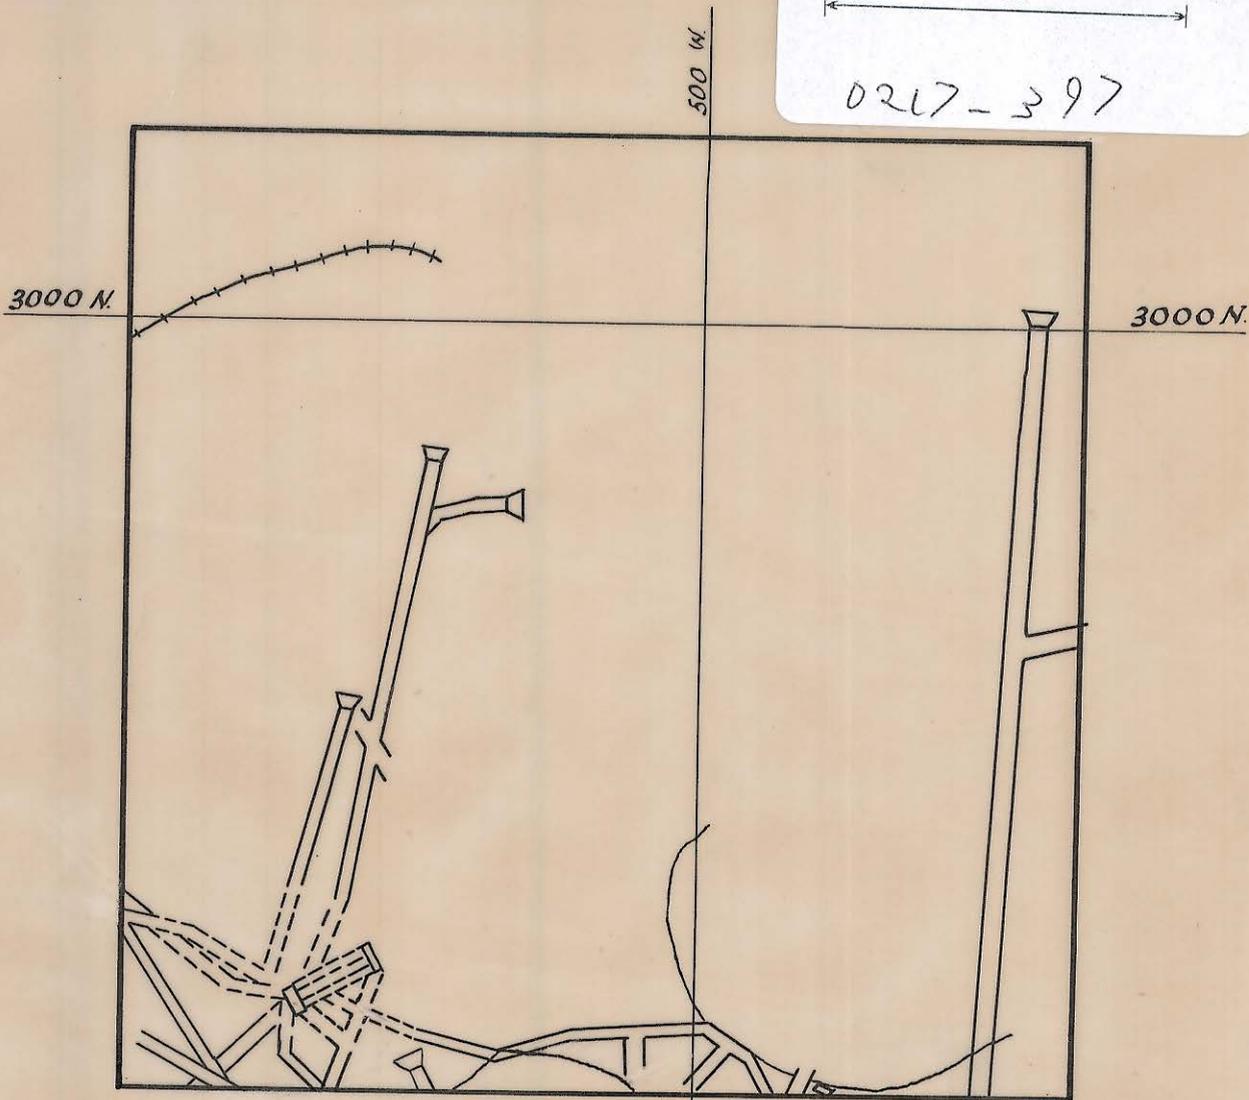

SCALE 1 IN \equiv 100 FT.

See sheet 7 Waratah Tribute Area
K. A. Beatson 1951.

500 W.