


0217-399

**T. J. PROUSE**

5 cm

0217-399

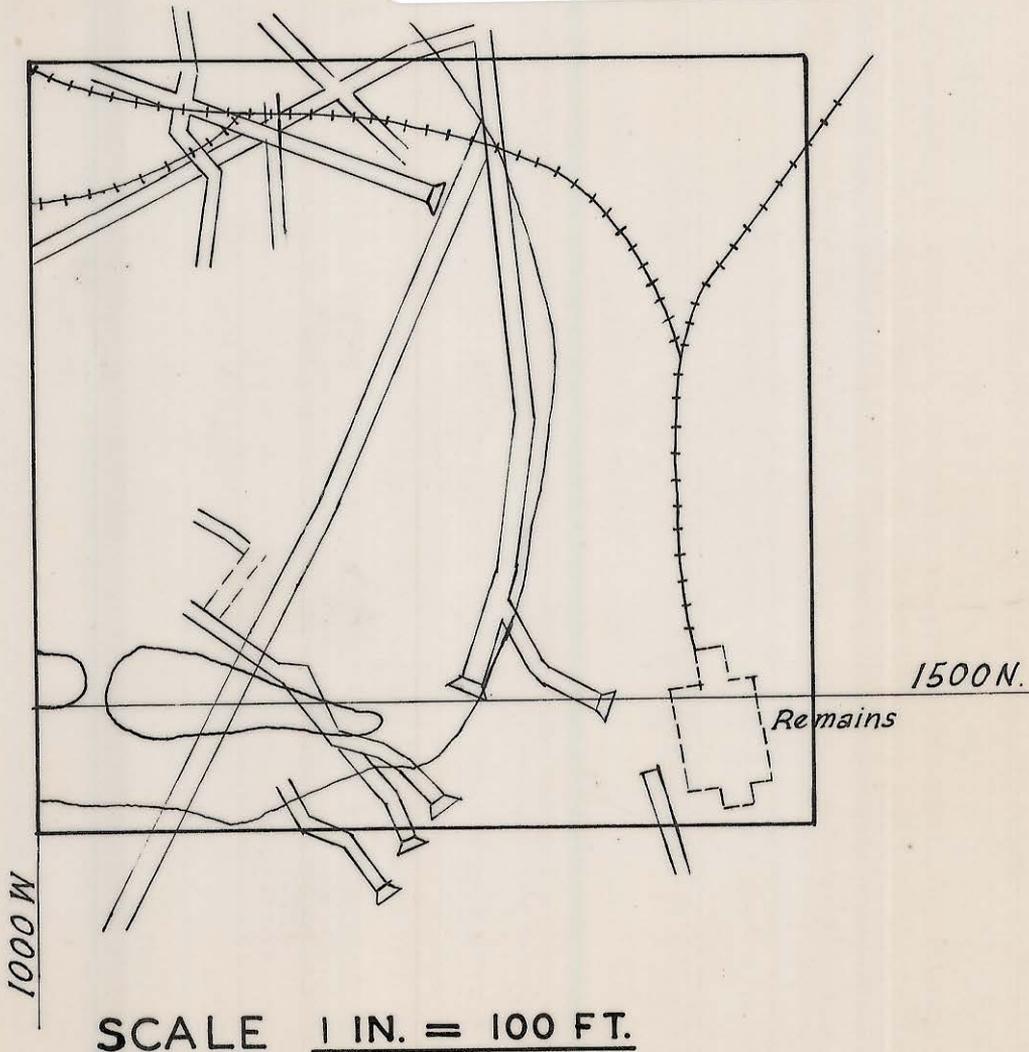

See sheet 5 Waratah Tribute Areas by K. A. Beatson 1951