




PLAN OF WORKINGS

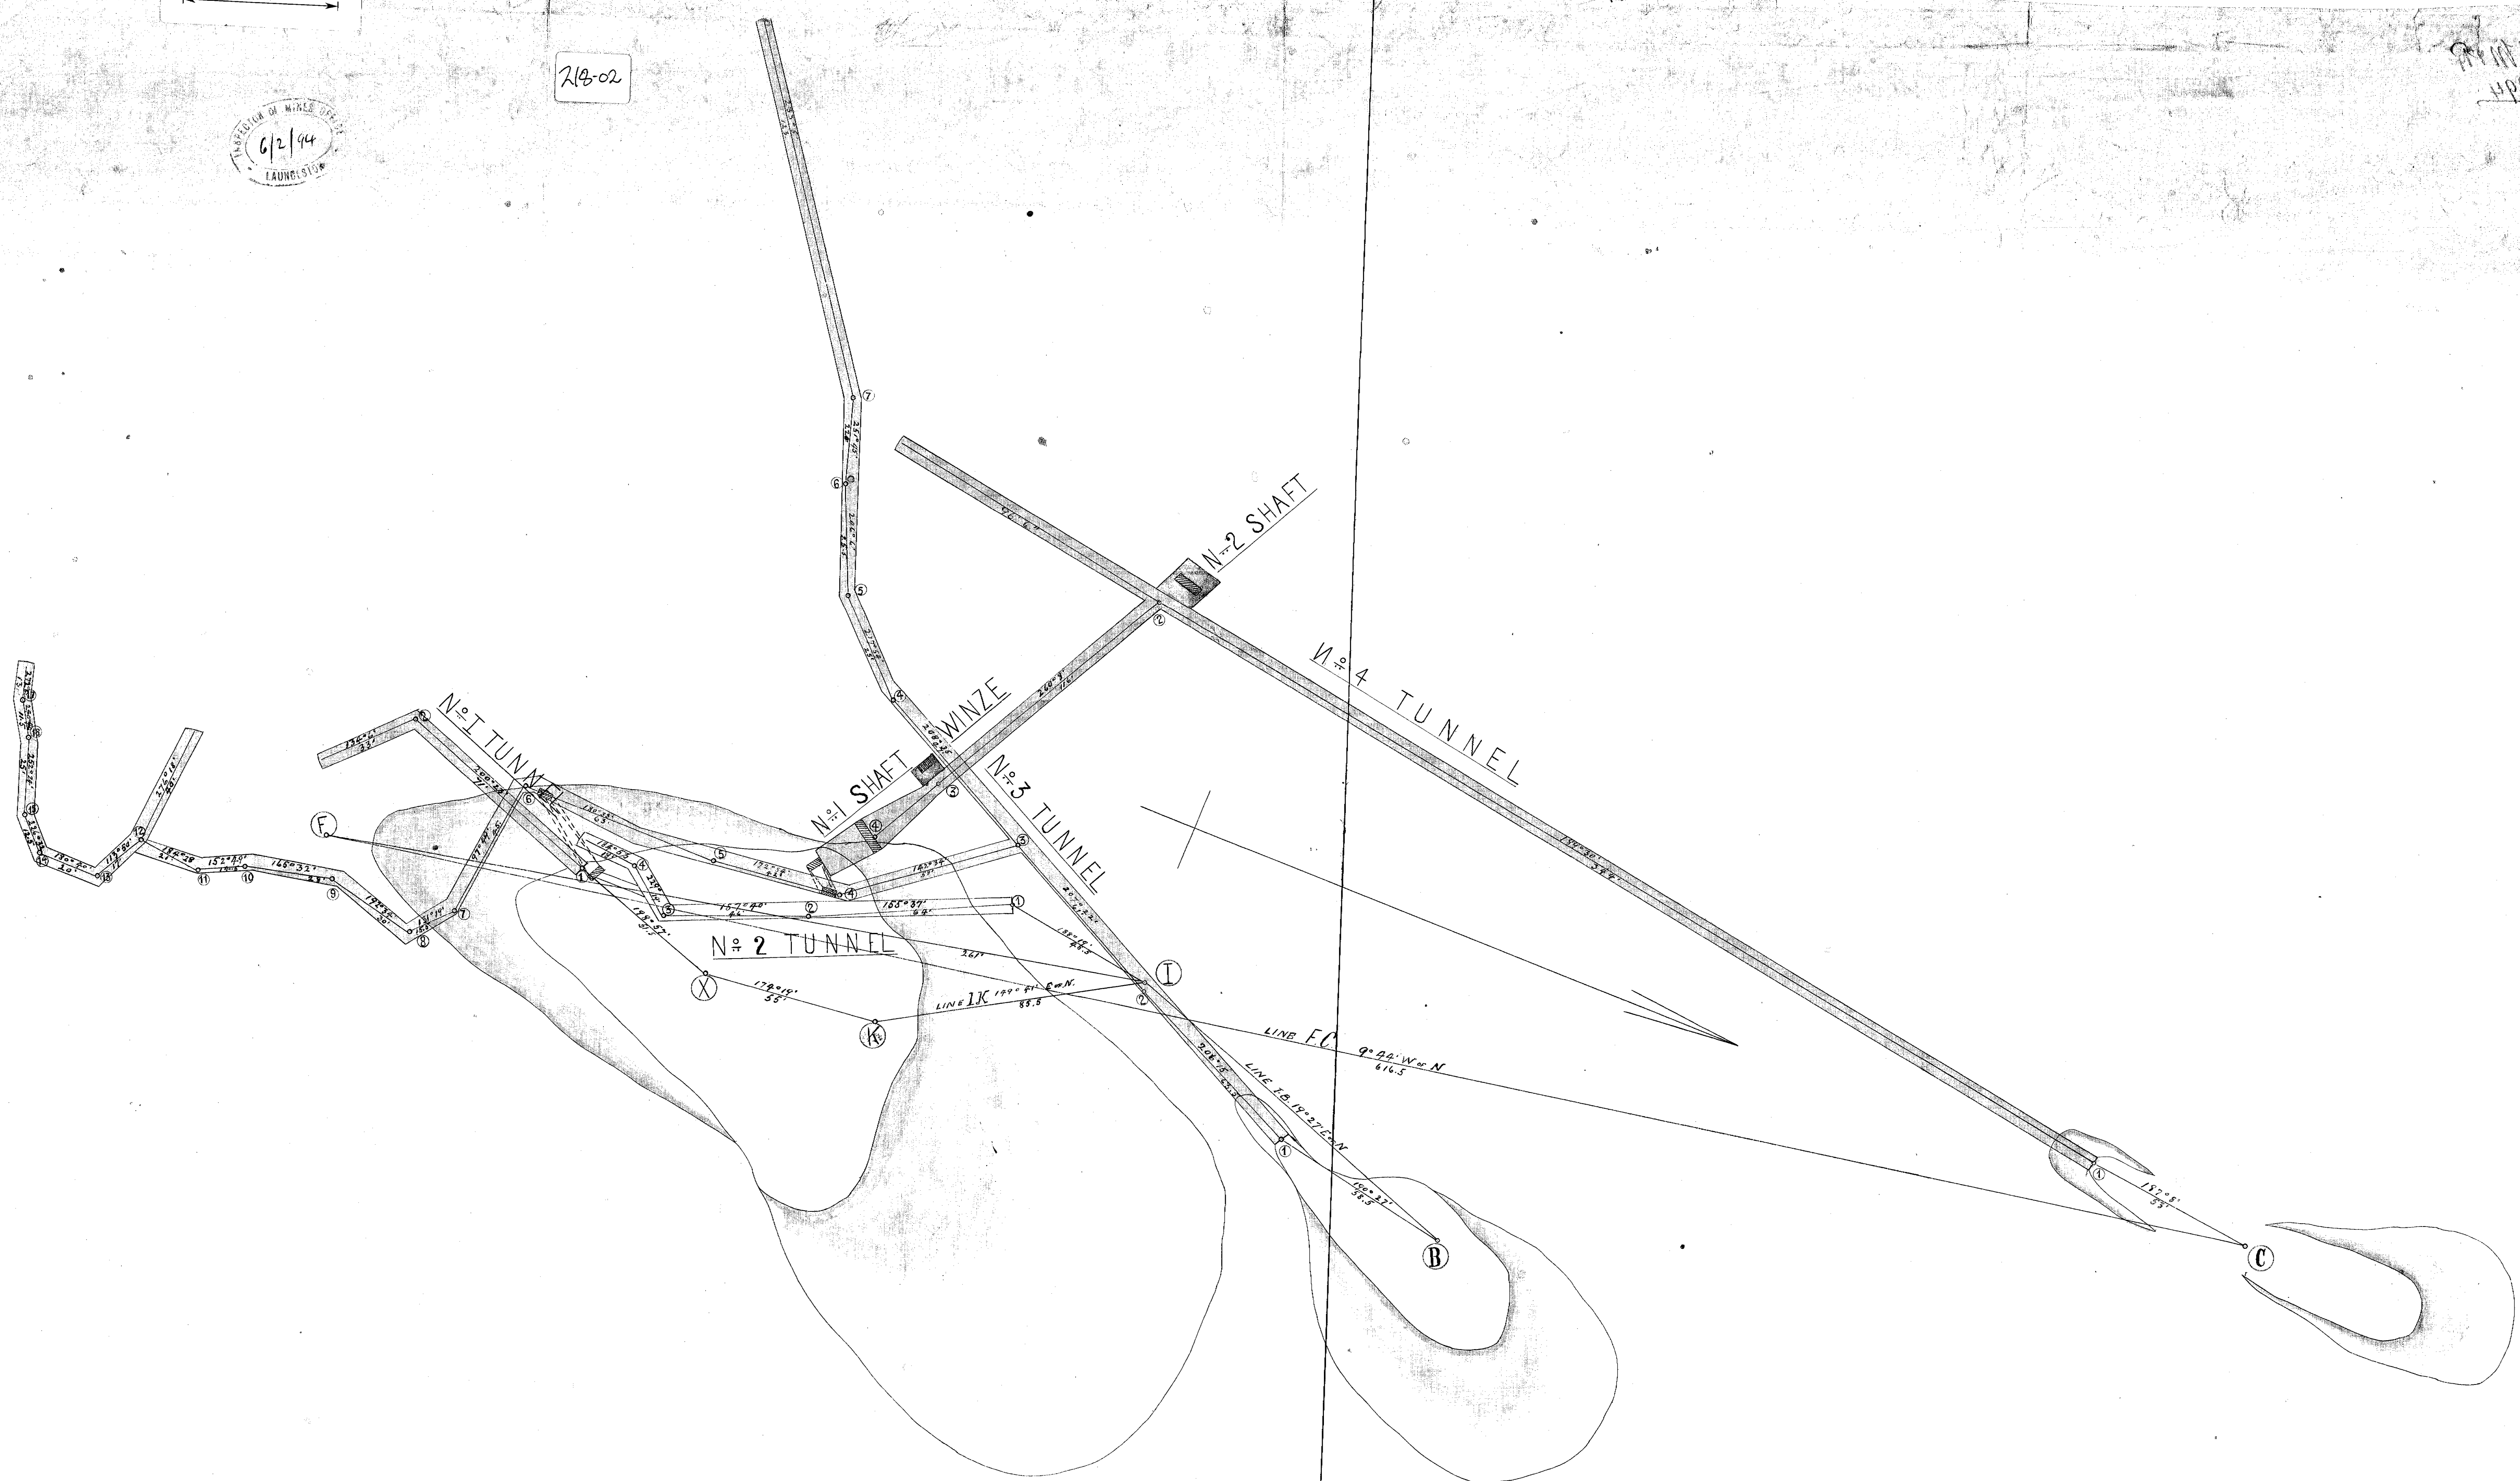

O. G. Schmitt
Supt.

14

13