


Mt Lyell M^y and Railway Co Ltd
Survey of Mine Workings

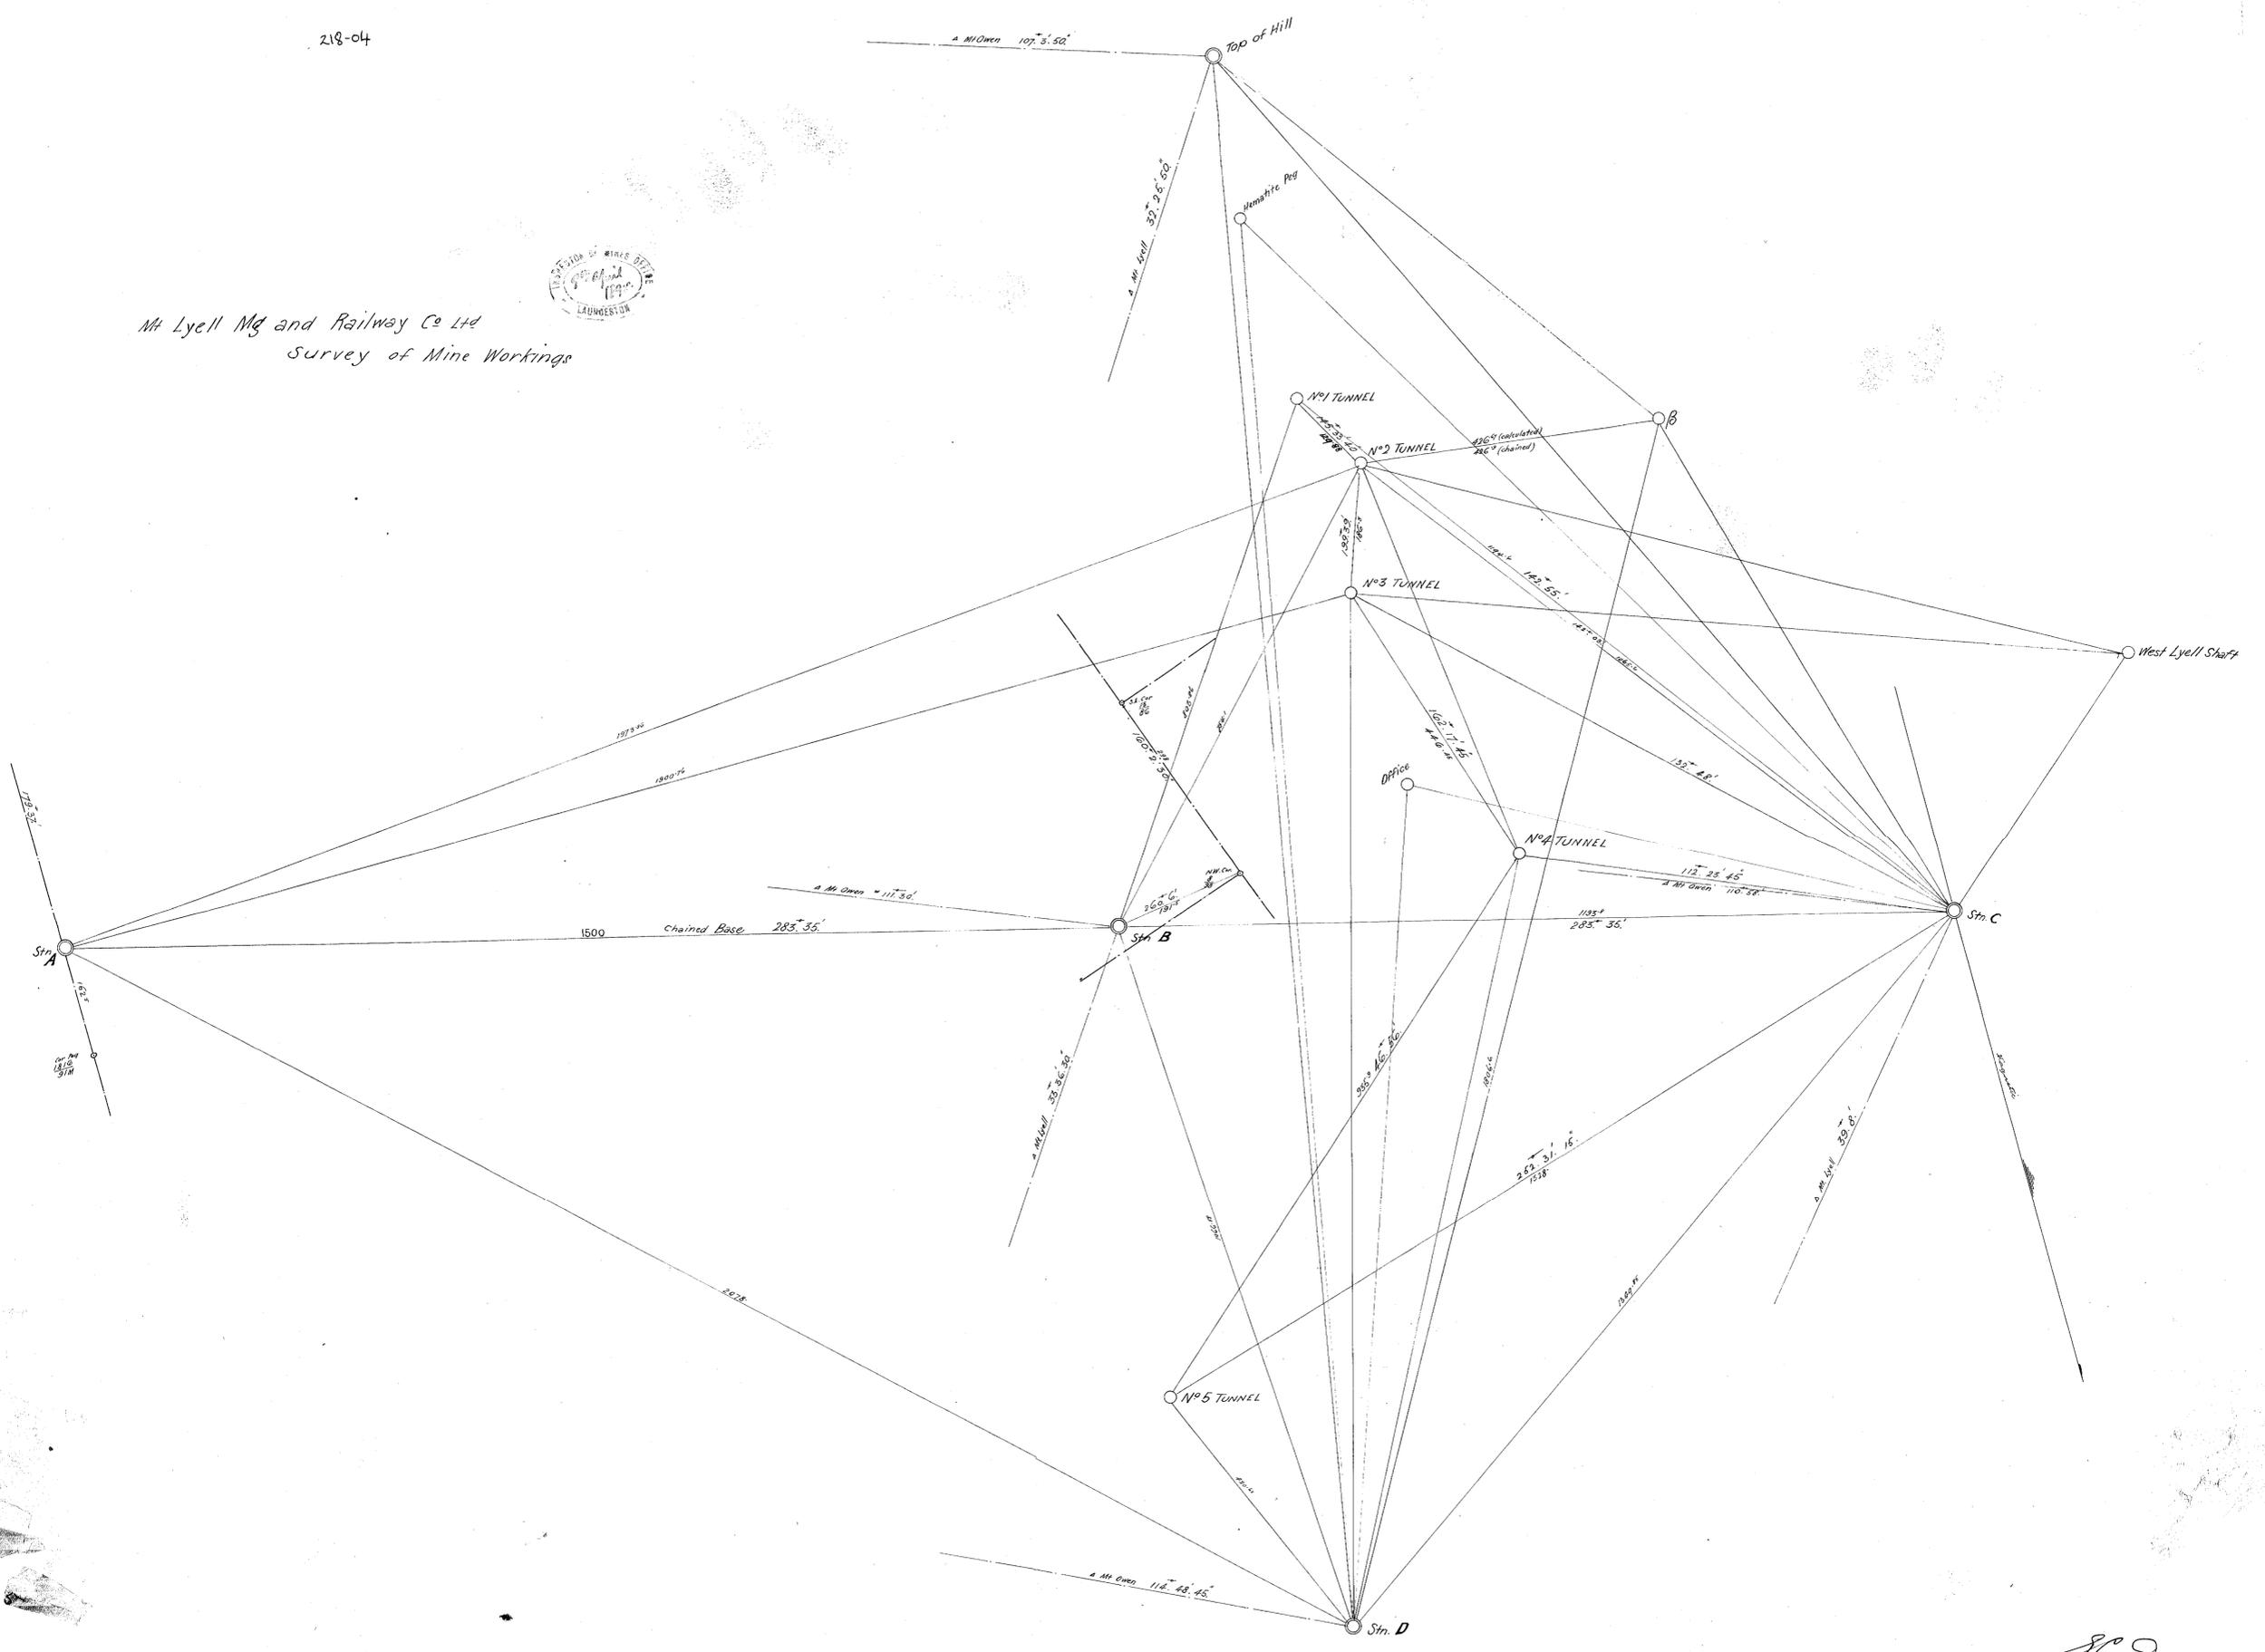

Handwritten signature