
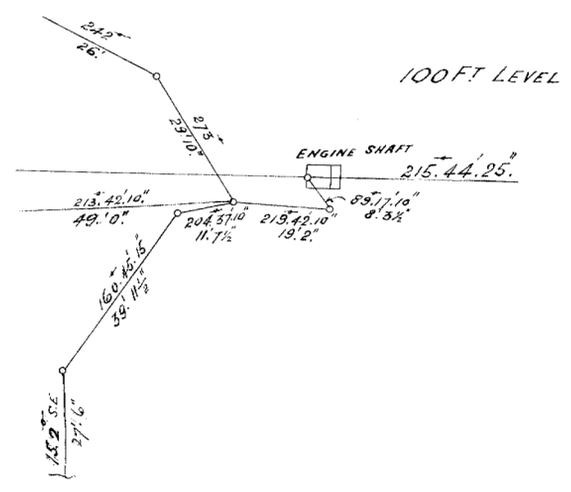
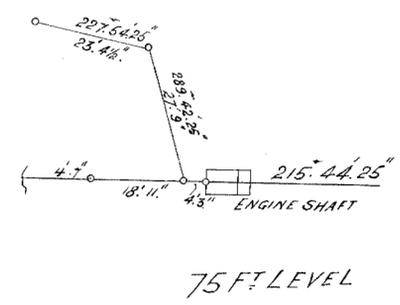


218-05

5 cm

ENGINE SHAFT WORKINGS

9th Edition
1885

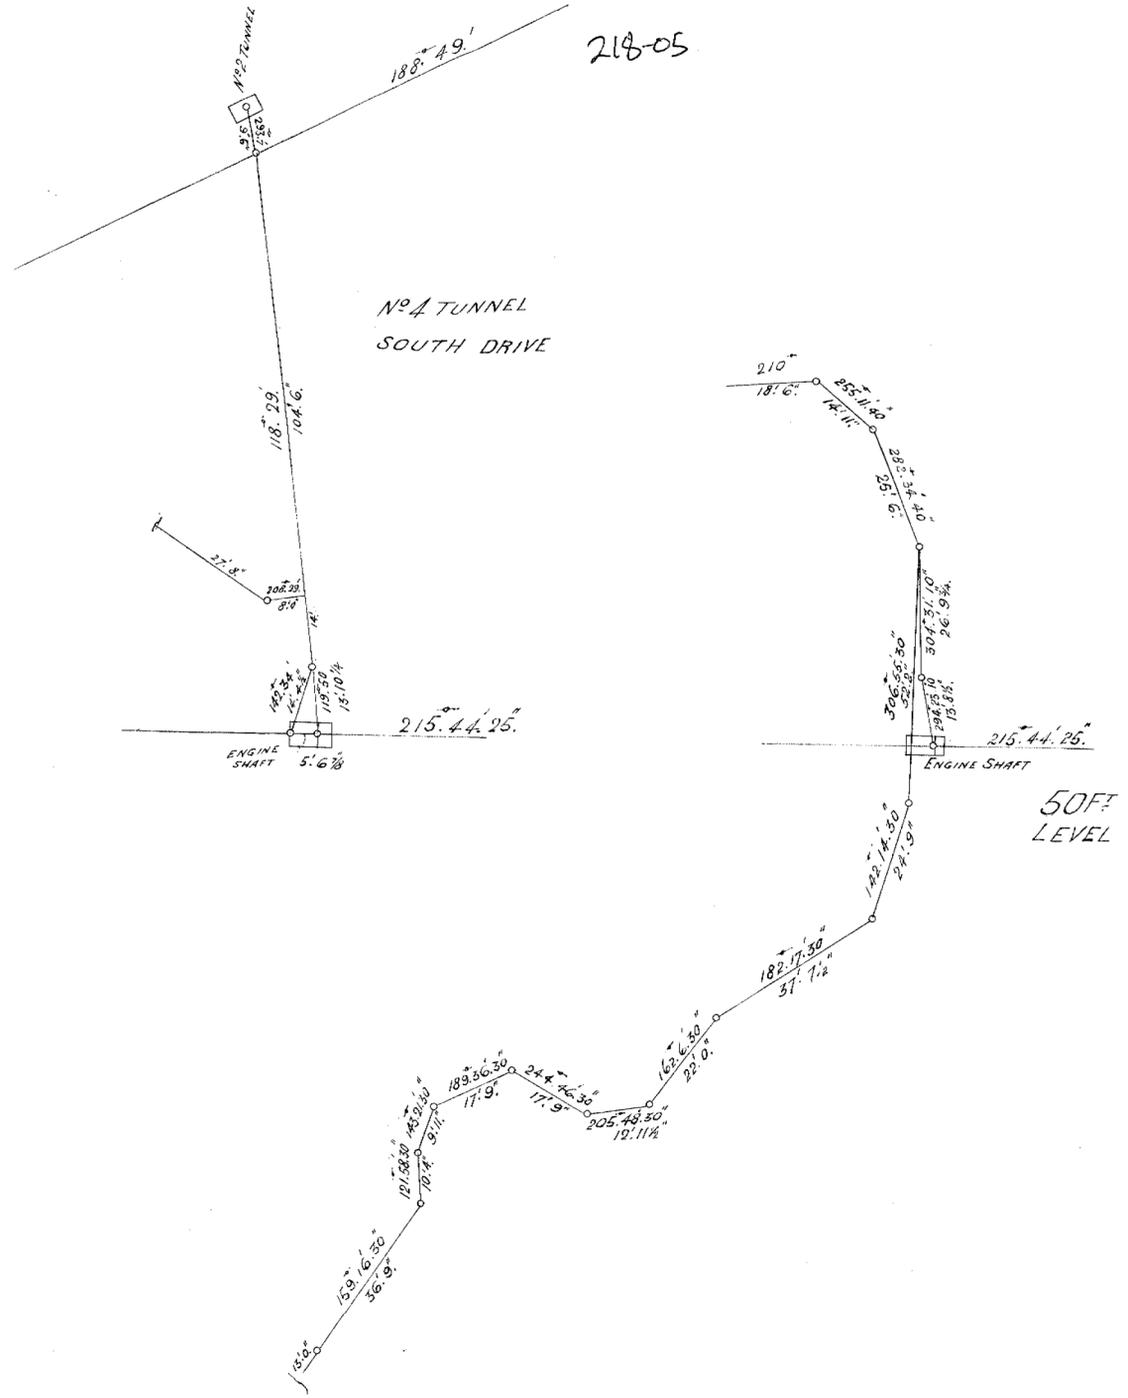

Handwritten signature and date:
1/14/19

1912