
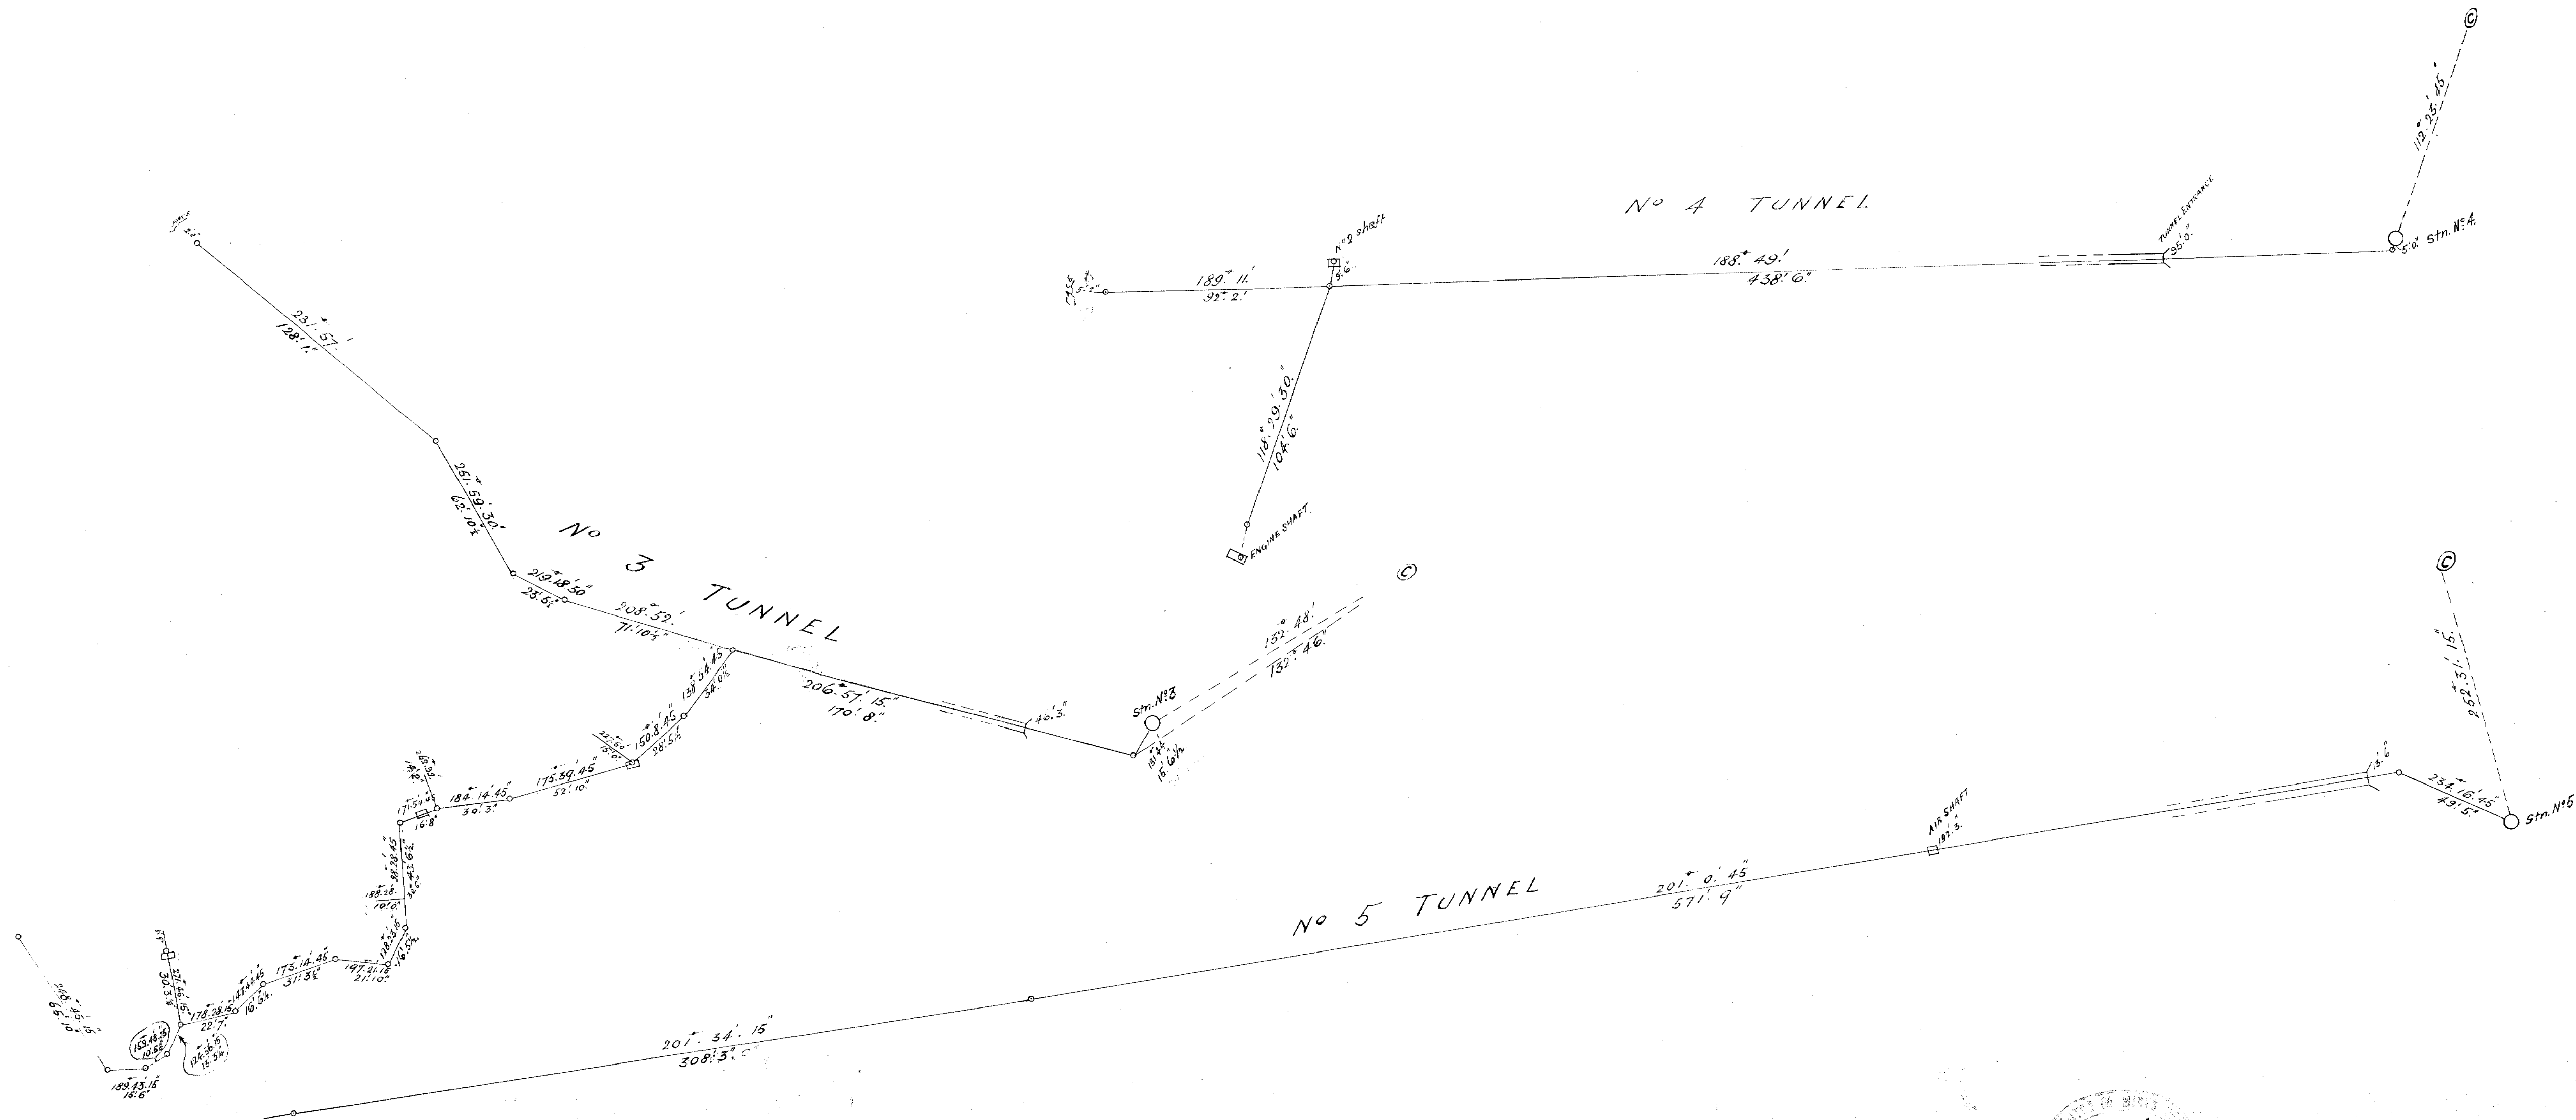


Front View of the
2981

5 cm

218-06

218-06

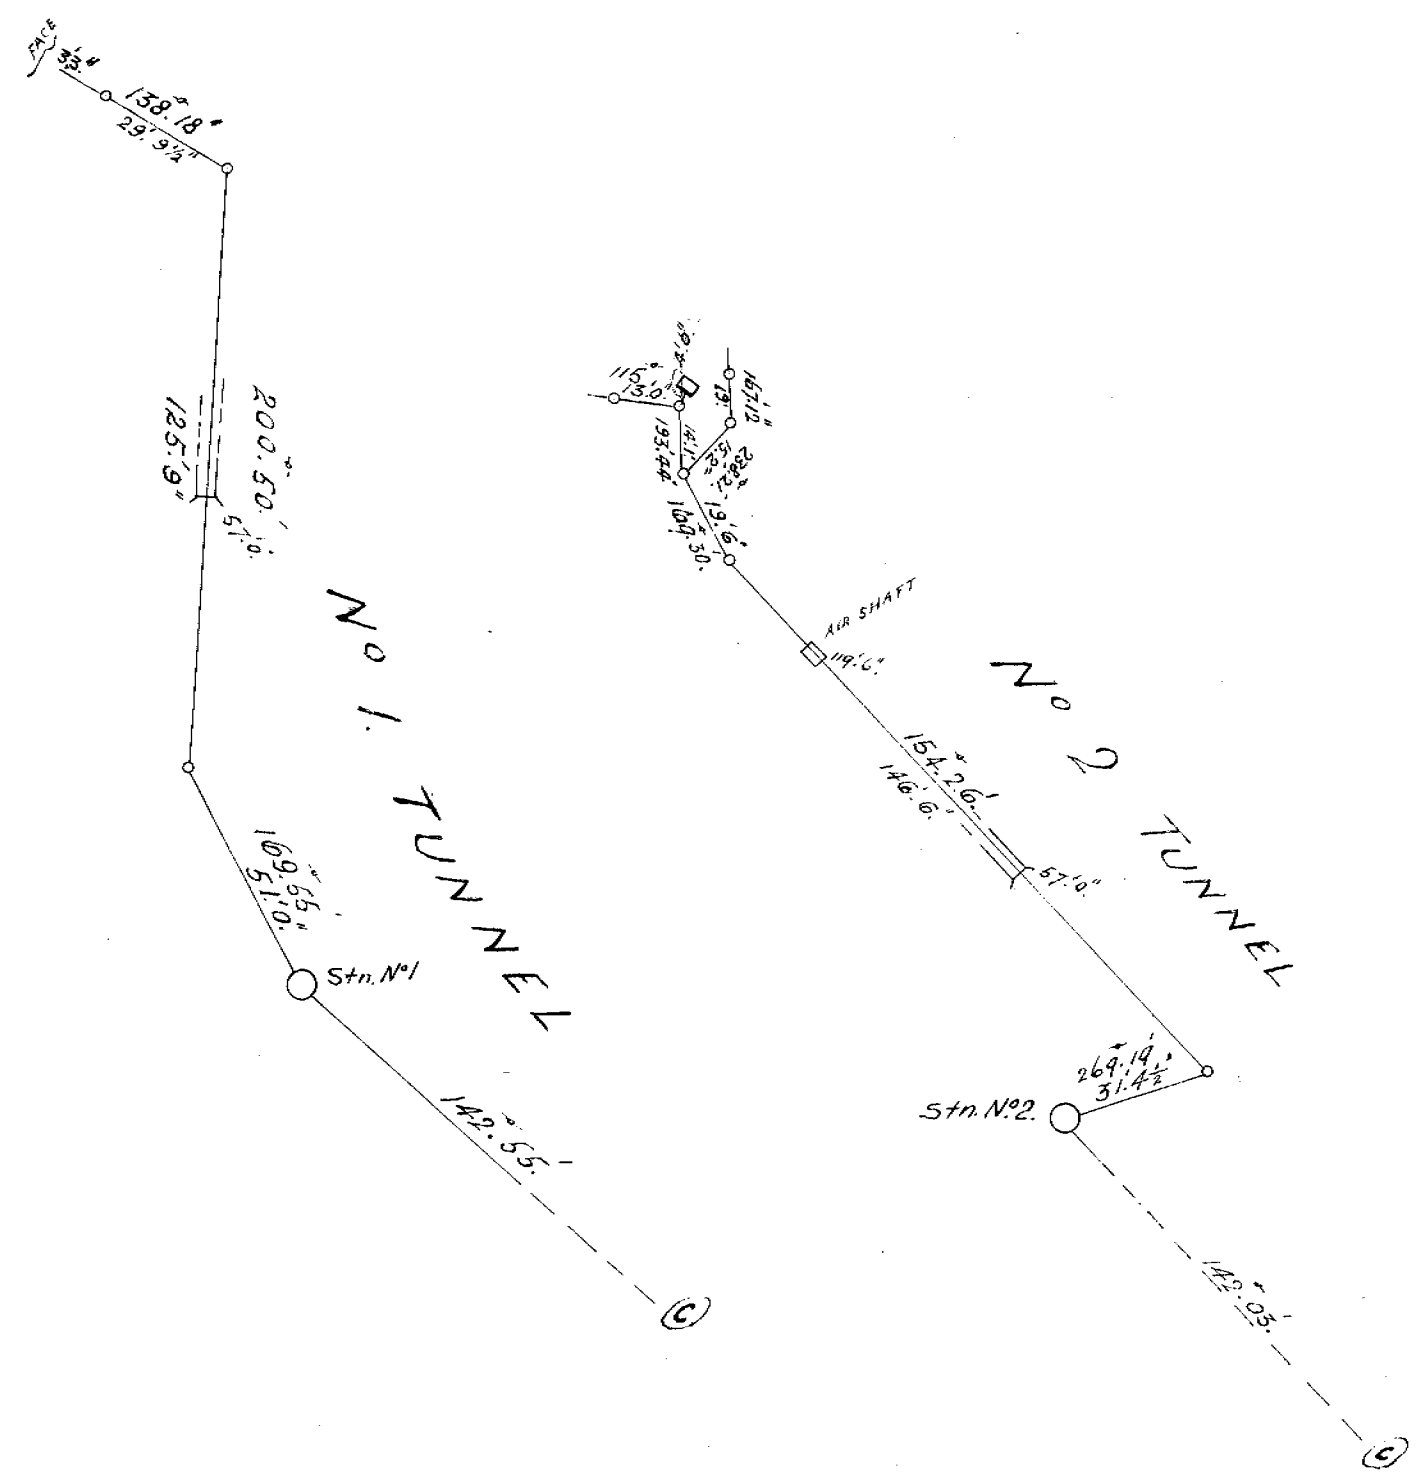

9th April
1976

Manfred
14/4/76